IREDELL COUNTY HEALTH DEPARTMENT

STATESVILLE 704-878-5305 MOORESVILLE 704-664-5281

4625901032

IMPROVEMENT PERMIT / CERTIFICATE OF COMPLETION / OPERATION PERMIT / EXISTING SYSTEM INSPECTION

PROPERTY DESCRIPTION NO. 20010 DATE 1/11/95 TAX MAP NO. 2C -2-A -11 Watershed: ☐ Yes ☑ No

OWNER OR CONTRACTOR Hopkins + Hopkins Const. Co. PHONE: Business _____ Home 875-0680

ADDRESS PO Box 682 Huntersville, NC. 28078

LOCATION Kelsh Ct. to (L) of cul-de-sac. - Brawley Sch. TL Yacht Rd. TL into Yacht Cove (R) on Kelsh Ct.

SUBDIVISION Yacht Cove BLOCK / SECTION _____ LOT 11 LOT AREA 1.5 AC. SITE CLASS. P DESIGN FLOW 360 L.T.A.R. .25

Septic Tank: 1000 Gallons; STB 794 Date 2/22/95

Pump Tank: _____ Gallons; PT _____ Date _____

Pump Make: _____ Model _____ Serial No. _____

Nitrification Field: No Fields 1 Square Feet 1440 Linear Feet 480

No Lines 4 Trench Width 36" Max Trench Bottom Depth 32" Gravel Depth 12"

☑ New System ☐ Repair System Type: I, II, III, IV, V, VI

System Description: CONV - DIST BOX

Repair System Description: CONV - DIST BOX

Maintenance Agreement Required: ☐ Yes ☑ No

☑ House/Mod. Home No. Bedrooms 3

☐ Mobile Home No. Bathrooms 2.5

☐ Business No. Employees _____

☐ Other _____

☐ Slab ☑ Crawl Space ☐ Basement w/plumbing ☐ Basement wo/plumbing


Water Supply: ☑ Individual ☐ Community ☐ Public

Comments:


Shallow - 32" MAXIMUM Trench Depth

Comments:

INITIAL SITE SKETCH:

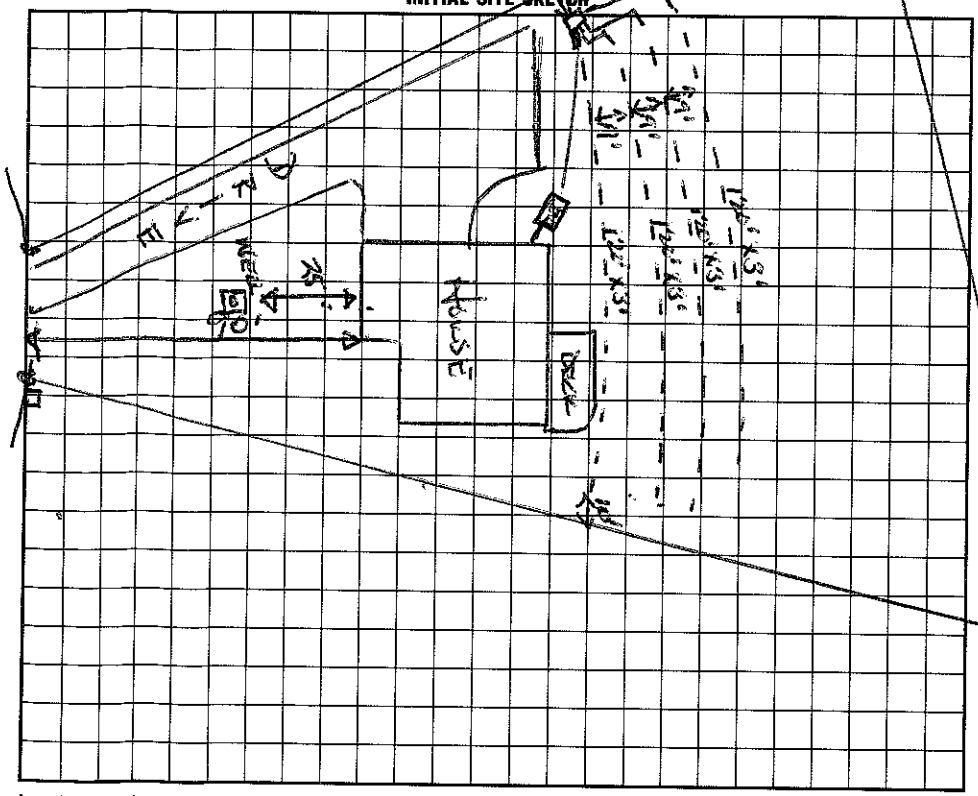

AS BUILT SKETCH

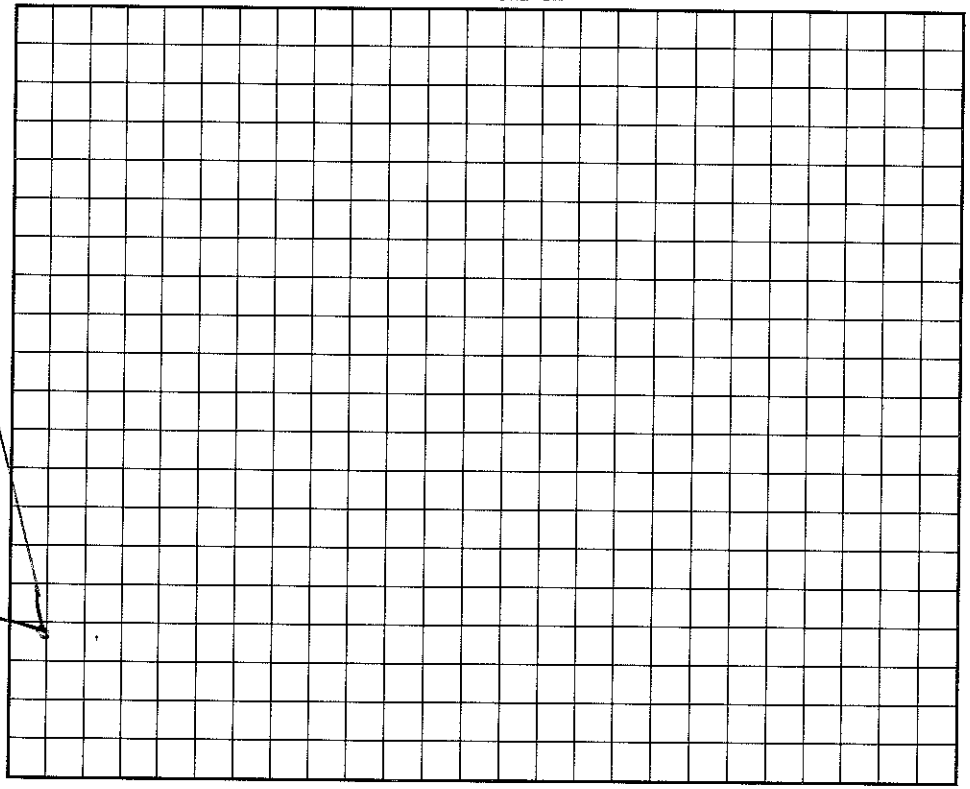

I understand that this permit can be suspended or revoked if any false information is supplied toward securing the permit/any unauthorized changes are made to the site/any unauthorized changes are made in the installation of the system. Improvement Permit is valid for 60 months from date of issuance.

Signed: _____

Improvement Permit by: Wesley Sparks R.S. date 1/11/95

Existing System Inspection by: _____ date _____

Installed by: Bob Mayhew

Certificate of Completion by: Wesley Sparks R.S. date 4/20/95

Operation Permit by: _____ date _____

HEALTH DEPT. COPY: WHITE INSPECTION COPY (FINAL): GREEN OWNER COPY (FINAL): YELLOW INSPECTION COPY (INITIAL): PINK OWNER COPY (INITIAL): GOLD