2/

IREDELL COUNTY HEALTH DEPARTMENT

↳ AUTHORIZATION TO CONSTRUCT 4625903132

STATESVILLE 704-878-5305 MOORESVILLE 704-664-5281

IMPROVEMENT PERMIT / ~~CERTIFICATE OF COMPLETION~~ / OPERATION PERMIT / EXISTING SYSTEM INSPECTION

PROPERTY DESCRIPTION NO. 24296 DATE 8/16/96 TAX MAP NO. 2C-2-A-15 Watershed: ☑ Yes ☐ No

OWNER OR CONTRACTOR BANE SHAW PHONE: Business 892-7991 (NEWMAN MCDADE) Home

ADDRESS 411 CHADMORE DR. CHARLOTTE NC 28270

LOCATION BRAWLEY SCHOOL RD - TL YACHT COVE RD - TL YACHT COVE LANE - 3rd LOT ON RT

SUBDIVISION YACHT COVE BLOCK / SECTION ____ LOT 15 LOT AREA — SITE CLASS. PS DESIGN FLOW 360 GPD L.T.A.R. ≈ .35 GPD/FT²

Septic Tank: 1000 Gallons; STB 1012 Date 2/23/96

Pump Tank: ____ Gallons; PT ____ Date ____

Pump Make: ____ Model ____ Serial No. ____

Nitrification Field: No Fields 1 Square Feet 1035 Linear Feet 345

No Lines 3 Trench Width 36" Max Trench Bottom Depth 36" Gravel Depth 12"

☑ New System ☐ Repair System Type: I, (II), III, IV, V, VI

System Description: GRAVITY CONVENTIONAL

Repair System Description: GRAVITY/PUMP PANEL

Maintenance Agreement Required: ☐ Yes ☑ No

☐ Slab ☑ Crawl Space ☐ Basement w/plumbing ☐ Basement wo/plumbing

☑ House/Mod. Home No. Bedrooms 3

☐ Mobile Home No. Bathrooms 2

☐ Business No. Employees ____

☐ Other ____

Water Supply:

☑ Individual


☐ Community

☐ Public

Comments:

Comments:

INITIAL SITE SKETCH 1" = 50'

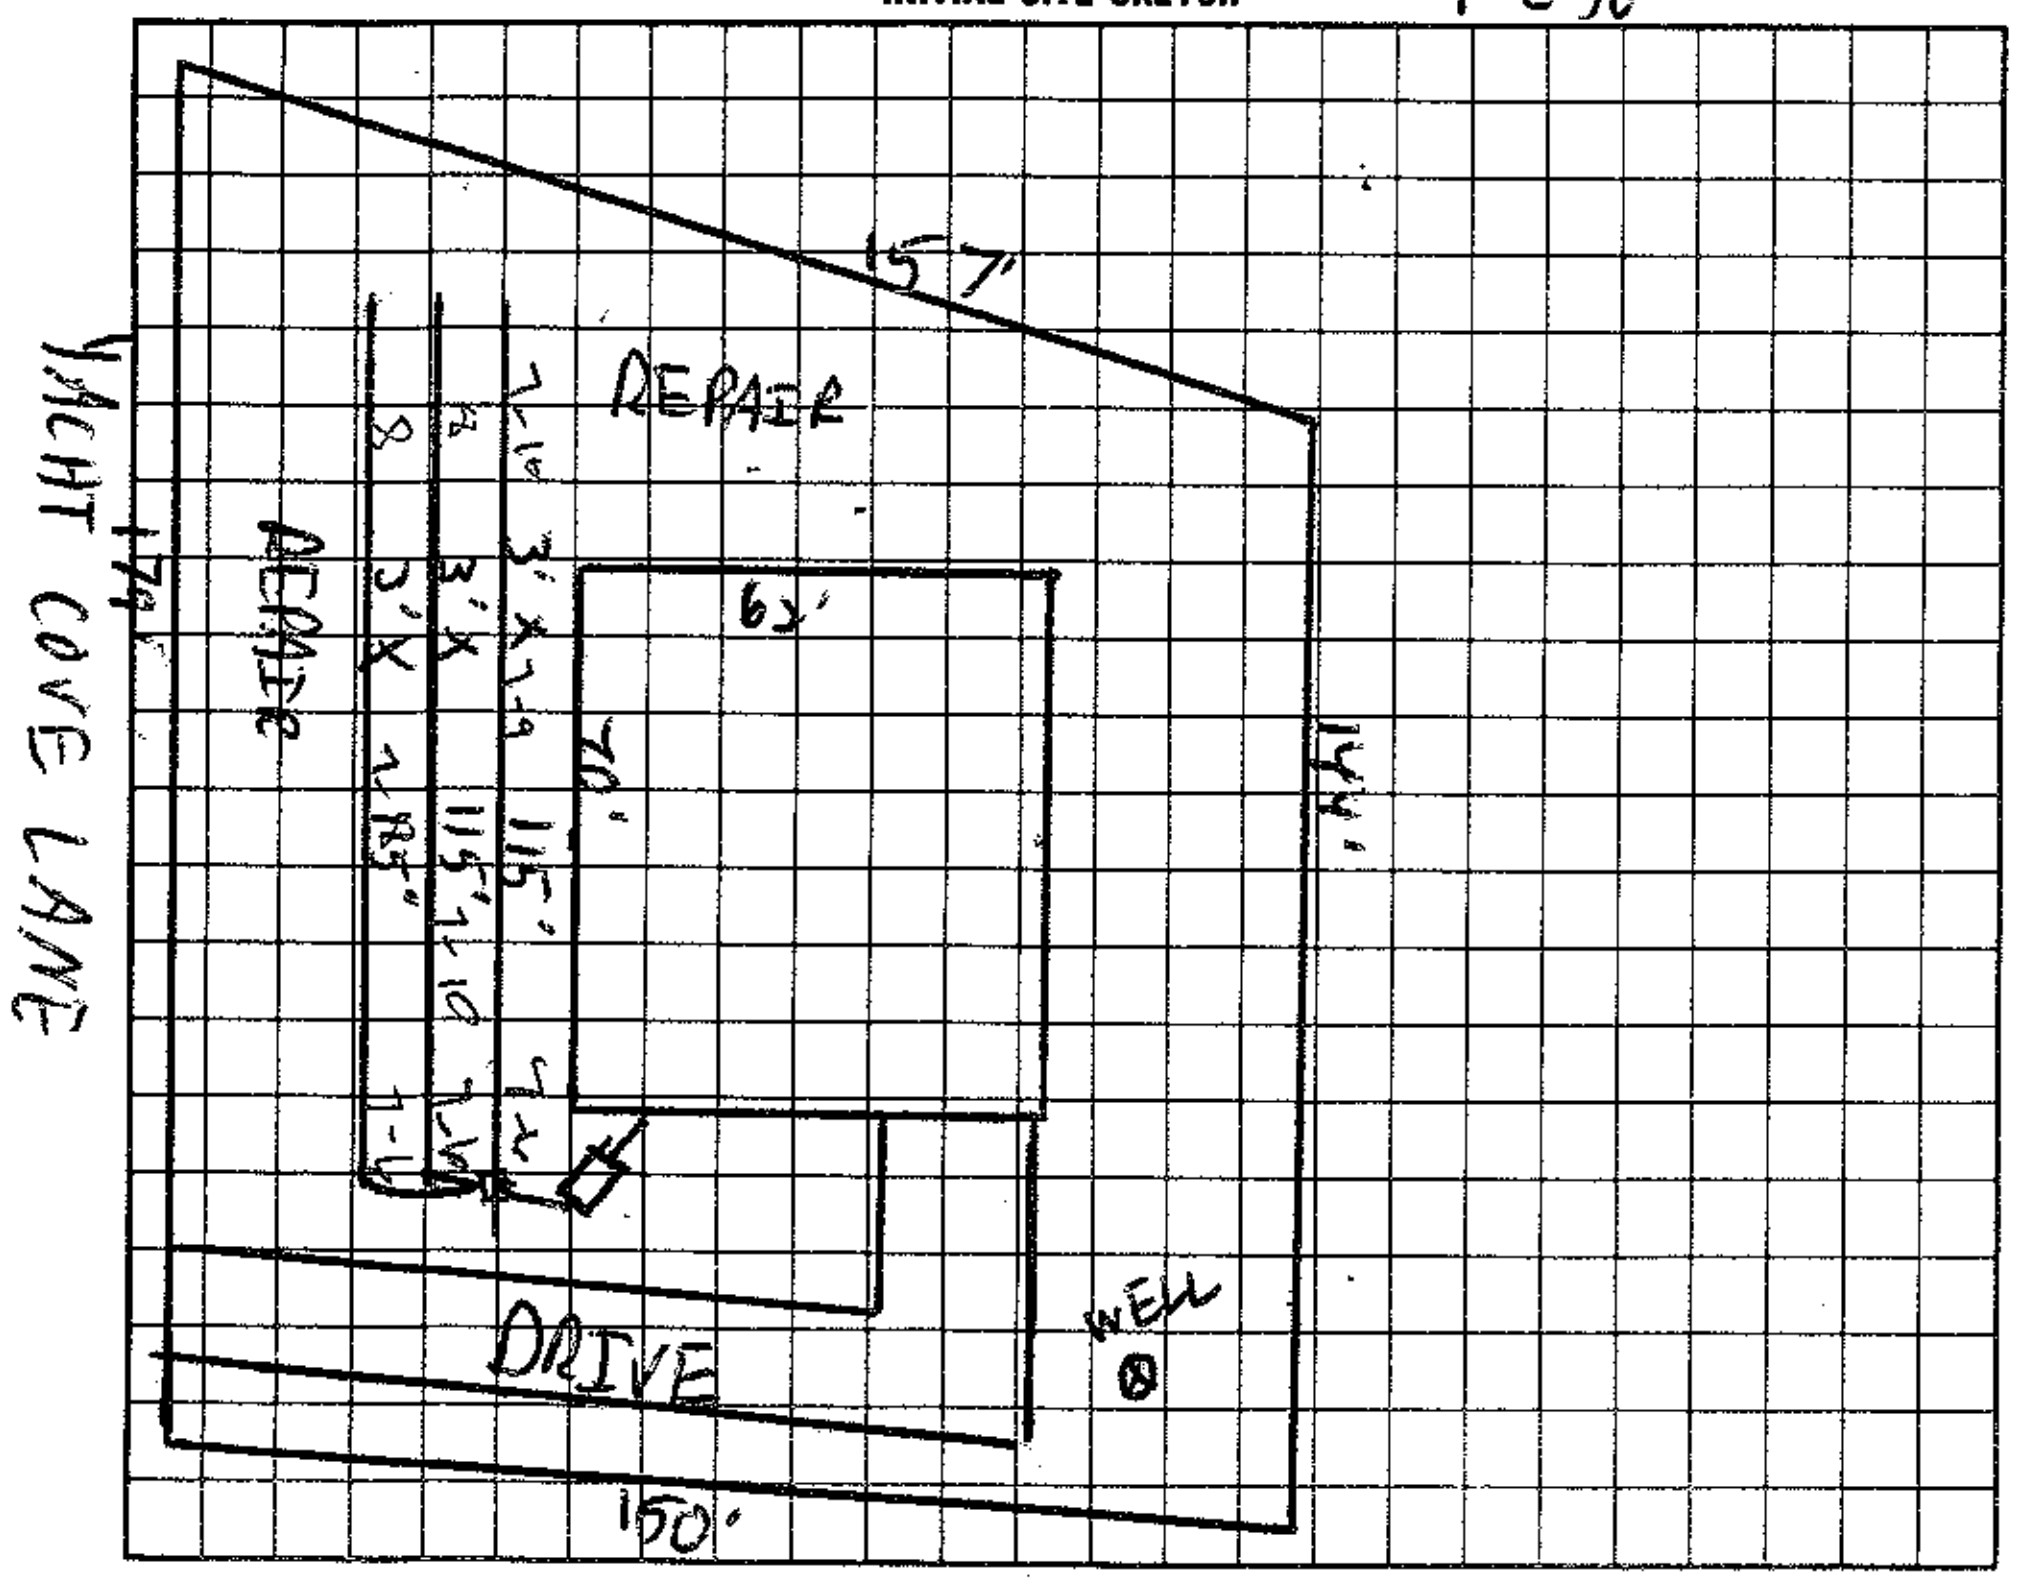

AS BUILT SKETCH

I understand that this permit can be suspended or revoked if any false information is supplied toward securing the permit/any unauthorized changes are made to the site/any unauthorized changes are made in the installation of the system.

Signed: Norman McDade

Installed by: Richard Abernathy

Improvement Permit by: C. [signature] EHS date 8/16/96

Certificate of Completion by: ____ date ____

CONSTRUCTION AUTHORIZATION ~~Existing System Inspection~~ by: C. [signature] EHSI date 8/16/96

Operation Permit by: Wesley Sparks RS date 3/18/97

HEALTH DEPT. COPY: WHITE INSPECTION COPY (FINAL): GREEN OWNER COPY (FINAL): YELLOW INSPECTION COPY (INITIAL): PINK OWNER COPY (INITIAL): GOLD