IREDELL COUNTY HEALTH DEPARTMENT

2:00

STATESVILLE 704-878-5305 ✗MOORESVILLE 704-664-5281

QM

IMPROVEMENT PERMIT / AUTHORIZATION TO CONSTRUCT / OPERATION PERMIT / EXISTING SYSTEM INSPECTION

PERMIT # 175395 PIN # 4625-90-6271 DATE 10-29-12

OWNER or APPLICANT PAUL CLAWSON PHONE: Business 203-915-8338 Home:

OWNER or APPLICANT ADDRESS 144 CHANDELEOR DR. MOORESVILLE

LOCATION / DIRECTIONS RSR, TL YACHT, TL YACHT COVE, ON L

SUBDIVISION YACHT COVE BLOCK / SECTION LOT # 18 LOT AREA .72AC DESIGN FLOW 480 GPD L.T.A.R. .3

Septic Tank 1000 Gallons: STB INFILTRATOR Date

Pump Tank 1000 Gallons: PT INFILTRATOR Date

Pump Make GOULDS Model WE512H Serial #

Nitrification Field No Fields 1 No Lines 7 Linear Feet 267'

Trench Width 24" Max. Trench Bottom Depth 36" Gravel Depth —

☒ New System ☐ Repair ☐ Expansion System Type I II III IV V VI

System Description: LP- PANEL BLOCK

Repair System Description: TS-II PANEL BLOCK

Maintenance Agreement Required ☒ YES ☐ NO

☐ GRAVITY ☒ PRESSURE

☒ Residence No. Bedrooms 4

☐ Business No. Persons

☐ Other No. Employees

☐ Slab ☒ Crawl Space

☐ Basement w/plumbing ☐ Basement w/o plumbing

Water Supply: ☒ Private ☐ Public ☐ Community

Comments / Conditions ① MUST USE DUCTILE IRON W/IN 50' OF ANY WELL


DUCTILE IRON PIPE

Comments / Conditions


LAKE LEVEL 9-6-13 97.91 2' DOWN

NEIGHBORS WELL

INITIAL SITE SKETCH

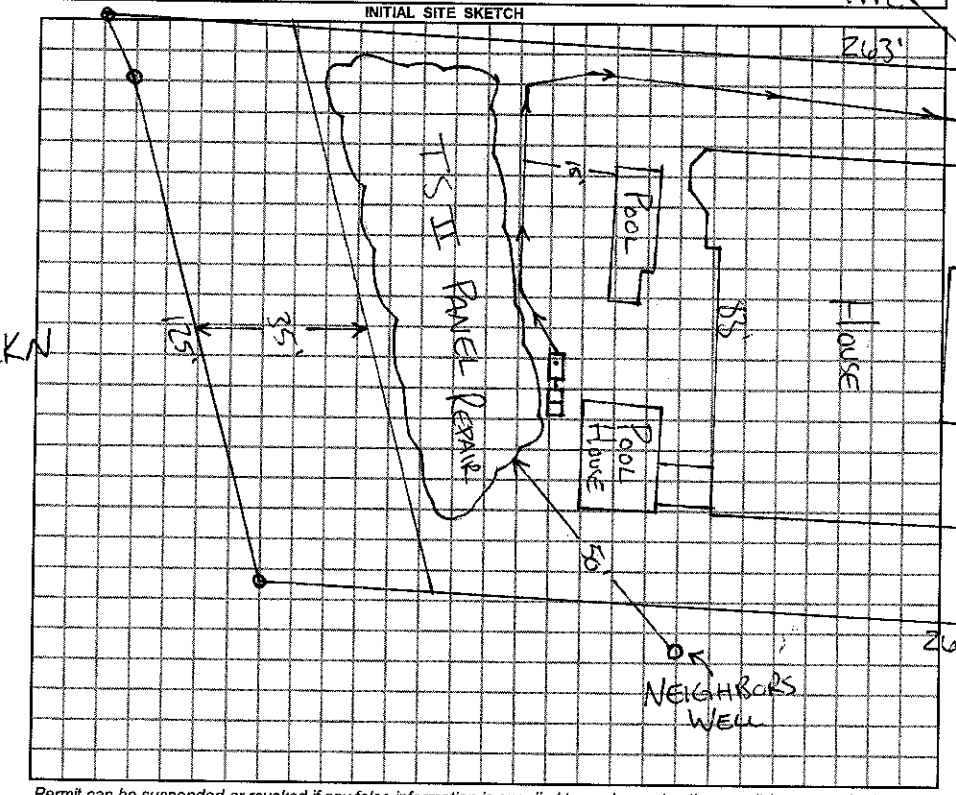

AS BUILT SKETCH

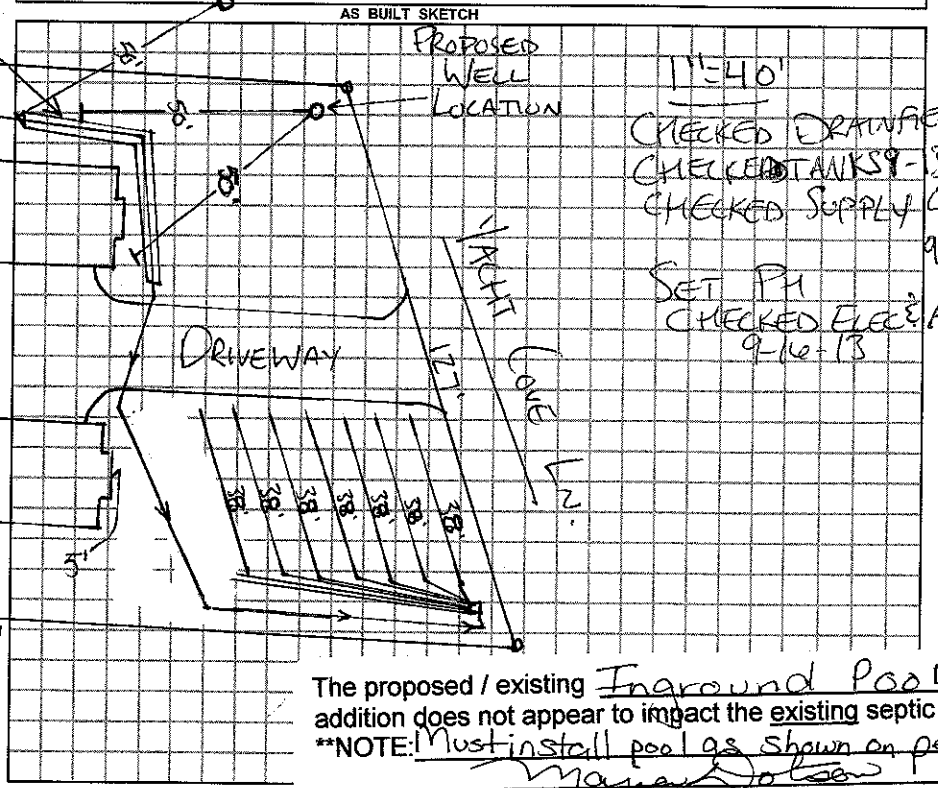

The proposed / existing Inground Pool addition does not appear to impact the existing septic system.

**NOTE: Must install pool as shown on permit

Marvin Dotson R.S.

Date: 1-14-13

ICHD-Environmental Health Division

Permit can be suspended or revoked if any false information is supplied toward securing the permit / any unauthorized changes are made to the site / any unauthorized c.

☐ IMPROVEMENT PERMIT w / plat valid without expiration. ☒ IMPROVEMENT PERMIT w / site plan valid for 60 mos. ☒ AUTHORIZATION TO CON.

Owner / Applicant Signature: 11-1-12 Date

Improvement Permit by: Date 10-30-12

Authorzation to Construct by: Date 10-30-12

YOU SHOULD CONTACT A LOCATOR SERVICE PRIOR TO ANY EXCAVATION.

Installed by: LARRY HINKLE

Operation Permit by: Date: 1-7-14

Existing System Inspected by: Date:

WHITE COPY Environmental Health YELLOW COPY (Final) Owner / Applicant PINK COPY (Initial) Owner / Applicant