IREDELL COUNTY HEALTH DEPARTMENT

STATESVILLE 704-878-5305 MOORESVILLE 704-664-5281

IMPROVEMENT PERMIT / AUTHORIZATION TO CONSTRUCT / ~~OPERATION~~ PERMIT / EXISTING SYSTEM INSPECTION

1:30 3:30

PERMIT# 120822 PIN# 4625-83-4957, 1355 4625-91-0855 DATE June 16, 04

OWNER OR CONTRACTOR Pennant Resources dba/ The Pointe Avenue PHONE: Business Home

ADDRESS 2214 B Brawley School Rd. Mooresville N.C. 28117

LOCATION Brawley School Rd. TL Yeatt Rd. TL Milford Circle TR Milford Circle on left

SUBDIVISION The Point BLOCK / SECTION 13 LOT 1355 LOT AREA .861 Ac SITE CLASS. PS DESIGN FLOW 480 gpd L.T.A.R. .25

Septic Tank: 1050 Gallons; STB 3790 Date 3-2-08

Pump Tank: 1000 Gallons; PT 3683 Date 4-2-08

Pump Make: Myers Model ME503-21 Serial No.

Nitrification Field: No Fields 1 Square Feet 1500 Linear Feet 500

No Lines 5@100' Trench Width 36" Max Trench Bottom Depth 36" Gravel Depth N/A

☒ New System ☐ Repair System Type: I, II, III, IV, V

System Description: Qm 25 Sep Rotomax

Repair System Description: LPPBPS

Maintenance Agreement Required: ☐ Yes ☒ No

☒ House/Mod. Home No. Bedrooms 4

☐ Mobile Home No. Bathrooms 4

☐ Business No. Employees

☐ Other


☐ Slab ☒ Crawl Space ☐ Basement w/plumbing ☐ Basement w/o plumbing

Water Supply: ☐ Individual ☒ Public ☒ Community

Comments/Conditions:

Comments/Conditions: Only checked the top 3 drain lines on 5-2-08 LS - ADD 25 Quik 4 per ditch 1500 gal 5' Installed

INITIAL SITE SKETCH

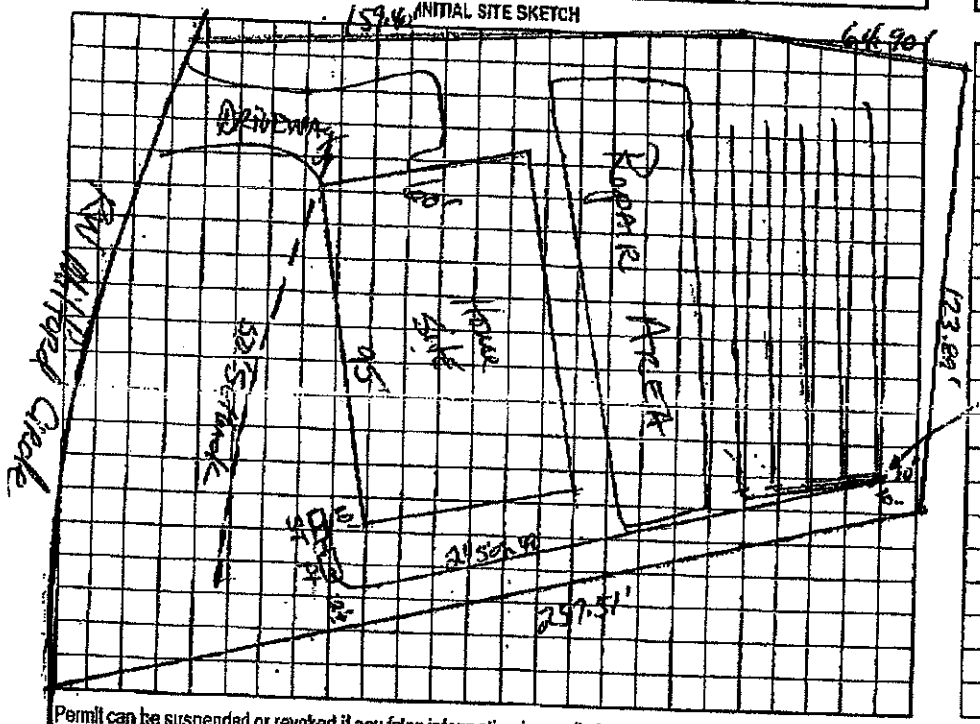

AS BUILT SKETCH

	Date	Initials
Drain Lines Checked	5-5-08	BA
Tanks Checked	5-5-08	BA
Pressure Manifold or Valve Box Checked	5-5-08	BA
Pressure Head Set	5-5-08	BA
Electrical Checked	5-5-08	BA
Floats Set	5508	BA
Alarm Checked	5508	BA
Maintenance Contract Y (N)		

Permit can be suspended or revoked if any false information is supplied toward securing the permit/any unauthorized changes are made to the site/any unauthorized changes are made in the installation of the system. Improvement Permit with plat valid without expiration. Improvement Permit with site plan valid for sixty months. Authorization to Construct is valid for a period equal to that of Improvement Permit – not to exceed sixty months.

Signed:

Improvement Permit by: date 5-22-04

Authorization to Construct by: date 6-16-04

date 6/4/07

Installed by: Stanley Septic

Operation Permit by: date 5-5-08

Existing System Inspection by: date

HEALTH DEPT. COPY: WHITE OWNER COPY (FINAL): YELLOW OWNER COPY (INITIAL): PINK

07/28/2010 14:36 7046523239 PAGE 02