Sec 130 11'00

IREDELL COUNTY HEALTH DEPARTMENT

STATESVILLE 704-878-5305 MOORESVILLE 704-664-5281

IMPROVEMENT PERMIT / AUTHORIZATION TO CONSTRUCT / OPERATION PERMIT / EXISTING SYSTEM INSPECTION

PERMIT# 120825 PIN# 4625-83-4957.1357 4625 91 1568 DATE June 16, 04

OWNER OR CONTRACTOR Crescent Resources Dev. / The Point or Norman Hughes; Home PHONE Business Zande Home

ADDRESS 2214 Brawley School Rd, Mooresville, N.C. 28117

LOCATION Brawley School Rd. TL Yacht Rd. TL Milford Circle TR Milford Circle on left

SUBDIVISION The Point BLOCK / SECTION 13 LOT 1357 LOT AREA .843 Ac SITE CLASS PS DESIGN FLOW 480gpd L.T.A.R. .3

Septic Tank: 1000+ Gallons; STB 338 Date 10-30-04
Pump Tank: 1000 Gallons; PT 27 Date 12-5-04
Pump Make: Goulds Model WE0512HH2 Serial No. 4-16-04
Nitrification Field: No Fields 1 Square Feet 1200 Linear Feet 400
No Lines * 5 taps off pm Trench Width 36" Max Trench Bottom Depth 36" Gravel Depth N/A

☑ New System ☐ Repair System Type: I, II, III, IV, V, VI
System Description: pm 25% Reduction
Repair System Description: LP PPBPS
Maintenance Agreement Required: ☐ Yes ☑ No initially


☑ House/Mod. Home No. Bedrooms 4
☐ Mobile Home No. Bathrooms 4
☐ Business No. Employees
☐ Other
☐ Slab ☑ Crawl Space ☐ Basement w/plumbing ☐ Basement wo/plumbing

Water Supply: ☐ Individual ☑ Public ☑ Community


Comments/Conditions: * Upper tap from pm to go to flow divider and split to 2 lines @ 40' each.

Comments/Conditions: Reviewed Building plans & site plan, essentially in Compliance with Improvement Permit. 8/25/04 MD

1"=50' INITIAL SITE SKETCH

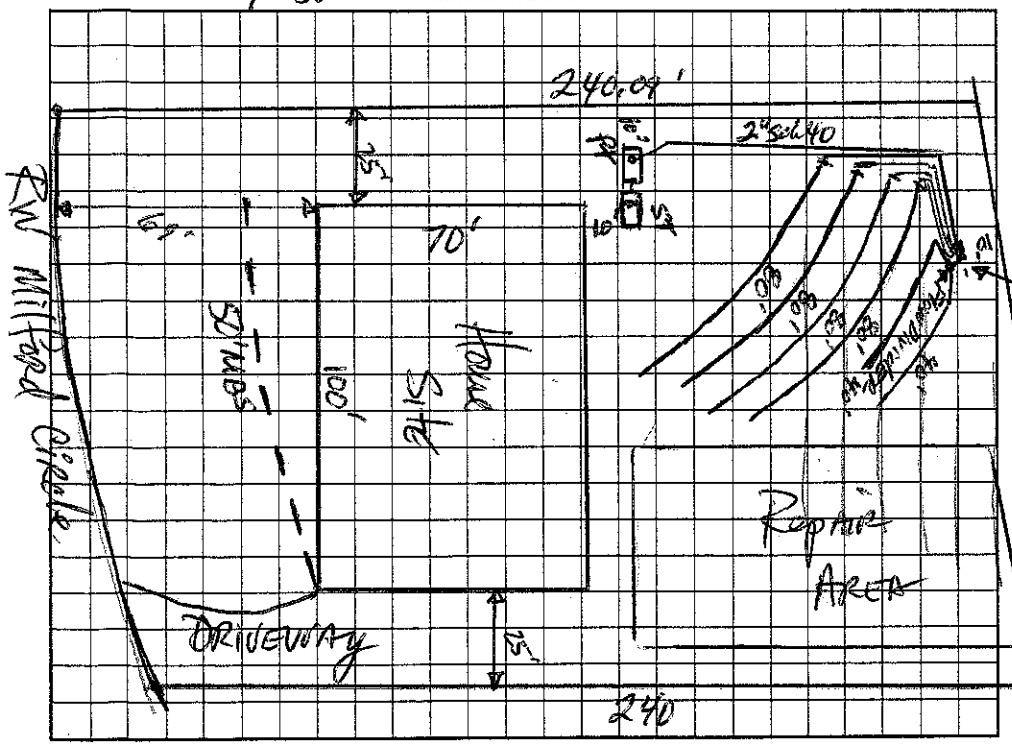

AS BUILT SKETCH

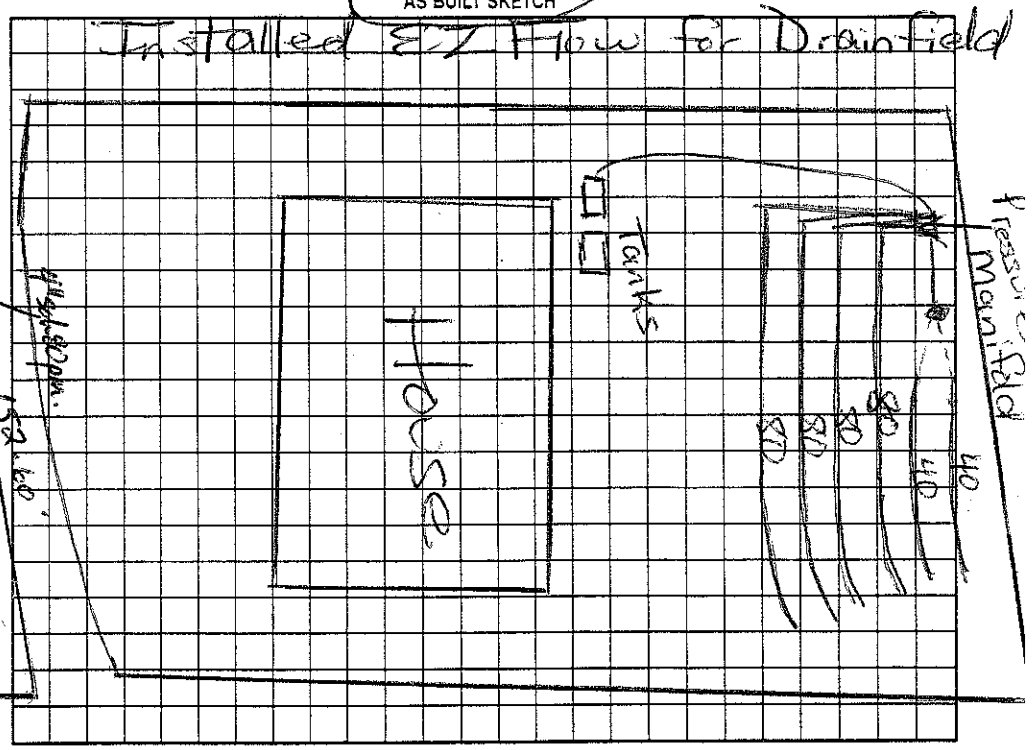

Permit can be suspended or revoked if any false information is supplied toward securing the permit/any unauthorized changes are made to the site/any unauthorized changes are made in the installation of the system. Improvement Permit with plat valid without expiration. Improvement Permit with site plan valid for sixty months. Authorization to Construct is valid for a period equal to that of Improvement Permit – not to exceed sixty months.

Signed: [signature] date 6-22-04 Installed by: Bobby Mayhew RS

Improvement Permit by: [signature] date 6-18-04 Operation Permit by: [signature] date 3/18/05

Authorization to Construct by: [signature] date 8/25/04 Existing System Inspection by: date

HEALTH DEPT. COPY: WHITE OWNER COPY (FINAL): YELLOW OWNER COPY (INITIAL): PINK