$450

IREDELL COUNTY HEALTH DEPARTMENT

STATESVILLE 704-878-5305 MOORESVILLE 704-664-5281

IMPROVEMENT PERMIT / AUTHORIZATION TO CONSTRUCT / OPERATION PERMIT / EXISTING SYSTEM INSPECTION

PERMIT# 118931 PIN# ~~4625-83-4957.1321~~ 4625-91-2241 DATE 7/27/06

OWNER OR APPLICANT David Dibble Custom Homes PHONE: Business 704-799-1688 Home

ADDRESS 10602 Baily Rd. Ste A Cornelius, NC. 28031

LOCATION 1100 TL Yacht Rd. TL Milford Circle TR Milford Circle on (R)

SUBDIVISION Point BLOCK / SECTION 13 LOT 1321 LOT AREA 2.90 AC SITE CLASS. PS DESIGN FLOW 600 L.T.A.R. .3

Septic Tank: 1500 Gallons; STB 338 Date 1/30/07

Pump Tank: 1500 Gallons; PT 477 Date 2/19/07

Pump Make: Goulds Model WE0-712 HT Serial No.

Nitrification Field: No Fields 1 Square Feet 999 Linear Feet 335

No Lines 3@111' Trench Width 3' Max Trench Bottom Depth 3'

☒ New System ☐ Repair ☐ Expansion System Type: I II III (IV) V VI

System Description: LP - PPBPS 16"

Repair System Description: LP - PPBPS 16"

Maintenance Agreement Required: ☒ Yes ☐ No

Gravel Depth No ☐ Gravity ☒ Pressure ☐ Slab ☐ Crawl Space ☒ Basement w/plumbing ☐ Basement wo/plumbing

☒ House/Mod. Home ☐ Mobile Home ☐ Business ☐ Other

No. Bedrooms 5 No. Persons 4.5 No. Employees


Water Supply: ☐ Individual ☐ Public ☒ Community Point

Comments:/Conditions: ALL UTILITIES TO RUN PARALLEL TO LEFT SIDE PROPERTY LINE.

Comments:/Conditions: Tanks, Filter 5/22/07

(1" = 50')

INITIAL SITE SKETCH

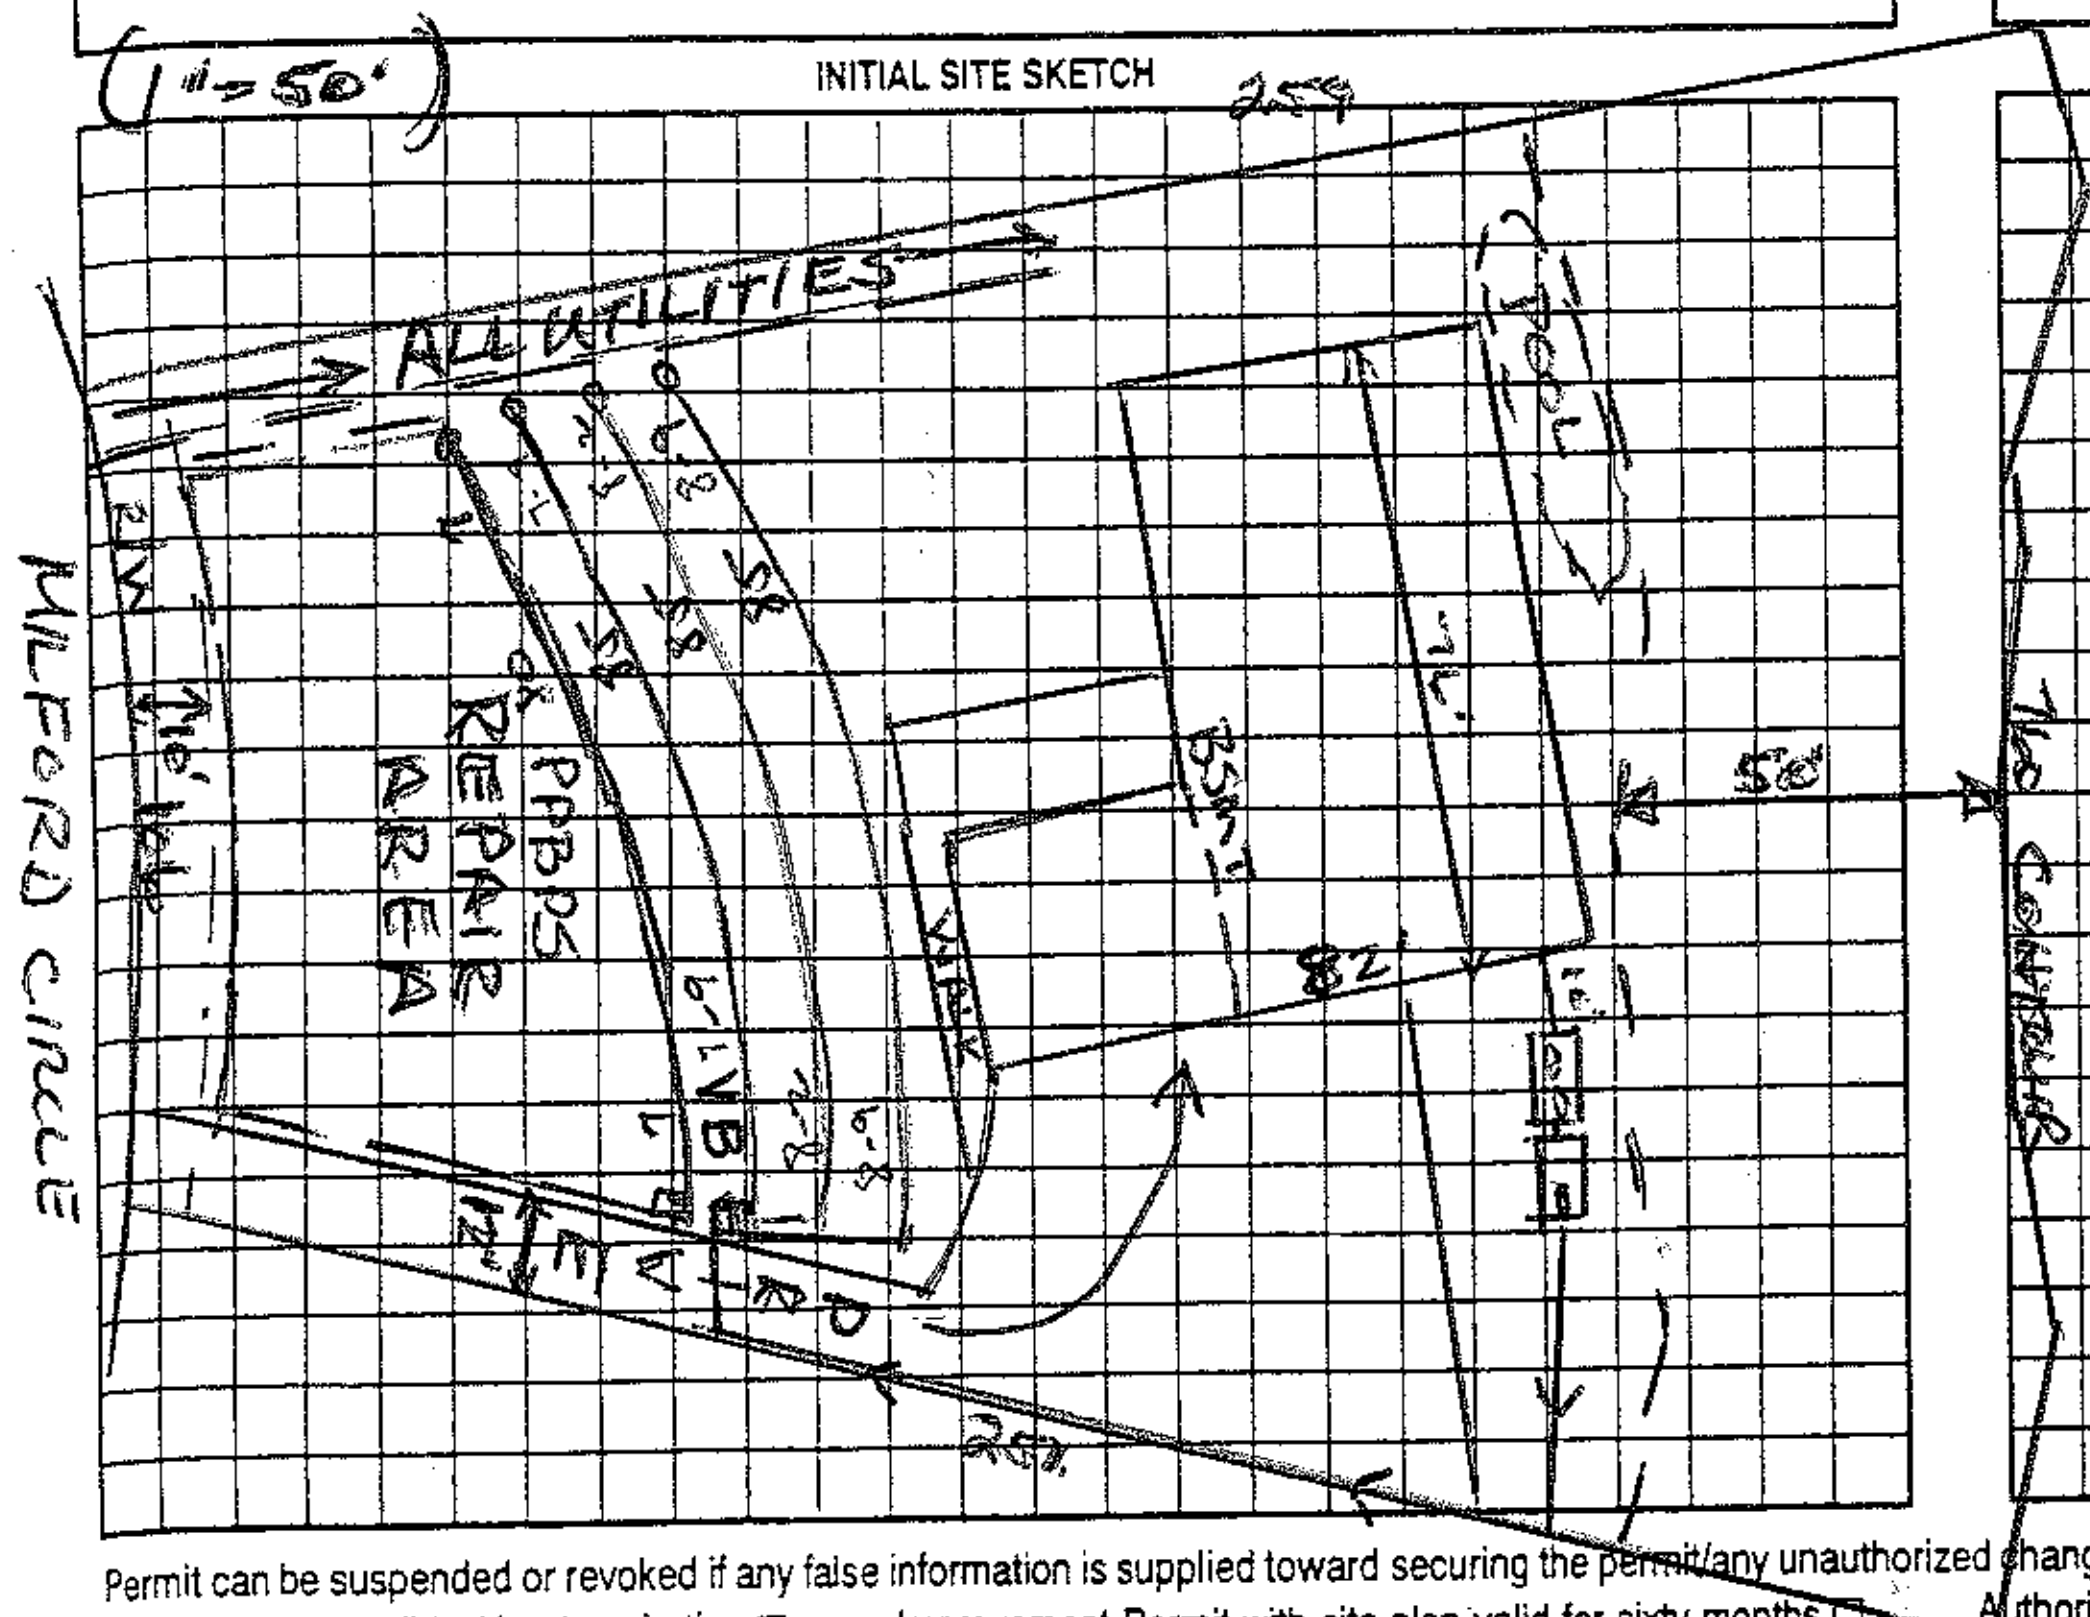

AS BUILT SKETCH

Permit can be suspended or revoked if any false information is supplied toward securing the permit/any unauthorized changes are made to the site/any unauthorized changes are made in the installation of the system. Improvement Permit with plat valid without expiration. ☐ Improvement Permit with site plan valid for sixty months ☐ Authorization to Construct is valid for a period equal to that of Improvement Permit – not to exceed sixty months.

Signed: * Crystal Dibble date 8/10/06

Improvement Permit by: Wesley Sparks R.S. date 7/27/06

Authorization to Construct by: Wesley Sparks R.S. date 7/27/06

Installed by: Orbison + Sons

Operation Permit by: Wesley Sparks R.S. date 7/6/07

Existing System Inspection by: date

HEALTH DEPT. COPY: WHITE OWNER COPY (FINAL): YELLOW OWNER COPY (INITIAL): PINK