IREDELL COUNTY HEALTH DEPARTMENT

STATESVILLE 704-878-5305 MOORESVILLE 704-664-5281

IMPROVEMENT PERMIT / AUTHORIZATION TO CONSTRUCT / OPERATION PERMIT / EXISTING SYSTEM INSPECTION

PERMIT# 118932 PIN# 4625834959 4625-91-3293 DATE 5/11/06

OWNER OR APPLICANT John R. Poore PHONE: Business Home

ADDRESS 10590 Independence Pt. Parkway Matthews, NC 28105

LOCATION Brawley School Rd TL Yacht Rd TL Milford Circle TR Milford Circle on right

SUBDIVISION The Point BLOCK / SECTION 13 LOT 1322 LOT AREA 33,368 SITE CLASS. PS DESIGN FLOW 480gpd L.T.A.R. .3 + .27

Septic Tank: 1500 Gallons; STB 338 Date 1-30-06 ☒ New System ☐ Repair ☐ Expansion System Type: I II III IV V VI

Pump Tank: ~~1500~~ Gallons; PT 477 Date 7-9-06 System Description: Pump-LP- Panel Block

Pump Make: Myers Model ME 50 Serial No. Repair System Description: Same

Nitrification Field: No. Fields 1 Square Feet 1080 Linear Feet 360' Maintenance Agreement Required: ☒ Yes ☐ No

No Lines 4@90' Trench Width *See note Max Trench Bottom Depth 36" Gravel Depth N/A ☐ Gravity ☒ Pressure ☐ Slab ☒ Crawl Space ☐ Basement w/plumbing ☐ Basement wo/plumbing

☒ House/Mod. Home No. Bedrooms 5

☐ Mobile Home No. Persons

☐ Business No. Employees


☐ Other

Water Supply: ☐ Individual ☒ Public ☒ Community

Comments:/Conditions: Note: Use trench width as Specified in Crescent Communities On Site Sewage Manual Either sleeve supply line under drive or bury 30 inches or greater.

Comments:/Conditions: Use ~ 21 panels per ditch 3/16" hole to be drilled. Uncked tanks 8/23/06 Pressure, elect & alarm 10/11/06

INITIAL SITE SKETCH Scale 1:50

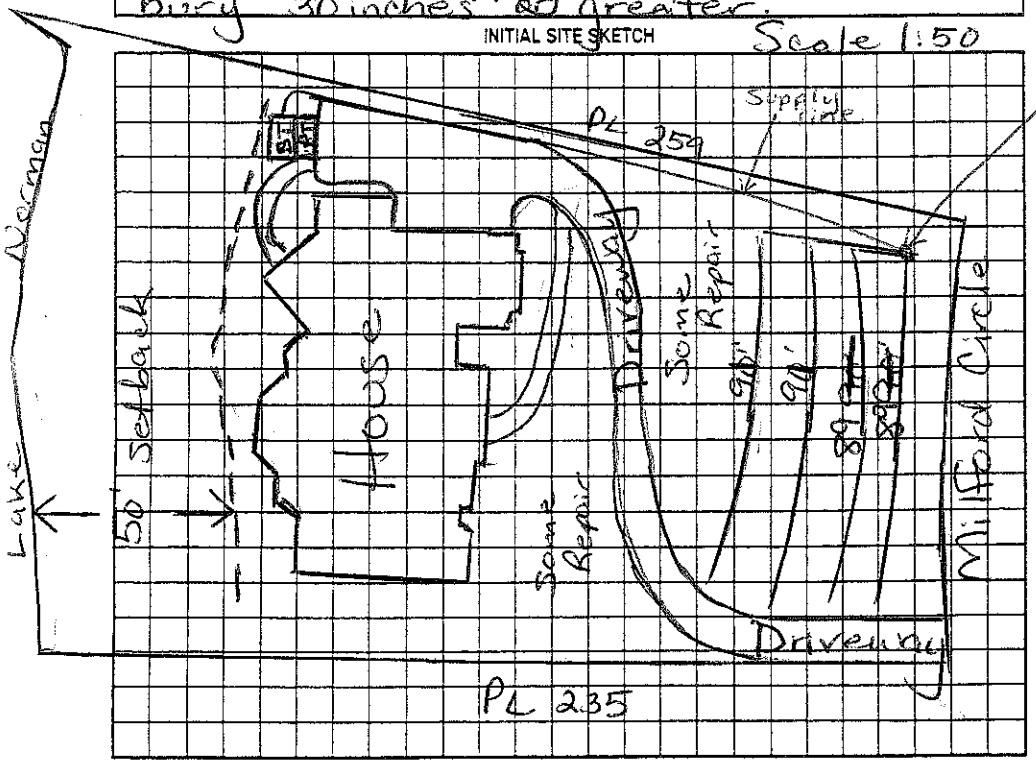

AS BUILT SKETCH

Installed Panel lines as Drawn

Permit can be suspended or revoked if any false information is supplied toward securing the permit/any unauthorized changes are made to the site/any unauthorized changes are made in the installation of the system. Improvement Permit with plat valid without expiration ☐ Improvement Permit with site plan valid for sixty months ☐ Authorization to Construct is valid for a period equal to that of Improvement Permit – not to exceed sixty months.

Signed: date 5/5/06

Improvement Permit by: RS date 5/12/06

Authorization to Construct by: RS date 5/12/06

Installed by: Ratliff RS

Operation Permit by: RS date 10/11/06

Existing System Inspection by: date

HEALTH DEPT. COPY: WHITE OWNER COPY (FINAL): YELLOW OWNER COPY (INITIAL): PINK