IREDELL COUNTY HEALTH DEPARTMENT

STATESVILLE 704-878-5305 MOORESVILLE 704-664-5281

IMPROVEMENT PERMIT / AUTHORIZATION TO CONSTRUCT / OPERATION PERMIT / EXISTING SYSTEM INSPECTION

PERMIT# 19903 PIN# 4625834957 DATE 6-6-05

OWNER OR CONTRACTOR Arcadia Homes PHONE: Business Dan 201-7181 / AJ 622-7102 Home 889-4663

ADDRESS P.O. Box 471941 Charlotte, NC

LOCATION Brawley School Rd TL Yacht Rd TL Milford Circle on right

SUBDIVISION The Point BLOCK / SECTION 13 LOT 136 LOT AREA 1.05 Acre SITE CLASS. PS DESIGN FLOW 600gpd L.T.A.R. .3

Septic Tank: 1500 Gallons; STB 338 Date 4-12-05
Pump Tank: 1500 Gallons; PT 477 Date 6-25-05
Pump Make: Goulds Model WE0312M Serial No.
Nitrification Field: No Fields 1 Square Feet 1500 Linear Feet 500
No Lines 4@125' eq Trench Width 36" Max Trench Bottom Depth 36" Gravel Depth N/A

☒ New System ☐ Repair System Type: I, II, III, IV, V, VI
System Description: Pump - 25% Reduction
Repair System Description: Pump-Ct-Panel Blk
Maintenance Agreement Required: ☐ Yes ☐ No

☒ House/Mod. Home ☐ Mobile Home ☐ Business ☐ Other
No. Bedrooms 5 No. Bathrooms 5 No. Employees

Water Supply: ☐ Individual ☒ Public ☒ Community


☐ Slab ☒ Crawl Space ☐ Basement w/plumbing ☐ Basement wo/plumbing

Comments:/Conditions: Keep Pool at least 15' from Septic System

Comments:/Conditions: Checked lines 9/1/05 Checked tanks 9/2/05
2/1/06 Checked pressure, elect & alarm

Scale 1:50

INITIAL SITE SKETCH Pl. 224.31

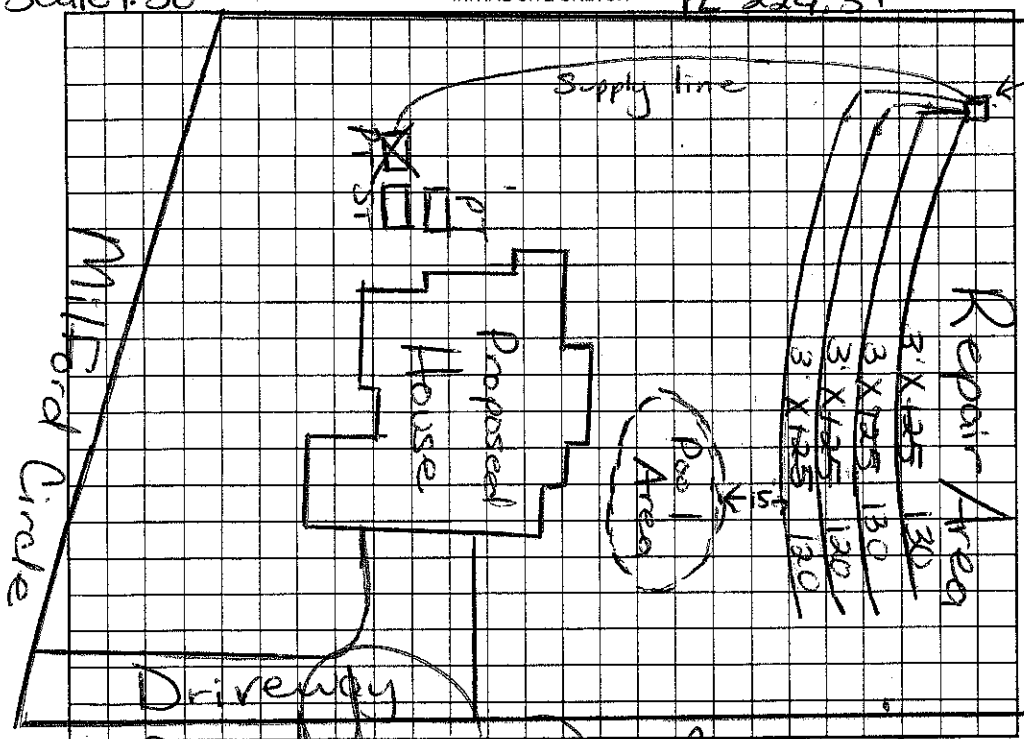

AS BUILT SKETCH

Installed as Drawn
Used EZ Flow

Permit can be suspended or revoked if any false information is supplied toward securing the permit, any unauthorized changes are made to the site/any unauthorized changes are made in the installation of the system. Improvement Permit with plat valid without expiration. Improvement Permit with site plan valid for sixty months. Authorization to Construct is valid for a period equal to that of Improvement Permit – not to exceed sixty months.

Signed: date 6-7-05 Installed by: R & H RS

Improvement Permit by: Maria H. Dobson RS date 6/6/05 Operation Permit by: Maria H. Dobson date 2/1/06

Authorization to Construct by: Maria H. Dobson RS date 6/6/05 Existing System Inspection by: date

HEALTH DEPT. COPY: WHITE OWNER COPY (FINAL): YELLOW OWNER COPY (INITIAL): PINK