IREDELL COUNTY HEALTH DEPARTMENT

STATESVILLE 704-878-5305 MOORESVILLE 704-664-5281

IMPROVEMENT PERMIT / AUTHORIZATION TO CONSTRUCT / OPERATION PERMIT / EXISTING SYSTEM INSPECTION

PERMIT # 174380 PIN # 4692591666 72 DATE 8-7-2012

OWNER or APPLICANT John Brian Donehoo PHONE: Business 704 660-1811 Home: 704 488 1622

OWNER or APPLICANT ADDRESS 224 Milford Circle Mville, NC 28117

LOCATION / DIRECTIONS Brawley School Rd TL Yacht Rd TL Milford Circle on Rt

SUBDIVISION The Point BLOCK / SECTION C LOT # 1362 LOT AREA 1.05Ac DESIGN FLOW 600 L.T.A.R. .3

EXIST

Septic Tank 1500 Gallons: STB ____ Date ____

Pump Tank 1500 Gallons: P T ____ Date ____

Pump Make ____ Model ____ Serial # ____

Nitrification Field No Fields 1 No Lines 2 Linear Feet 168

Trench Width X 24" min Max. Trench Bottom Depth 36" Gravel Depth N/A

☐ New System ☐ Repair ☒ Expansion System Type I II III IV V VI

System Description: LP & Panel Block

Repair System Description: Same

Maintenance Agreement Required ☒ YES ☐ NO

☐ GRAVITY ☒ PRESSURE

☒ Residence No. Bedrooms 5

☐ Business No. Persons ____

☐ Other No. Employees ____

☐ Slab ☒ Crawl Space

☐ Basement w/plumbing ☐ Basement w/o plumbing


Water Supply: ☐ Private ☐ Public ☒ Community

Comments / Conditions X Use trench width as specified in Crescent Communities Manual


Comments / Conditions Abandon lower two lines that are within 15ft of Pool Cut. Install 2 new Panel lines above. Call Health Dept. prior to installation. May salvage any part of Drainfield >15ft from Pool.

Installed 2 lines as shown 8/28/12 Checked lines & set pressure 2 lower lines

INITIAL SITE SKETCH

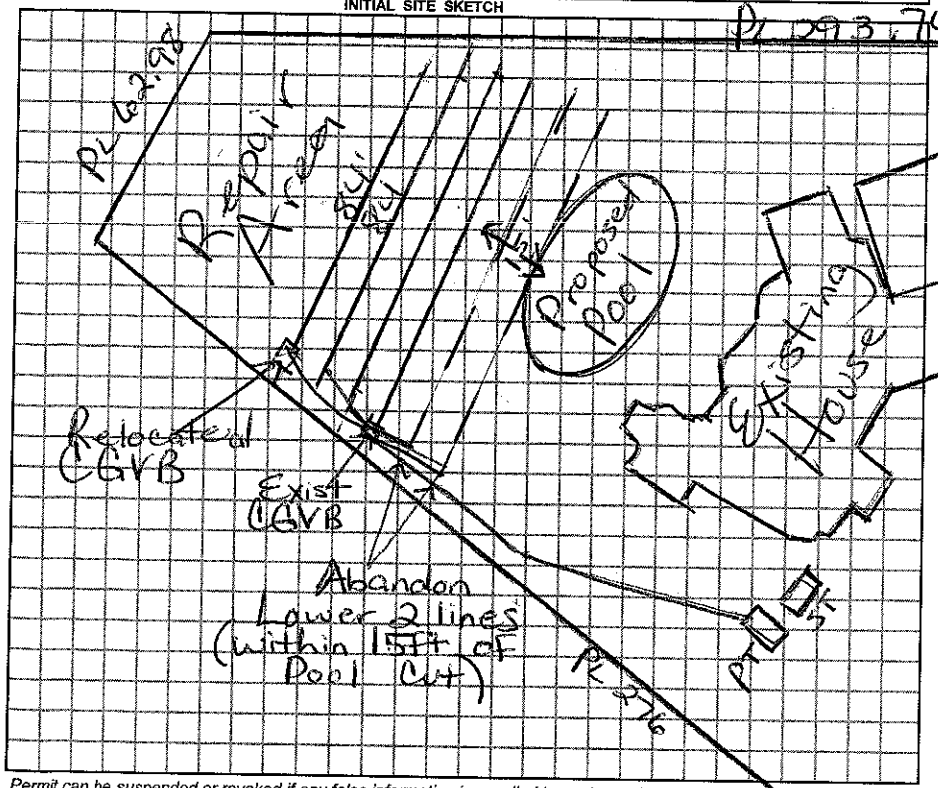

AS BUILT SKETCH

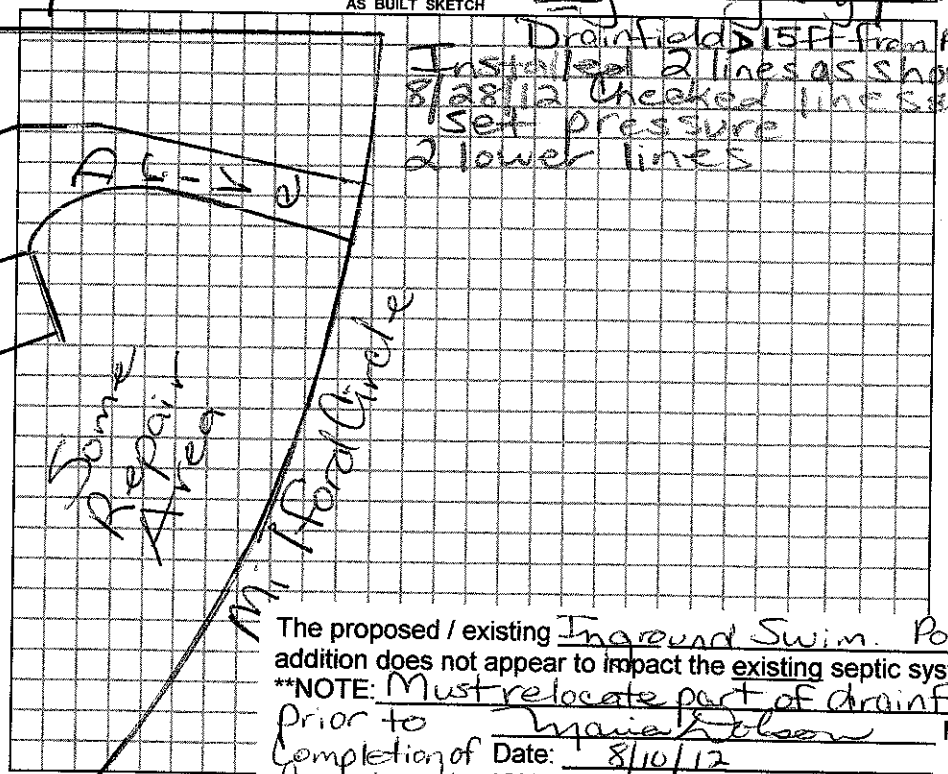

The proposed / existing Inground Swim. Pool addition does not appear to impact the existing septic system.

**NOTE: Must relocate part of drainfield prior to completion of Construction Maria H. Dotson R.S. Date: 8/10/12

ICHD-Environmental Health Division

Permit can be suspended or revoked if any false information is supplied toward securing the permit / any unauthorized changes are made to the site / any unauthori

☐ IMPROVEMENT PERMIT w / plat valid without expiration. ☐ IMPROVEMENT PERMIT w / site plan valid for 60 mos. ☒ AUTHORIZATION TO CONSTRUCT valid for period equal to IMPROVEMENT PERMIT-not to exceed 60 mo.

Owner / Applicant Signature: X [signature] Date 8/10/12

Improvement Permit by: Maria H. Dotson RS Date 8/9/12

Authorization to Construct by: Maria H. Dotson RS Date 8/9/12

Installed by: R & H RS

Operation Permit by: Maria H. Dotson Date: 8/28/12

Existing System Inspected by: ____ Date: ____

YOU SHOULD CONTACT A LOCATOR SERVICE PRIOR TO ANY EXCAVATION.

WHITE COPY Environmental Health YELLOW COPY (Final) Owner / Applicant PINK COPY (Initial) Owner / Applicant