IREDELL COUNTY HEALTH DEPARTMENT

STATESVILLE 704-878-5305 ~~195~~ 00 Paid MOORESVILLE 704-664-5281

IMPROVEMENT PERMIT / AUTHORIZATION TO CONSTRUCT / OPERATION PERMIT / EXISTING SYSTEM INSPECTION

PERMIT# 119916 PIN# ~~4625834957~~ 4625-91-7707 DATE 3-28-05

OWNER OR CONTRACTOR David Dibble Construction PHONE: Business 799-1688 Home

ADDRESS

LOCATION Brawley School Rd TL Yacht Rd TL Milford Circle on right

SUBDIVISION The Point BLOCK / SECTION 13 LOT 1363 LOT AREA 1.05 Acre SITE CLASS. PS DESIGN FLOW 600 gpd L.T.A.R. .25

Septic Tank: 1500 Gallons; STB 338 Date 7/26/05
Pump Tank 1500 Gallons; PT 4377 Date 2/15/05
Pump Make: Goulds Model ~~WE~~ 512 HHA Serial No E0554445
Nitrification Field: No Fields 1 Square Feet 860-1200 Linear Feet 400'
No Lines 4 Trench Width 36" Max Trench Bottom Depth 36" Gravel Depth N/A

☒ New System ☐ Repair System Type: I, II, III, (IV), V, VI
System Description: Pump-LP-Panel Block
Repair System Description: Same
Maintenance Agreement Required: ☐ Yes ☐ No

☒ House/Mod. Home No. Bedrooms 5
☐ Mobile Home No. Bathrooms 4
☐ Business No. Employees
☐ Other

☐ Slab ☒ Crawl Space ☐ Basement w/plumbing ☐ Basement wo/plumbing


Water Supply:
☐ Individual
☒ Public
☒ Community

Comments:/Conditions:

Scale 1:50

Comments:/Conditions:
Tanks, Lines, Pressure

INITIAL SITE SKETCH

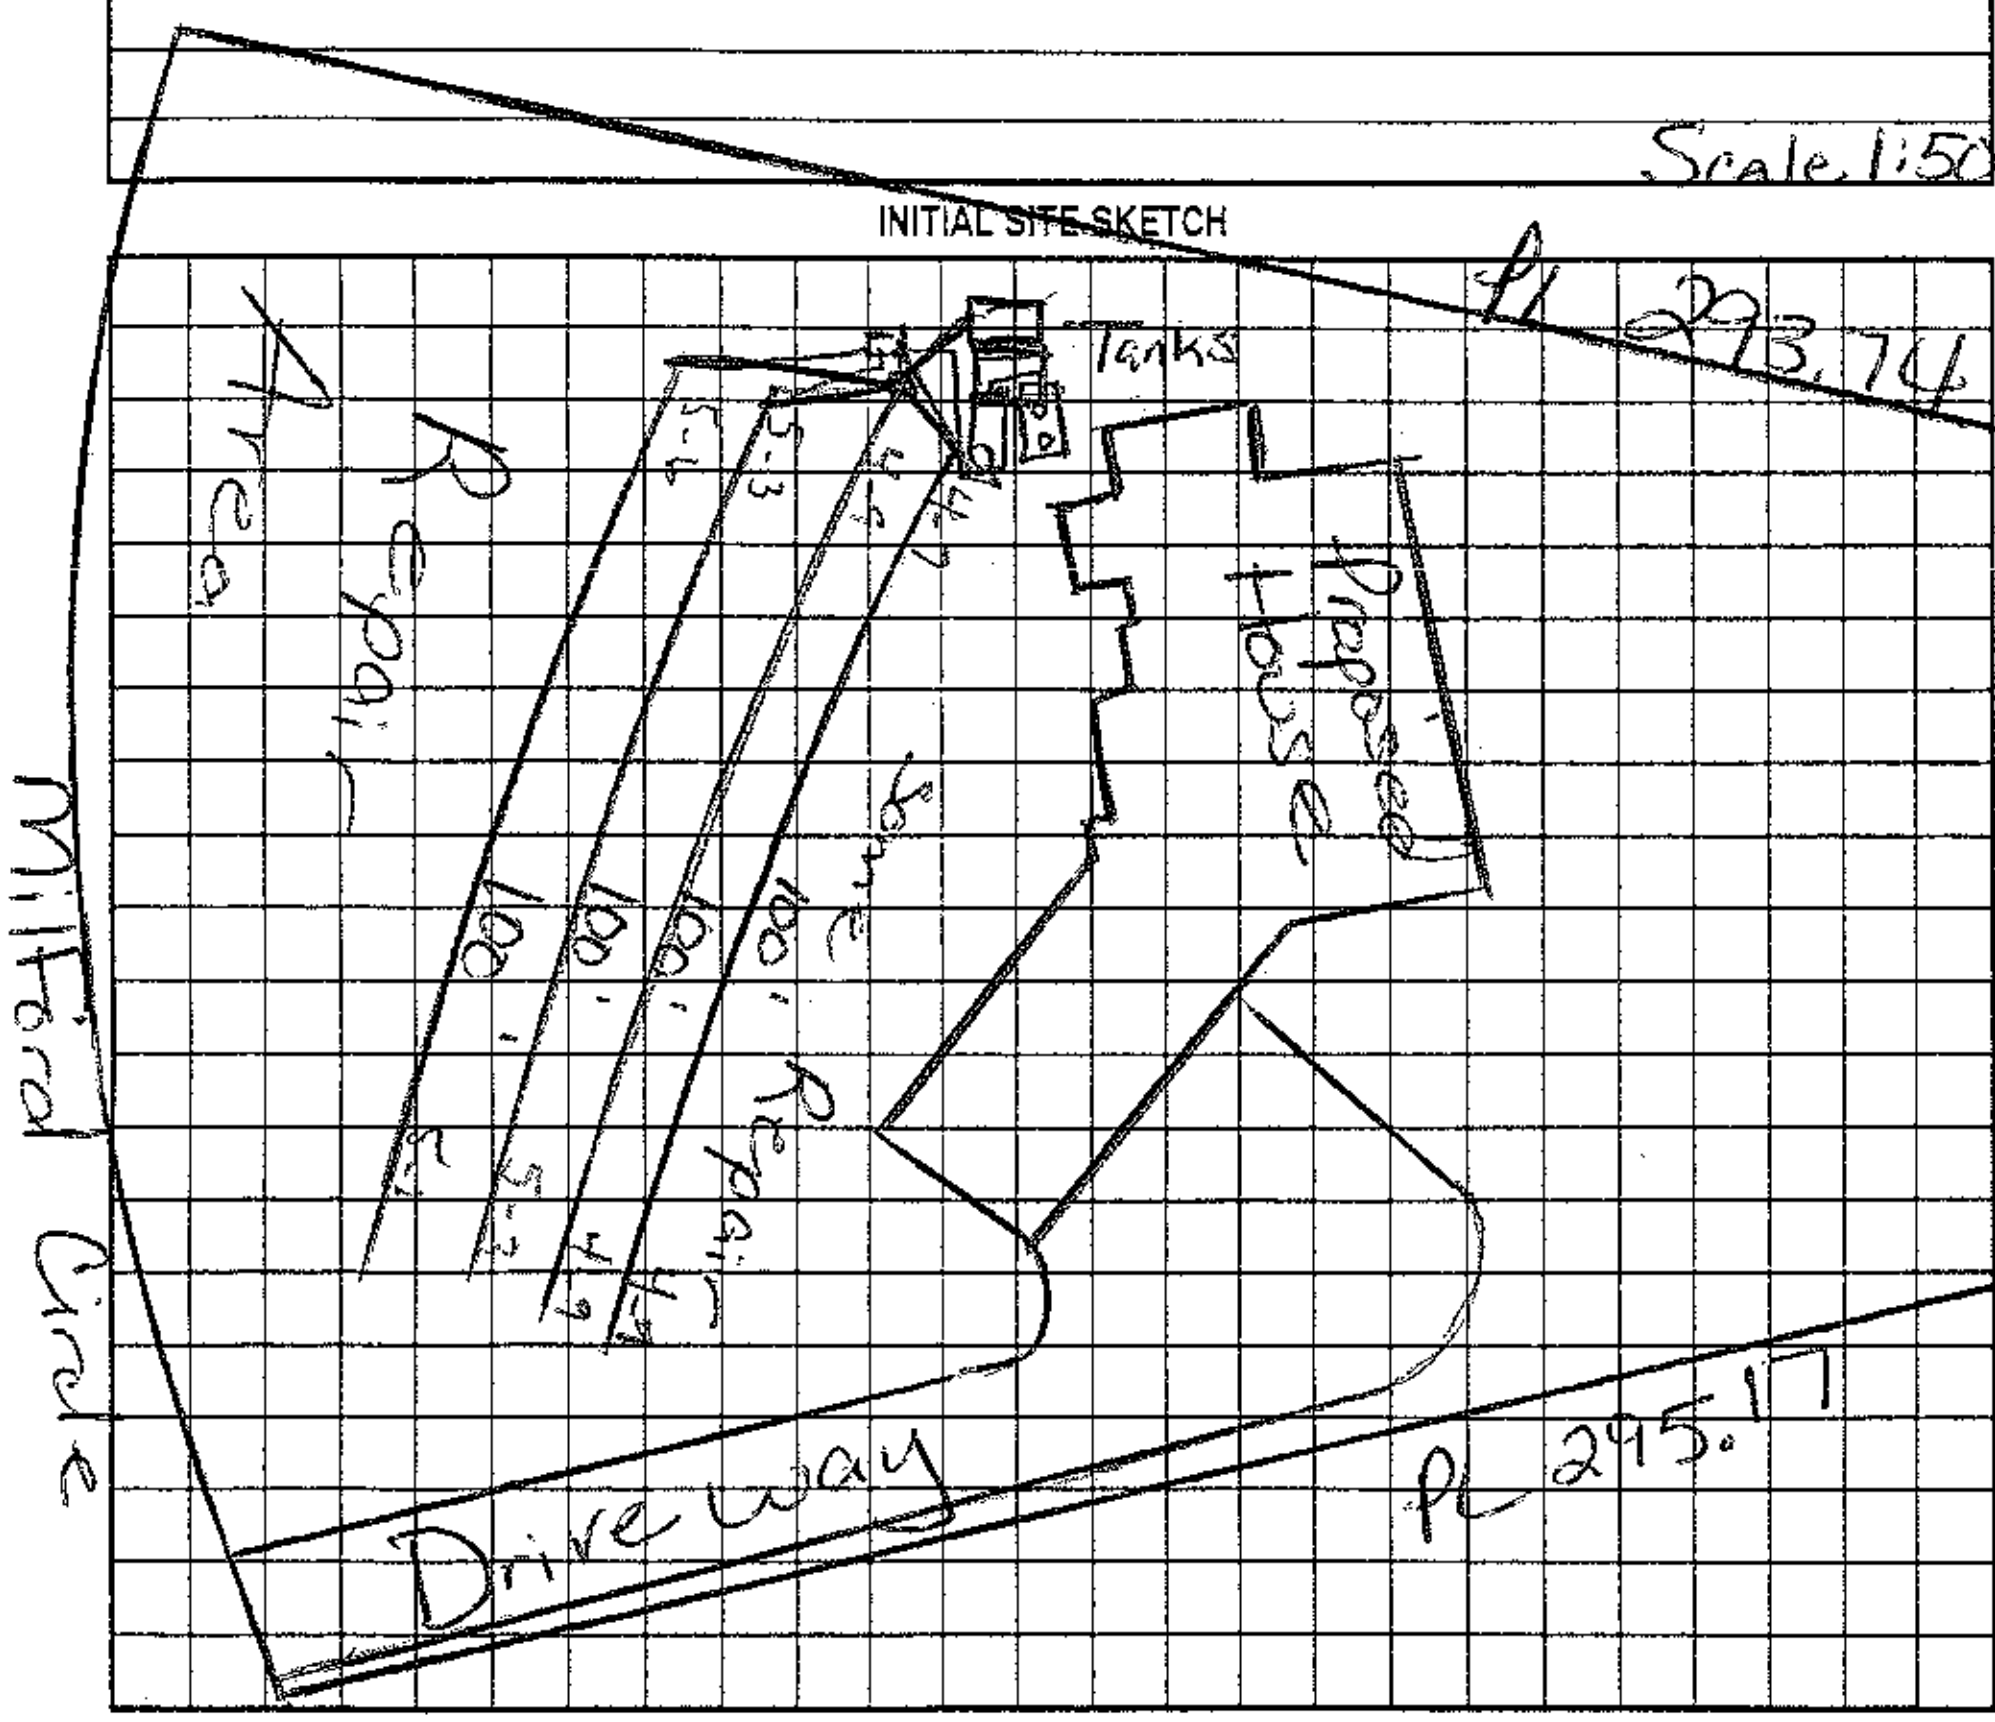

AS BUILT SKETCH

SEE ATTACHED PLAN FOR POOL & covered porch

Complex Topo

PL 356.50

The proposed / ~~existing~~ covered porch addition does not appear to impact the existing septic system.
**NOTE: see attached sketch
[signature] REHS
Date: 3-15-10
ICHD-Environmental Health Division

The proposed / existing POOL addition does not appear to impact the existing septic system.
**NOTE:
[signature] R.S.
Date: 2-3-10
ICHD-Environmental Health Division

Permit can be suspended or revoked if any false information is supplied toward securing the permit/any unauthorized changes are made to the site/any unauthorized changes are made in the installation of the system. Improvement Permit with plat valid without expiration. Improvement Permit with site plan valid for sixty months. Authorization to Construct is valid for a period equal to that of Improvement Permit – not to exceed sixty months.

Signed: [signature] date 3/28/05 Installed by: Robinson & Sons
Improvement Permit by: [signature] RS date 3/28/05 Operation Permit by: Wesley Sparks R.S. date 1/9/06
Authorization to Construct by: [signature] RS date 3/28/05 Existing System Inspection by: date

HEALTH DEPT. COPY: WHITE OWNER COPY (FINAL): YELLOW OWNER COPY (INITIAL): PINK