IREDELL COUNTY HEALTH DEPARTMENT

STATESVILLE 704-878-5305 MOORESVILLE 704-664-5281

IMPROVEMENT PERMIT / AUTHORIZATION TO CONSTRUCT / OPERATION PERMIT / EXISTING SYSTEM INSPECTION

PERMIT# 118936 PIN# 4625 83 7757.1326 4625919263 DATE 3/24/06

OWNER OR APPLICANT Simoniz Bldrs PHONE: Business Home

ADDRESS 817 E. Morehead St. Ste. 100 Charlotte NC 28202

LOCATION BSR TL Yacht TL Mitford, TL Conway At End 108

SUBDIVISION The Point BLOCK / SECTION 13 LOT 1326 LOT AREA 1.452 AC SITE CLASS. PS DESIGN FLOW 600 L.T.A.R. 0.3

Septic Tank: 1500 Gallons: STB 338 Date 3-20-07
Pump Tank: 1500 Gallons: PT 477 Date 3-25-07
Pump Make: Goulds Model WE03J2ML Serial No.
Nitrification Field: No Fields 1 Square Feet 1512 Linear Feet 504
No Lines 6@84' Trench Width 36" Max Trench Bottom Depth 36" Gravel Depth

☒ New System ☐ Repair ☐ Expansion System Type: I II III IV V VI
System Description: Pump 25% Reduction
Repair System Description: Same
Maintenance Agreement Required: ☐ Yes ☒ No

☒ House/Mod. Home No. Bedrooms 5
☐ Mobile Home No. Persons
☐ Business No. Employees
☐ Other


Water Supply: ☐ Individual ☐ Public ☒ Community

☐ Gravity ☒ Pressure ☐ Slab ☒ Crawl Space ☐ Basement w/plumbing ☐ Basement wo/plumbing


Comments:/Conditions:

Comments:/Conditions: 4/30/07 Checked tankss
5/7/07 Checked lines Used Quick 4

INITIAL SITE SKETCH

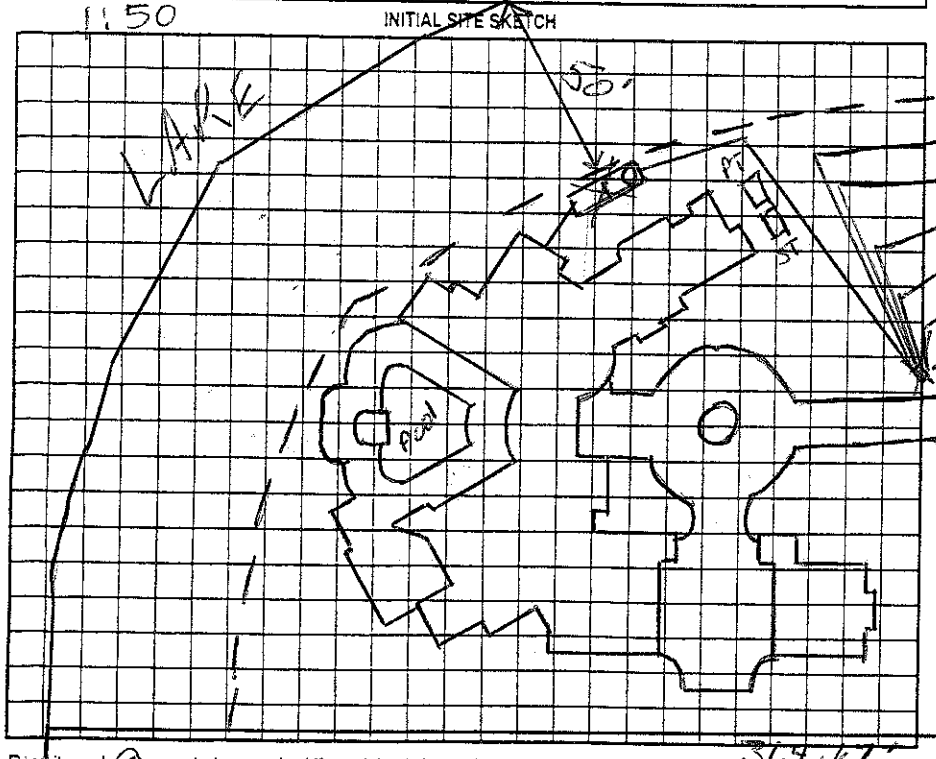

AS BUILT SKETCH

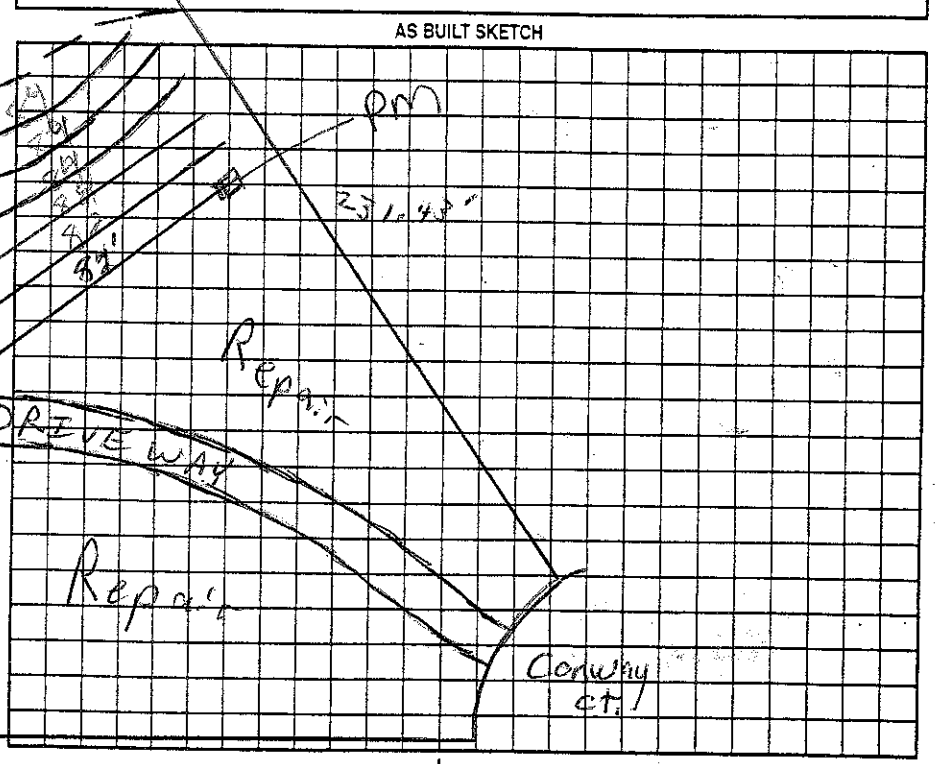

Permit can be suspended or revoked if any false information is supplied toward securing the permit/any unauthorized changes are made to the site/any unauthorized changes are made in the installation of the system. Improvement Permit with plat valid without expiration. ☐ Improvement Permit with site plan valid for sixty months ☐ Authorization to Construct is valid for a period equal to that of Improvement Permit – not to exceed sixty months.

Signed: date 4-20-06

Improvement Permit by: RS date 3/24/06

Authorization to Construct by: RS date 3/24/06

Installed by: R&H KS

Operation Permit by: date 6/20/07

Existing System Inspection by: date

HEALTH DEPT. COPY: WHITE OWNER COPY (FINAL): YELLOW OWNER COPY (INITIAL): PINK