IREDELL COUNTY HEALTH DEPARTMENT

STATESVILLE 704-878-5305 MOORESVILLE 704-664-5281

IMPROVEMENT PERMIT / AUTHORIZATION TO CONSTRUCT / OPERATION PERMIT / EXISTING SYSTEM INSPECTION

PERMIT# 13504 PIN# 4625921170 Kathleen DATE 5-19-06

OWNER OR APPLICANT The Point on Norman LLC / SAME PHONE: Business 942-1250 Home

ADDRESS P.O. Box 1003 Charlotte, NC 28201

LOCATION Brawley School Rd TR Yacht Rd TL Milford on right

SUBDIVISION The Point BLOCK / SECTION 13 LOT 1367 LOT AREA 1.125Acre SITE CLASS. PS DESIGN FLOW 450gpd L.T.A.R. .3

Septic Tank: 1000 Gallons: STB 444 Date

Pump Tank: 1500 Gallons: PT Date

Pump Make: Model Serial No.

Nitrification Field: No Fields 1 Square Feet 1206' Linear Feet 402'

No Lines. 3@134' Trench Width 36" Max Trench Bottom Depth 36" Gravel Depth N/A

☒ New System ☐ Repair ☐ Expansion System Type: I II III IV V VI "Accept"

System Description: Gravity-25% Reduction

Repair System Description: 4P-Panel Block

Maintenance Agreement Required: ☐ Yes ☒ No Not initially

☒ House/Mod. Home No. Bedrooms 4

☐ Mobile Home No. Persons

☐ Business No. Employees

☐ Other


Water Supply: ☐ Individual ☒ Public ☒ Community

☒ Gravity ☐ Pressure ☐ Slab ☒ Crawl Space ☐ Basement w/plumbing ☐ Basement wo/plumbing

Comments:/Conditions:

PL 231.6

INITIAL SITE SKETCH

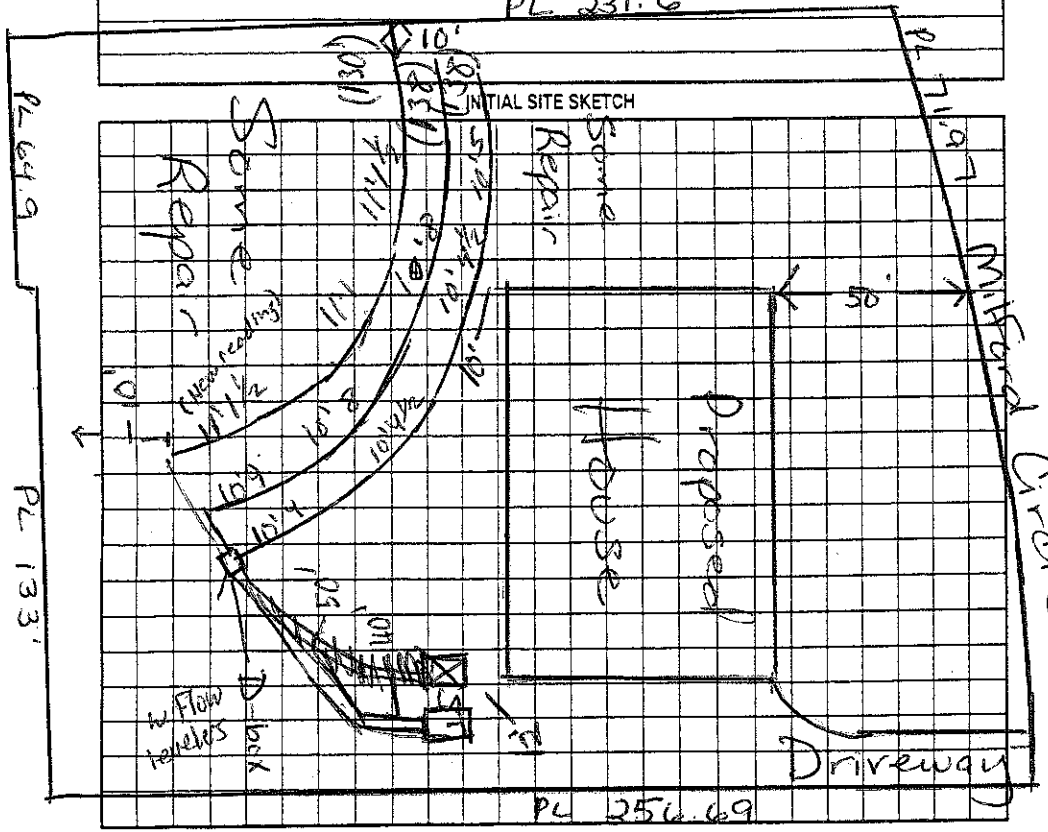

Comments:/Conditions:

AS BUILT SKETCH

Infiltrator Quick4 Installed

10/17/07 AC

Permit can be suspended or revoked if any false information is supplied toward securing the permit/any unauthorized changes are made to the site/any unauthorized changes are made in the installation of the system. Improvement Permit with plat valid without expiration ☐ Improvement Permit with site plan valid for sixty months ☐ Authorization to Construct is valid for a period equal to that of Improvement Permit – not to exceed sixty months.

Signed: date 5-28-06

Improvement Permit by: RS date 5/19/06

Authorization to Construct by: date 4/4/07

Installed by: Stanley Septic

Operation Permit by: Anthony Cobert date 10/17/07

Existing System Inspection by: date

HEALTH DEPT. COPY: WHITE OWNER COPY (FINAL): YELLOW OWNER COPY (INITIAL): PINK