IREDELL COUNTY HEALTH DEPARTMENT

Statesville Office (704) 878-5305 Mooresville Office (704) 660-3625 Orig #118969 PERMIT # 208952

IMPROVEMENT PERMIT / AUTHORIZATION TO CONSTRUCT / OPERATION PERMIT / EXISTING SYSTEM

PIN # 4625-92-2641.000

APPLICANT: Sean Higbea APPLICANT ADDRESS: 4301 Andrew James Dr. Charlotte NC 28216

SITE ADDRESS: 108 Waitsfield Ct. Mooresville NC PHONE: 704-399-9648 ALT. PHONE: 704-453-7097

SITE DIRECTIONS: BSR, TL Yacht, TL Mustard Creek, TL Waitsfield Ct., AT END

SUBDIVISION: The Point on Norman SECTION: P13 LOT # 1339 LOT AREA: .99 Acre DESIGN FLOW: 480 GPD L.T.A.R.: .3

Septic Tank 1500 (gal) STB 944 Date 4-7-16
Pump Tank 1500 (gal) PT 477 Date 2-23-16
Pump Make Orenco Model Serial #
Nitrification Fields 1 # Lines 6 Linear Ft: 280'
Trench Width 36" Max. Trench Bottom Depth 36" Gravel Depth N/A

☒ New System ☐ Repair ☐ Expansion System Type: I II III IV V VI
System Description: LP PRBDS
Repair System Description: LP PRBDS
Maintenance Agreement Required: ☒ YES ☐ NO
☐ GRAVITY ☒ PRESSURE

☒ Residence No. Bedrooms 4
☐ Business No. Persons 8
☐ Other No. Employees
☐ Slab ☐ Crawl Space
☒ Basement w/plumbing ☐ Basement w/o plumbing

Water Supply: ☐ Private ☐ Public ☒ Community

Comments / Conditions: Follow All Septic Rules.
If Repair is ever used, HardPipe 10' thru headslope on 78' O and 69' W.

6/10/16 Checked tanks (19FT away from house) also checked uppermost drainline


INITIAL SITE SKETCH

See Attached Approved Design By S.M.E

Dated APPROVED MAR 24 2016

	Date	Initials
Drain Lines Checked	6/13/16	SS+MS
Tanks Checked	6/10/16	MS+WL
Pressure Manifold or Valve Box Checked		
Pressure Head Set	6/13/16	SS+MS
Electrical Checked	7/21/16	MD
Floats Set		
Alarm Checked		
Maintenance Contract (Y) N		

AS BUILT SKETCH

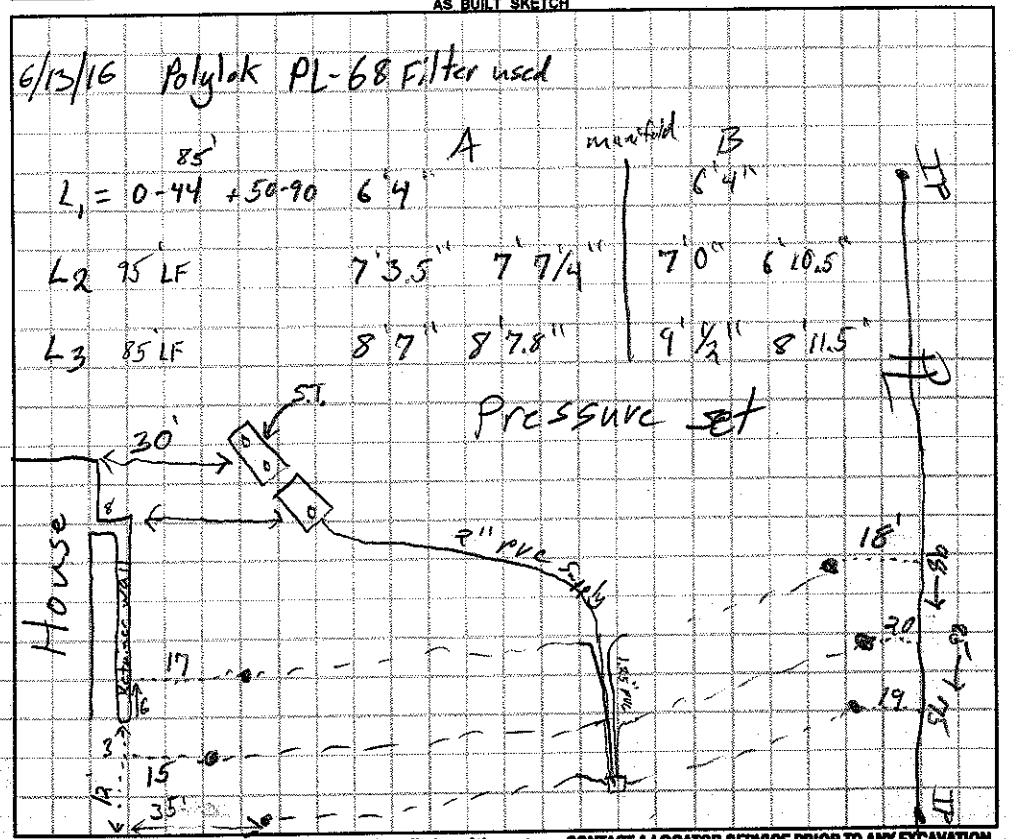

Permit can be suspended or revoked if any false information is supplied toward securing the permit / any unauthorized changes are made to the site / any unauthorized changes are made in the installation of the system. **CONTACT A LOCATOR SERVICE PRIOR TO ANY EXCAVATION**

☐ **IMPROVEMENT PERMIT** *with plat valid without expiration.* ☒ **IMPROVEMENT PERMIT** *with site plan valid for 60 mos.* ☒ **AUTHORIZATION TO CONSTRUCT** *valid for period equal to IMPROVEMENT PERMIT--not to exceed 60 mo.*

Owner / Applicant Signature: Date: 3/8/16

IMPROVEMENT PERMIT by: APPROVED MAR 24 2016

AUTHORIZATION TO CONSTRUCT by: APPROVED MAR 24 2016


Installed by: Specialty Septic

OPERATION PERMIT by: Date: 7/21/16

Existing System Inspected by: Date:

Health Dept. Copy - WHITE Applicant (Final Approval) - YELLOW Applicant (Conditional Approval) - PINK

OK IHD
APPROVED MAR 24 2015
SC

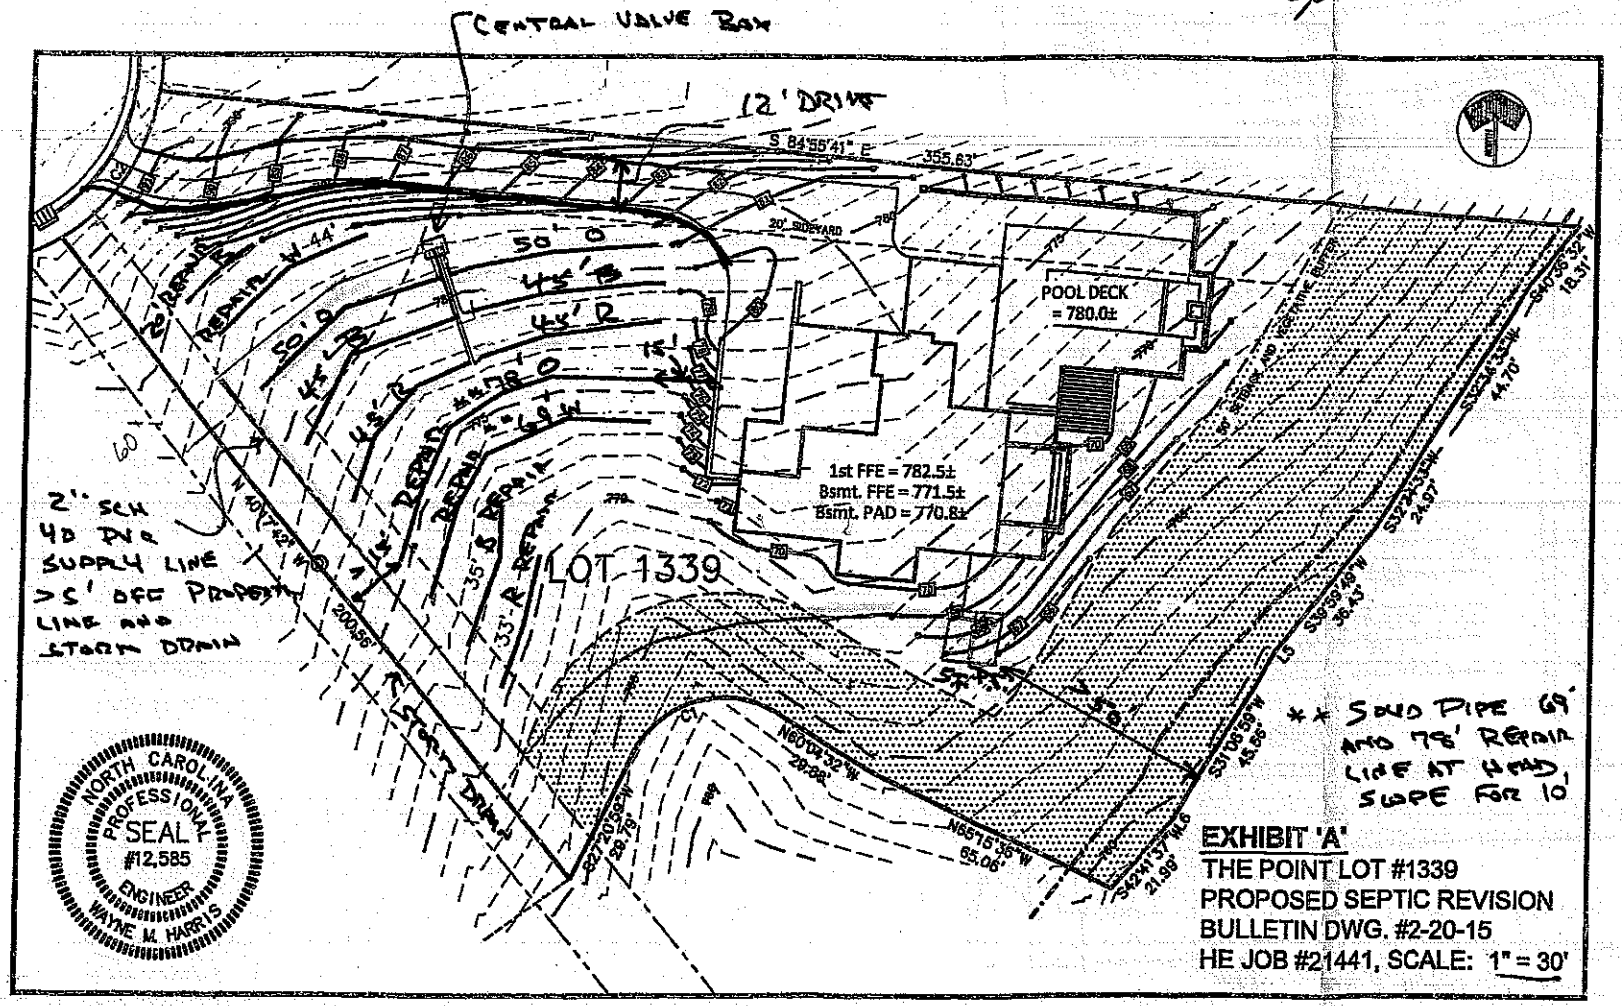

S:\21441 - POINT LOT 1339\ENGR\BULLETIN DWG 2-19-15_REV.d

SEAN HIEBER - THE POINT LOT 1339
2-24-15 LIMITED FT. RELAYOUT
SITE PROJECT 1584-12-087

* SITE PLAN MUST ACCOMPANY SITE VISITED REPORT