IREDELL COUNTY HEALTH DEPARTMENT

STATESVILLE 704-878-5305 50.00 Pd MOORESVILLE 704-664-5281

IMPROVEMENT PERMIT / AUTHORIZATION TO CONSTRUCT / OPERATION PERMIT / EXISTING SYSTEM INSPECTIO

PERMIT# 118957 PIN# ~~4625 83 4957.7396~~ 4625-92-4462 DATE 2/7/05

OWNER OR CONTRACTOR Kenneth Beckers Homes PHONE: Business 704-662-6400 Home

ADDRESS Po Box 3398 Mooresville, NC 28117

LOCATION 1100 TL Yacht Rd. TL Milford Circle on L

SUBDIVISION Point BLOCK / SECTION 13 LOT 133/134 LOT AREA .83Ac+ SF SITE CLASS. PS DESIGN FLOW 480 L.T.A.R. .25

Septic Tank 1500 ~~1000~~ Gallons; STB 338 Date 7-25-05 [X] New System [ ] Repair System Type: I, II, III, (IV), V, VI

Pump Tank: 1000 Gallons; PT 253 Date 7-12-05 System Description: Pressed - 16" PPBPS

Pump Make: Myers Model ME 50 Serial No. Repair System Description: Pressed - 16" PPBPS

Nitrification Field: (No Fields 1 Square Feet 640/960 Linear Feet 320 Maintenance Agreement Required: [X] Yes [ ] No

No Lines 4 @ 80' Trench Width 2'-8'OC Max Trench Bottom Depth 3' Gravel Depth NA

[X] House/Mod. Home No. Bedrooms 4 [ ] Mobile Home No. Bathrooms 4 [ ] Business No. Employees [ ] Other

[ ] Slab [X] Crawl Space [X] Basement w/plumbing [ ] Basement wo/plumbing

Water Supply: [ ] Individual [ ] Public [X] Community


Comments:/Conditions:

Supply line must be deeper than 30" or sleeved in a Ferrous Sleeve under traffic area.

Comments:/Conditions: Checked 2 of 4 lines 1/27/06 MD Left Hanks House to move closer to drain field 11 ft. Backfill against garage - do not cut - Gun 2/2/05


Checked other 2 lines 1/30/06 MD

INITIAL SITE SKETCH

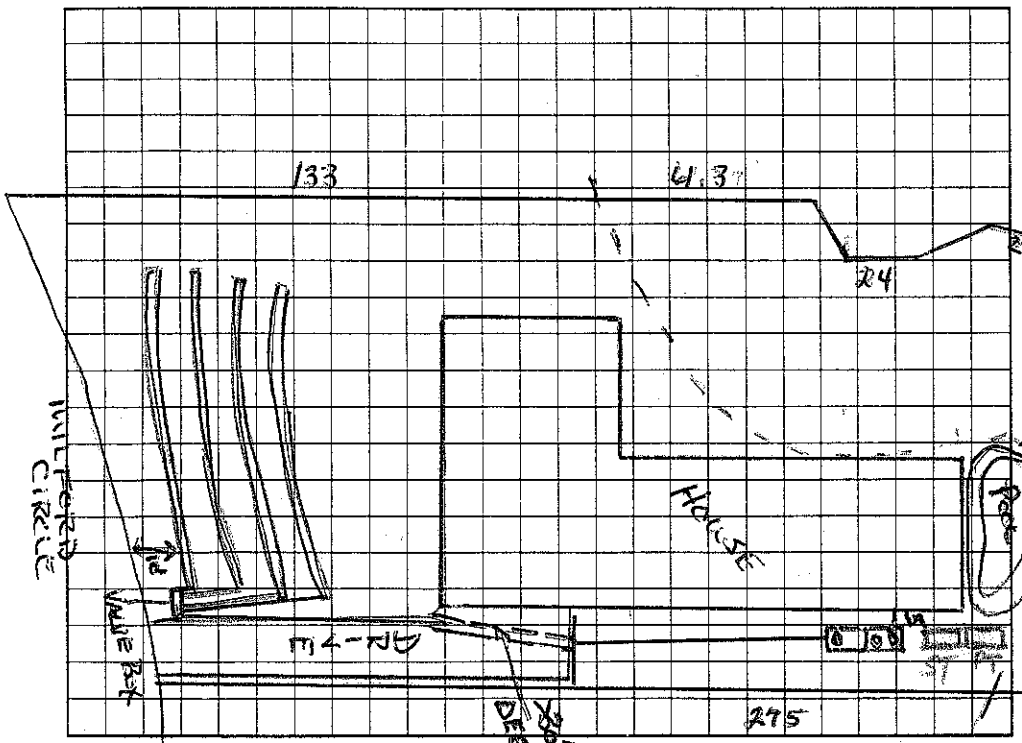

AS BUILT SKETCH

Pressure, Float & Alarm 2/1/06 MD

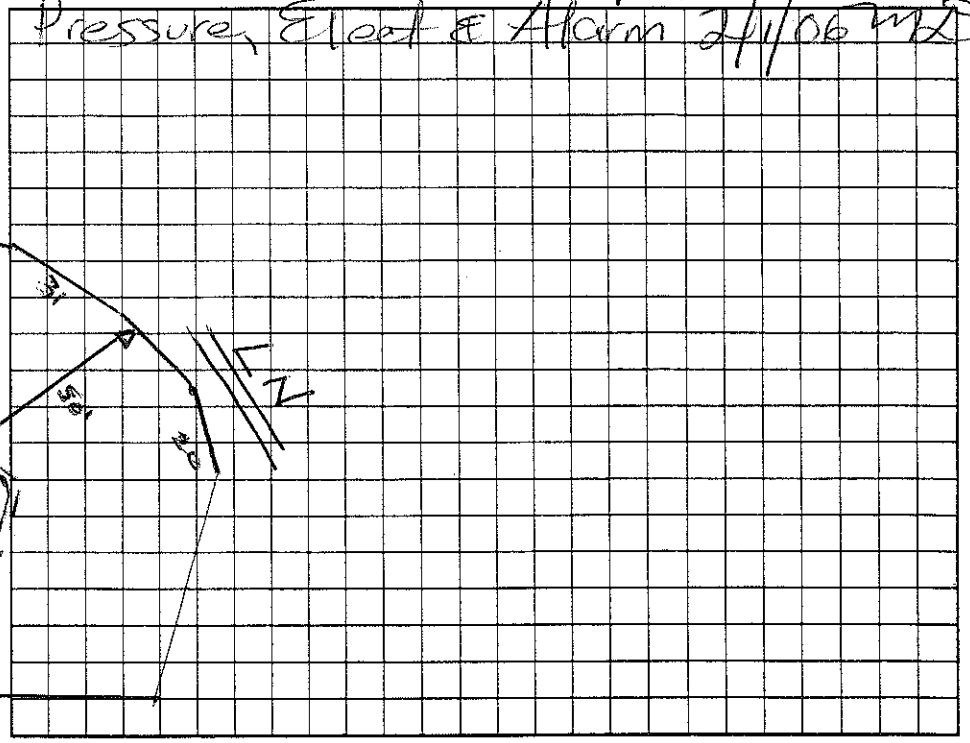

Permit can be suspended or revoked if any false information is supplied toward securing the permit/any unauthorized changes are made to the site/any unauthorized changes are made in the installation of the system. Improvement Permit with plat valid without expiration. Improvement Permit with site plan valid for sixty months. Authorization to Construct is valid for a period equal to that of Improvement Permit – not to exceed sixty months.

Signed: * date 2/8/05 Installed by: R & L KS

Improvement Permit by: Wesley Sparks RS date 2/7/05 Operation Permit by: Maria Hall Dobson date 2/1/06

Authorization to Construct by: Wesley Sparks RS date 2/7/05 Existing System Inspection by: date

HEALTH DEPT. COPY: WHITE OWNER COPY (FINAL): YELLOW OWNER COPY (INITIAL): PINK