IREDELL COUNTY HEALTH DEPARTMENT

STATESVILLE 704-878-5305 / 195.00 Paid MOORESVILLE 704-664-5281

IMPROVEMENT PERMIT / AUTHORIZATION TO CONSTRUCT / OPERATION PERMIT / EXISTING SYSTEM INSPECTION

PERMIT# 118955 PIN# 4625834957 Bill 4625-92-5397 DATE 8-8-05

OWNER OR CONTRACTOR Hughes & Assoc PHONE: Business 704 361-5893 Home 542-6816

ADDRESS 6425 A Bannington Drive Charlotte, NC 28226

LOCATION Brawley School Rd TL Yacht Rd TL Milford Circle on left

SUBDIVISION The Point BLOCK / SECTION 13 LOT 1335 LOT AREA 35,795 ft² SITE CLASS PS DESIGN FLOW 600gpd L.T.A.R. .3

Septic Tank: 1500 Gallons; STB 338 Date 12-23-05

Pump Tank: 1500 Gallons; PT 283 Date 12-23-05

Pump Make: Myers Model PID2 Serial No.

Nitrification Field: No Fields 1 Square Feet 670' - 1005' Linear Feet 335'

No Lines 4 (3@80' 1@60') Trench Width 24"-36" Max Trench Bottom Depth 36" Gravel Depth N/A

☒ New System ☐ Repair System Type: I, II, III, IV, V, VI

System Description: Pump - LP - Panel Block

Repair System Description: Same

Maintenance Agreement Required: ☒ Yes ☐ No

☒ House/Mod. Home No. Bedrooms 5

☐ Mobile Home No. Bathrooms

☐ Business No. Employees

☐ Other

☐ Slab ☐ Crawl Space ☒ Basement w/plumbing ☐ Basement wo/plumbing


Water Supply: ☐ Individual ☒ Public ☒ Community

Comments:/Conditions: * Note: Keep Drainlines at least 25' from basement. Supply line can be 10' from basement.
** Very tight to setbacks


Comments:/Conditions: ** Keep pool 15' from ST & PT IF foundation drain is side slope of tanks then setback is 15ft; if drain is upslope of tanks then 10ft.

Scale 1:50

INITIAL SITE SKETCH

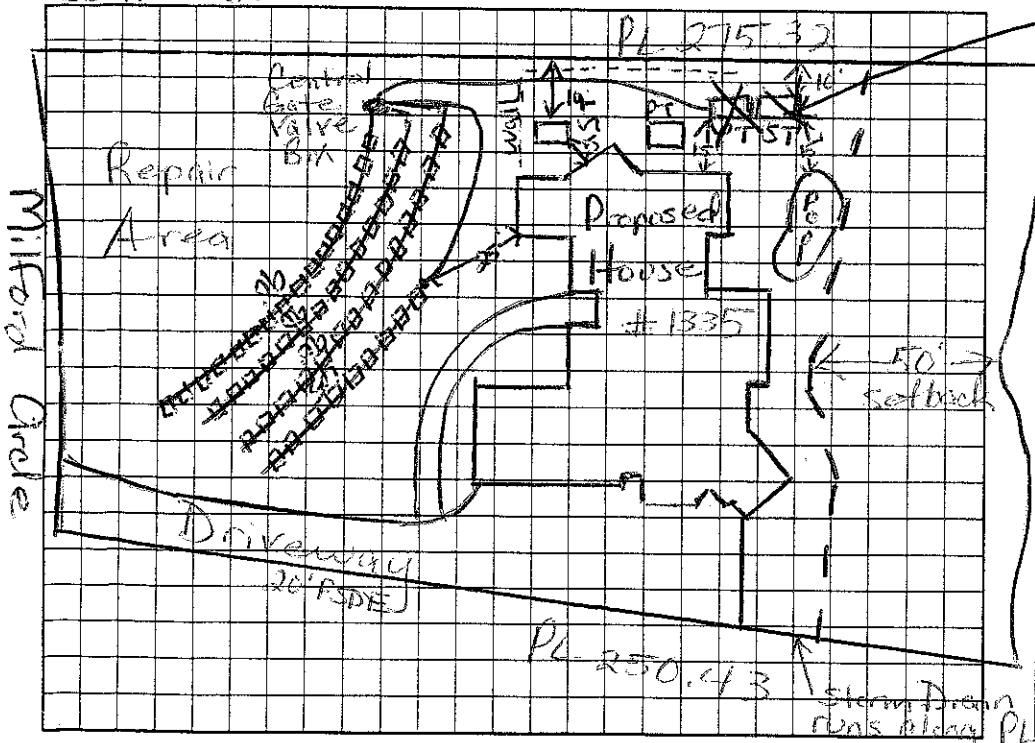

AS BUILT SKETCH

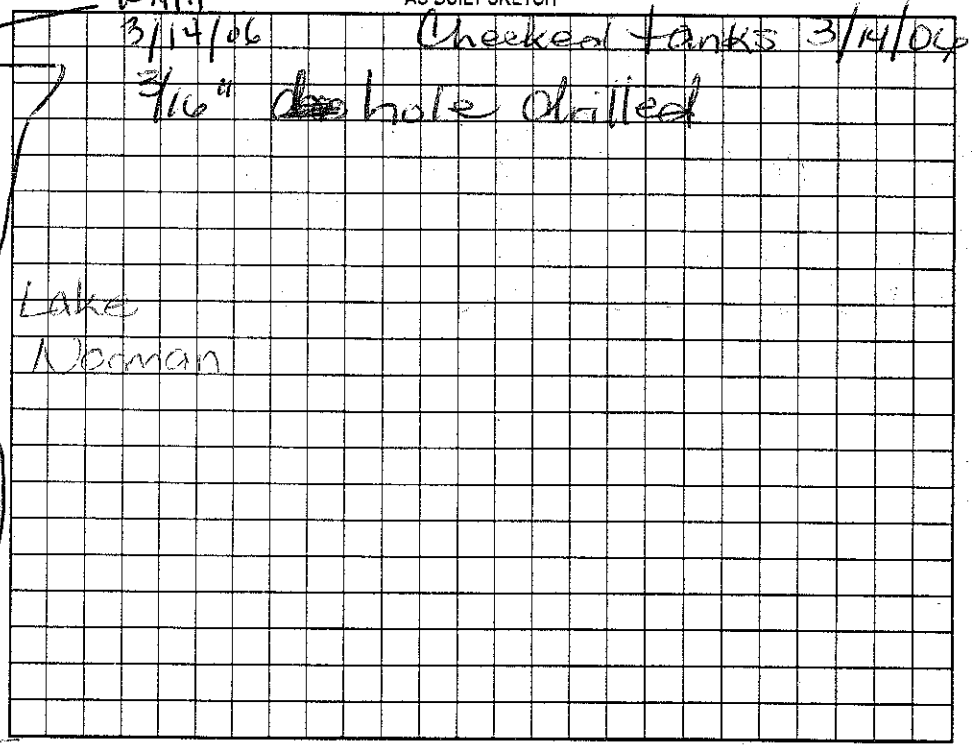

Permit can be suspended or revoked if any false information is supplied toward securing the permit/any unauthorized changes are made to the site/any unauthorized changes are made in the installation of the system. Improvement Permit with plat valid without expiration. Improvement Permit with site plan valid for sixty months. Authorization to Construct is valid for a period equal to that of Improvement Permit – not to exceed sixty months.

Signed: Bill Farlow 8/12/05 date 8/12-05

Improvement Permit by: Maria H. Dolson RS date 8/8/05

Authorization to Construct by: Maria H. Dolson RS date 8/8/05

Installed by: R&H RS

Operation Permit by: Maria H. Dolson date 11/14/06

Existing System Inspection by: date

HEALTH DEPT. COPY: WHITE OWNER COPY (FINAL): YELLOW OWNER COPY (INITIAL): PINK