$100.00

IREDELL COUNTY HEALTH DEPARTMENT

STATESVILLE 704-878-5305 MOORESVILLE 704-664-5281

IMPROVEMENT PERMIT / AUTHORIZATION TO CONSTRUCT / OPERATION PERMIT / EXISTING SYSTEM INSPECTION

PERMIT# 11895 PIN# 4625834957.13333 4625-92-8119 DATE 4-21-06

OWNER OR APPLICANT Arcadia Homes PHONE: Business _____ Home _____

ADDRESS P.O. Box 471941 Charlotte, NC 28247

LOCATION Brawley School Rd TL Yacht Rd TL Milford Circle On left

SUBDIVISION The Point BLOCK / SECTION 13 LOT 1333 LOT AREA 33,428 Ft.2 SITE CLASS. PS DESIGN FLOW 600 L.T.A.R. .3

Septic Tank: 1500 Gallons; STB 33X Date 3-28-06 ☒ New System ☐ Repair ☐ Expansion System Type: I II III IV V VI

Pump Tank: 1500 Gallons; PT 4 FT Date 4-1-06 System Description: Pump-LP-Panel Block

Pump Make: Myers Model ME50S Serial No. _____ Repair System Description: Same

Nitrification Field: No Fields 1 Square Feet _____ Linear Feet 336 Maintenance Agreement Required: ☒ Yes ☐ No

No Lines 4 Trench Width *See Note Max Trench Bottom Depth 36 Gravel Depth _____ ☐ Gravity ☐ Pressure ☐ Slab ☐ Crawl Space ☒ Basement w/plumbing ☐ Basement wo/plumbing


☒ House/Mod. ☐ Mobile Home ☐ Business ☐ Other — No. Bedrooms 5 No. Persons ____ No. Employees ____

Water Supply: ☐ Individual ☒ Public ☐ Community


Comments:/Conditions: Remove all berms. Keep Drainfield at least 25' from basement wall. Keep tanks 15ft (sideslope) from basement or 10ft (downslope) of house.

Comments:/Conditions: ~20 panels in 3 ditches
~17 panels in lowest ditch
* Note: Use trench width as specified in Crescent Communities On Site Sewage Manual

Scale 1:50 INITIAL SITE SKETCH

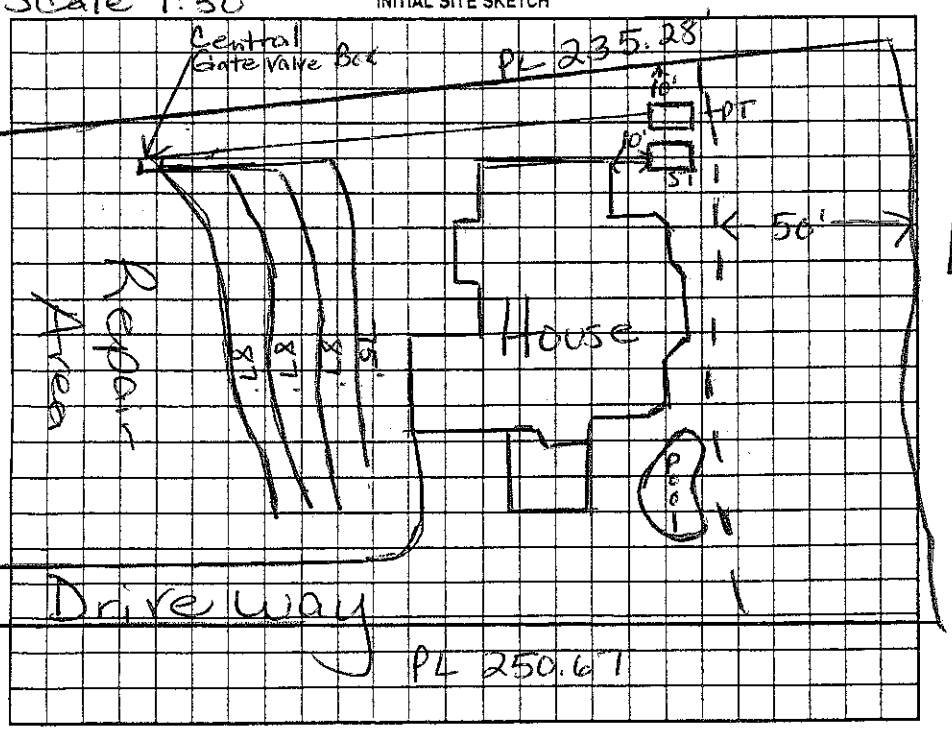

AS BUILT SKETCH

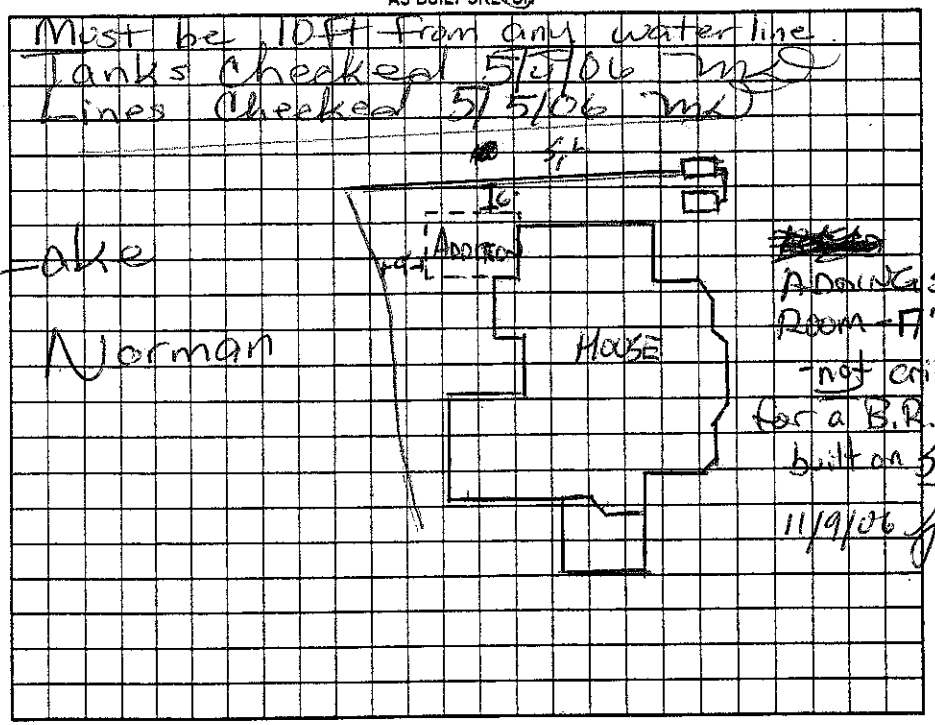

Permit can be suspended or revoked if any false information is supplied toward securing the permit/any unauthorized changes are made to the site/any unauthorized changes are made in the installation of the system. Improvement Permit with plat valid without expiration ☐ Improvement Permit with site plan valid for sixty months ☐ Authorization to Construct is valid for a period equal to that of Improvement Permit – not to exceed sixty months.

Signed: Monica Thomas date 4/27/06 Installed by: R&T RS 7/14/06

Improvement Permit by: Maria H. Dolan RS date 4/24/06 Operation Permit by: Maria H. Dolan date 11/6/06

Authorization to Construct by: Maria H. Dolan RS date 4/24/06 Existing System Inspection by: Joseph E. Alyn date 11/6/06

HEALTH DEPT. COPY: WHITE OWNER COPY (FINAL): YELLOW OWNER COPY (INITIAL): PINK