4625-92-9019 10:00 Fax 799 9373

IREDELL COUNTY HEALTH DEPARTMENT

STATESVILLE 704-878-5305 MOORESVILLE 704-664-5281

IMPROVEMENT PERMIT / AUTHORIZATION TO CONSTRUCT / OPERATION PERMIT / EXISTING SYSTEM INSPECTION

PERMIT# 11895O PIN# 4625834957.1332 Brian Hall DATE 12-19-07

OWNER OR APPLICANT Simonini Builders PHONE: Business 309-3253 Home 358-9940

ADDRESS 1910 S. Blvd Ste #200 Charlotte, NC 28203

LOCATION Brawley School Rd TL Yacht Rd TL Mitford Circle lot on left #197

SUBDIVISION The Point BLOCK / SECTION 13 LOT 1332 LOT AREA 43,048 SITE CLASS. PS DESIGN FLOW Conv. T.A.R. .3

Septic Tank: 1500 Gallons: STB 338 Date 10-17-08

Pump Tank: 1500 Gallons: PT 417 Date 8-4-08

Pump Make: Myers Model ME 50 Serial No.

Nitrification Field: No Fields 4 Square Feet 1005 Linear Feet 335

No Lines 4 Trench Width See Note Max Trench Bottom Depth 36"

☒ New System ☐ Repair ☐ Expansion System Type: I II III IV V VI

System Description: Pump-LP-Panel Blk

Repair System Description: Same

Maintenance Agreement Required: ☒ Yes ☐ No

☒ House/Mod. (Home) ☐ Mobile Home ☐ Business ☐ Other

No. Bedrooms 5 No. Persons No. Employees

Water Supply: ☐ Individual ☐ Public ☐ Community


Gravel Depth N/A ☐ Gravity ☒ Pressure ☐ Slab ☐ Crawl Space ☒ Basement w/plumbing ☐ Basement wo/plumbing

Comments:/Conditions: Note: Use trench width as specified in Crescent Comm. Manual


Comments:/Conditions: ☒ Must Keep Swimming Pool 15Ft from Septic System) 9/9/08 Checked tanks 10/30/08 Checked lines, drilled 3/16"

Scale 1:50

INITIAL SITE SKETCH

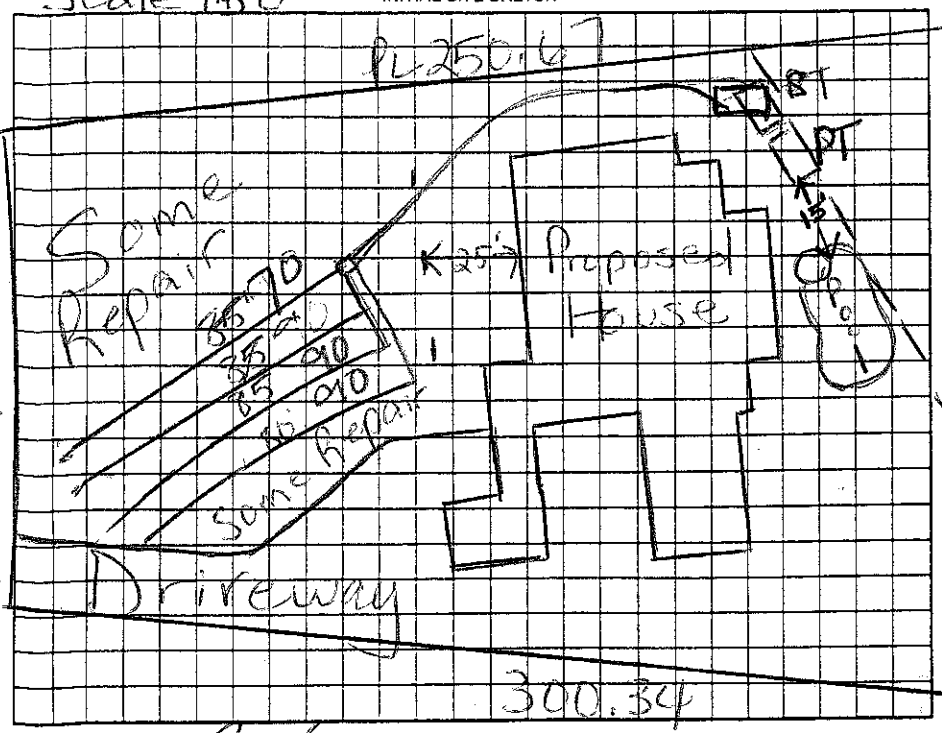

AS BUILT SKETCH

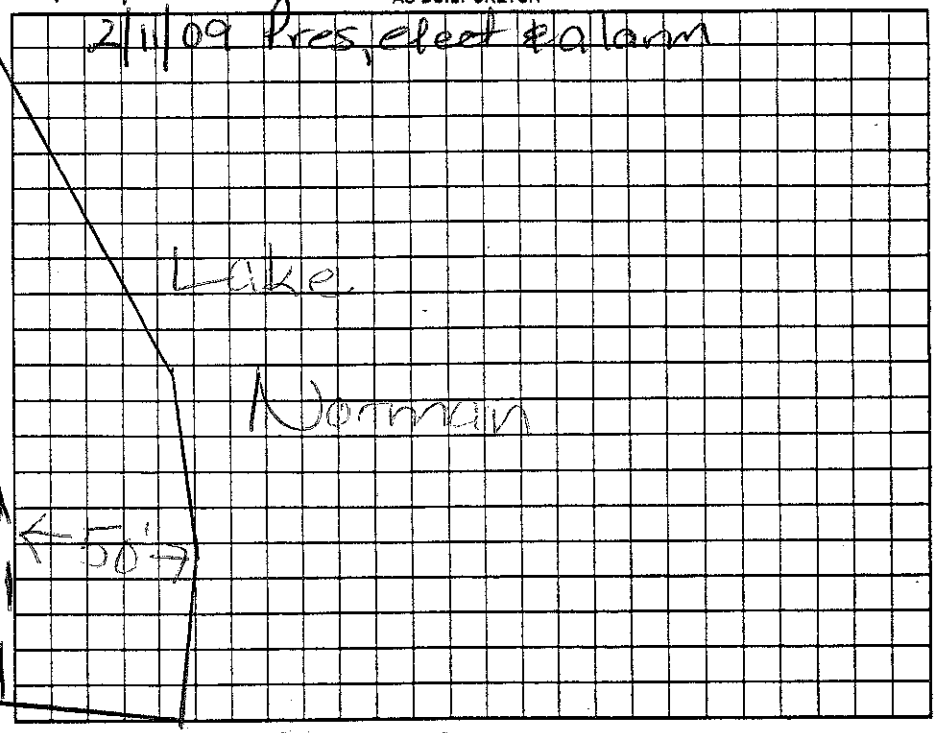

Permit can be suspended or revoked if any false information is supplied toward securing the permit/any unauthorized changes are made to the site/any unauthorized changes are made in the installation of the system. Improvement Permit with plat valid without expiration ☐ Improvement Permit with site plan valid for sixty months ☐ Authorization to Construct is valid for a period equal to that of Improvement Permit – not to exceed sixty months.

Signed: date 12/20/07 Installed by: R & H

Improvement Permit by: Marina H. Dotson RS date 12/19/07 Operation Permit by: Marina H. Dotson RS date 2/11/09

Authorization to Construct by: Marina H. Dotson RS date 12/19/07 Existing System Inspection by: date

HEALTH DEPT. COPY: WHITE OWNER COPY (FINAL): YELLOW OWNER COPY (INITIAL): PINK