IREDELL COUNTY HEALTH DEPARTMENT

STATESVILLE 704-878-5305 MOORESVILLE 704-664-5281

IMPROVEMENT PERMIT / AUTHORIZATION TO CONSTRUCT / OPERATION PERMIT / EXISTING SYSTEM INSPECTION

PERMIT# 071697 PIN# ~~4625941684~~ 4625-93-7906 DATE Aug 4, '98

OWNER OR CONTRACTOR Crescent Resources Hyde, Hughes, Hamblet & Sands PHONE: Business _____ Home _____

ADDRESS P.O. Box 1003, Charlotte

LOCATION Brawley Sch Rd. TL The Pointe Drive, Queen Anne Circle to Vestal Drive immediately on left

SUBDIVISION The Pointe BLOCK / SECTION 1A LOT 61 LOT AREA 42,461 sf SITE CLASS. PS DESIGN FLOW 480gpd L.T.A.R. 0.3

Septic Tank: 1000/500 Gallons; STB 338 Date 1-14-00
Pump Tank: 1000 Gallons; PT 37 Date 2-10-06
Pump Make: Myers Model ME3F-21 Serial No. 2100
Nitrification Field: No. Fields 1 Square Feet 810 Linear Feet 270
No Lines 3@90' Trench Width 36" Max Trench Bottom Depth ~30" Gravel Depth NA

☑ New System ☐ Repair System Type: I, II, III, IV, V, VI
System Description: LP Panel Block
Repair System Description: LP Panel Block
Maintenance Agreement Required: ☑ Yes ☐ No


☑ House/Mod. Home No. Bedrooms 4
☐ Mobile Home No. Bathrooms 4
☐ Business No. Employees
☐ Other

☐ Slab ☑ Crawl Space ☐ Basement w/plumbing ☐ Basement wo/plumbing

Water Supply: ☐ Individual ☑ ~~Public~~ ☐ ~~Community~~

Comments:/Conditions: Remove old Burns/Terraces
Tank location will be changed.

INITIAL SITE SKETCH

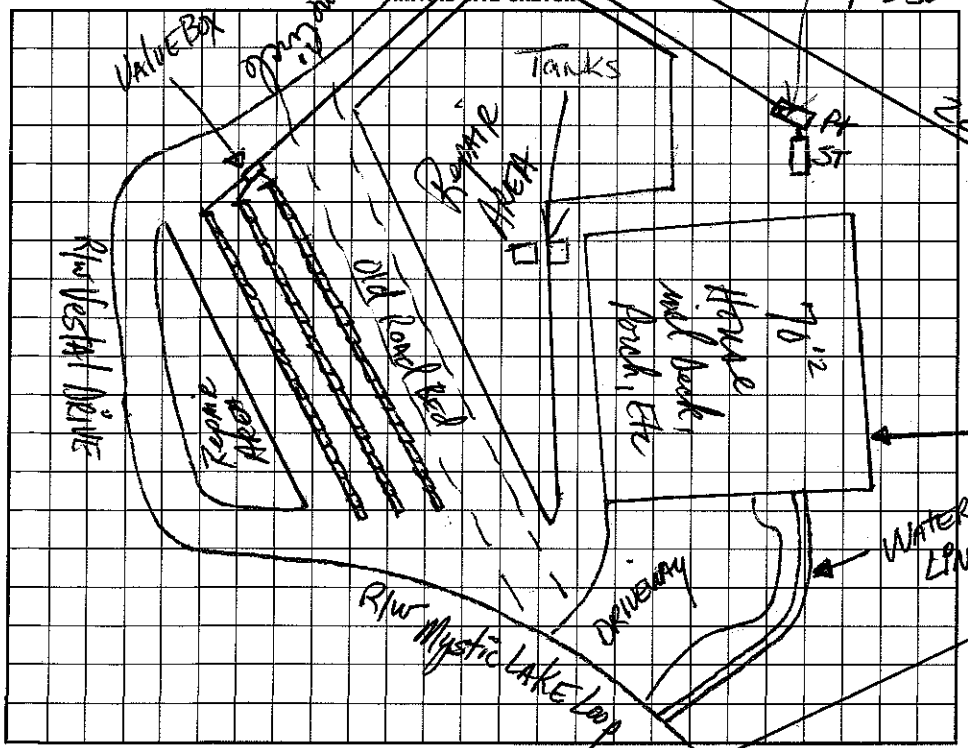

Comments:/Conditions: 8-27-99 Reviewed house & site plan - appears in compliance w/ IP. MH
Lines Checked 3/9/2000 MD
Tanks & ~~Pump~~ Checked 3/31/00
Filter installed.

AS BUILT SKETCH

I understand that this permit can be suspended or revoked if any false information is supplied toward securing the permit/any unauthorized changes are made to the site/any unauthorized changes are made in the installation of the system. Improvement Permit with plat valid without expiration. Improvement Permit with site plan valid for sixty months. Authorization to Construct is valid for a period equal to that of Improvement Permit – not to exceed sixty months.

Signed: _____ date 8-2-99 Installed by: Mayhew Septics

Improvement Permit by: Daniel R. Hinson, RS date 8-4-98 Operation Permit by: _____ date 5/5/2000

Authorization to Construct by: Daniel R. Hinson, RS date 8-27-99 Existing System Inspection by: _____ date _____

HEALTH DEPT. COPY: WHITE INSPECTION COPY (FINAL): GREEN OWNER COPY (FINAL): YELLOW INSPECTION COPY (INITIAL): PINK OWNER COPY (INITIAL): GOLD