IREDELL COUNTY HEALTH DEPARTMENT

STATESVILL +-878-5305 MOORESVILLE 704-664-5281

IMPROVEMENT PERMIT / AUTHORIZATION TO CONSTRUCT / OPERATION PERMIT / EXISTING SYSTEM INSPECTION

PERMIT# 7/693 PIN# 46.2594.6084 4625-93-8277 DATE 9/16/99

OWNER OR CONTRACTOR CRESCENT RESOURCES // Simonini Bld. PHONE: Business Home

ADDRESS PO BOX 1003 CHARLOTTE NC

LOCATION BRAWLEY SCHOOL - TL POINTE DR. - CIRCLE - VESTAL DRIVE - MYSTIC LAKE LOOP

SUBDIVISION POINTE BLOCK / SECTION 1A LOT 57 LOT AREA 83,389 ft² SITE CLASS. PS DESIGN FLOW 720 L.T.A.R. .3

Septic Tank: 1500 Gallons; STB 338 Date 4/10/00

Pump Tank: 1500 Gallons; PT 280 Date 3/16/00

Pump Make: Model Serial No.

Nitrification Field: No Fields 1 Square Feet 1200 Linear Feet

No Lines 7 Trench Width 36" Max Trench Bottom Depth 36" Gravel Depth

☑ New System ☐ Repair System Type: I, II, III, IV, V, VI

System Description: PUMP PANEL

Repair System Description: SAME

Maintenance Agreement Required: ☑ Yes ☐ No

☑ House/Mod. Home No. Bedrooms 6

☐ Mobile Home No. Bathrooms 6

☐ Business No. Employees

☐ Other


☐ Slab ☑ Crawl Space ☑ Basement w/plumbing ☐ Basement wo/plumbing

Water Supply: ☐ Individual ☐ Public ☑ Community


Comments:/Conditions:

Comments:/Conditions: Lines Checked 12/30/99 MD
Wesley checked tanks 5/12/00

INITIAL SITE SKETCH

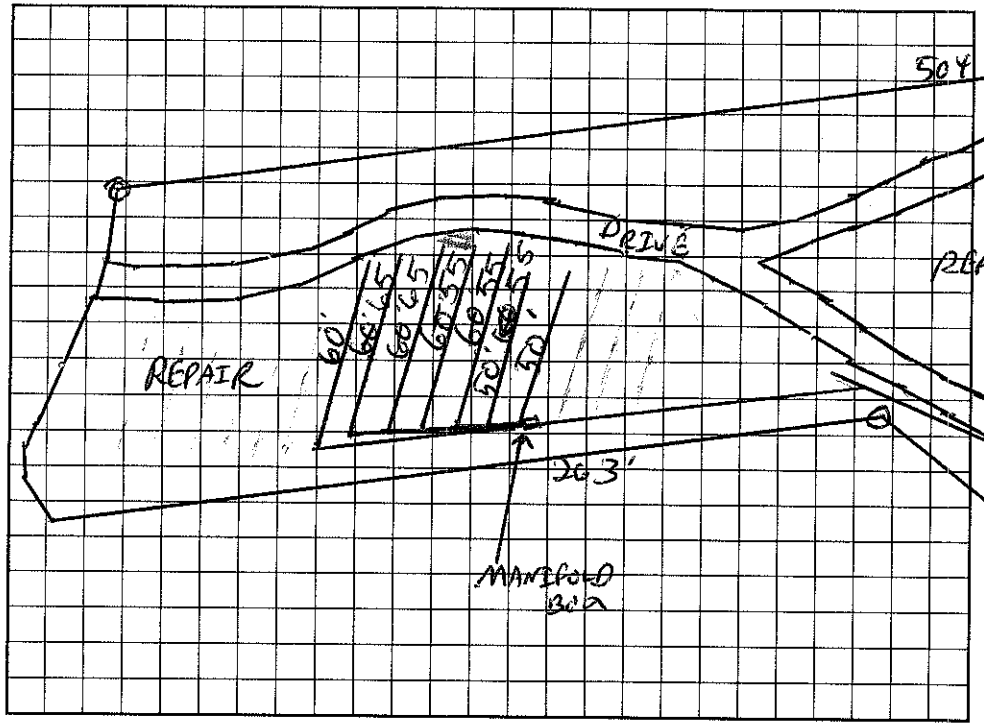

AS BUILT SKETCH

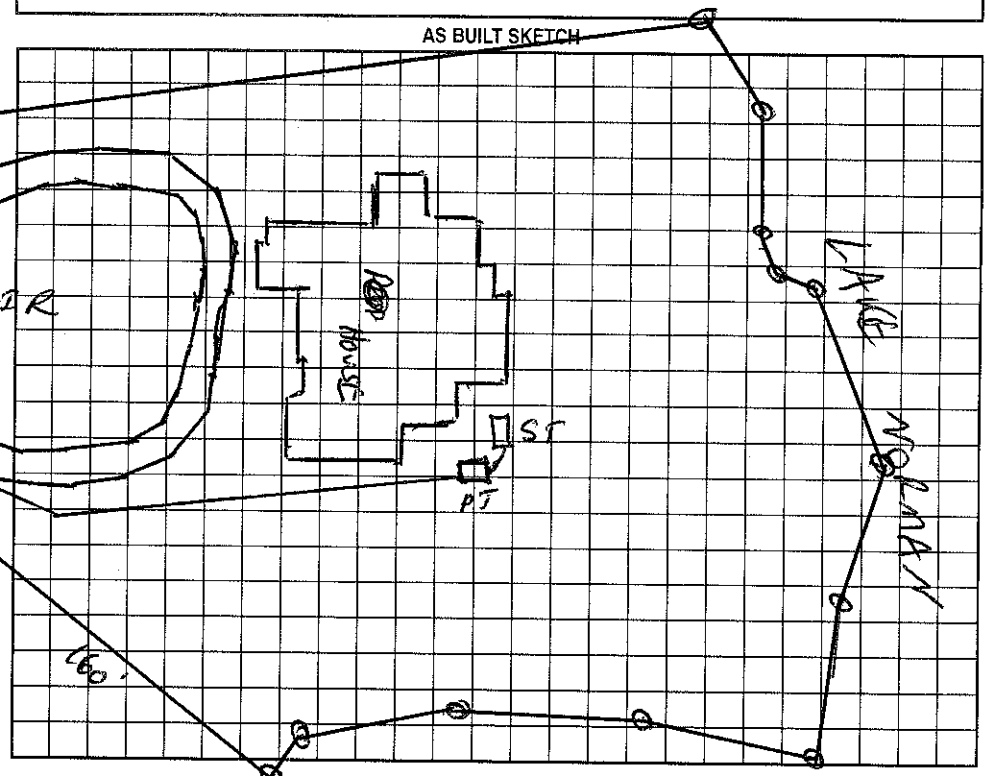

Permit can be suspended or revoked if any false information is supplied toward securing the permit/any unauthorized changes are made to the site/any unauthorized changes are made in the installation of the system. Improvement Permit with plat valid without expiration. Improvement Permit with site plan valid for sixty months. Authorization to Construct is valid for a period equal to that of Improvement Permit – not to exceed sixty months.

Signed: date 9-17-99 Installed by: R+H plumbing

Improvement Permit by: RS date 9/16/99 Operation Permit by: RS date 5/24/2000

Authorization to Construct by: RS date 9/16/99 Existing System Inspection by: date

HEALTH DEPT. COPY: WHITE OWNER COPY (FINAL): YELLOW OWNER COPY (INITIAL): PINK