IREDELL COUNTY HEALTH DEPARTMENT

STATESVILLE 704-878-5305 MOORESVILLE 704-664-5281

IMPROVEMENT PERMIT / AUTHORIZATION TO CONSTRUCT / OPERATION PERMIT / EXISTING SYSTEM INSPECTION

PERMIT# 071698 PIN# ~~4625944684~~ 4625-93-8851 DATE Aug 3, '98

OWNER OR CONTRACTOR Crescent Resources, LLC // Cornerstone Bld. PHONE: Business _____ Home _____

ADDRESS P.O. Box 1003, Charlotte

LOCATION Brawley Sch Rd TL The Pointe DRIVE Queen Anne Circle to Vestal Drive to Mystic Lake Loop

SUBDIVISION The Pointe BLOCK / SECTION 1A LOT 60 LOT AREA 37,595 ft² SITE CLASS. PS DESIGN FLOW 480gpd L.T.A.R. ~.25

Septic Tank: 1000 Gallons; STB _____ Date _____
Pump Tank: 1000 Gallons; PT _____ Date _____
Pump Make: _____ Model _____ Serial No. _____
Nitrification Field: No Fields 1 Square Feet 960 Linear Feet 320
No Lines ~~6~~ 7 Trench Width 36" Max Trench Bottom Depth ~30" Gravel Depth NA

☑ New System ☐ Repair System Type: I, II, III, IV, V, VI
System Description: LP Panel Block
Repair System Description: SAME
Maintenance Agreement Required: ☑ Yes ☐ No


☑ House/Mod. Home No. Bedrooms 4
☐ Mobile Home No. Bathrooms 4
☐ Business No. Employees _____
☐ Other _____
☐ Slab ☑ Crawl Space ☑ Basement w/plumbing ☐ Basement wo/plumbing

Water Supply:
☐ Individual
☑ Public
☑ Community


Comments:/Conditions: Remove old Burns / Terraces
9-21-99 Reviewed house & site plan - appears substantially in compliance w/ I.P. Dept
1"=50'

Comments:/Conditions: (PARTIAL)
11/19/99 - Lines checked.

INITIAL SITE SKETCH

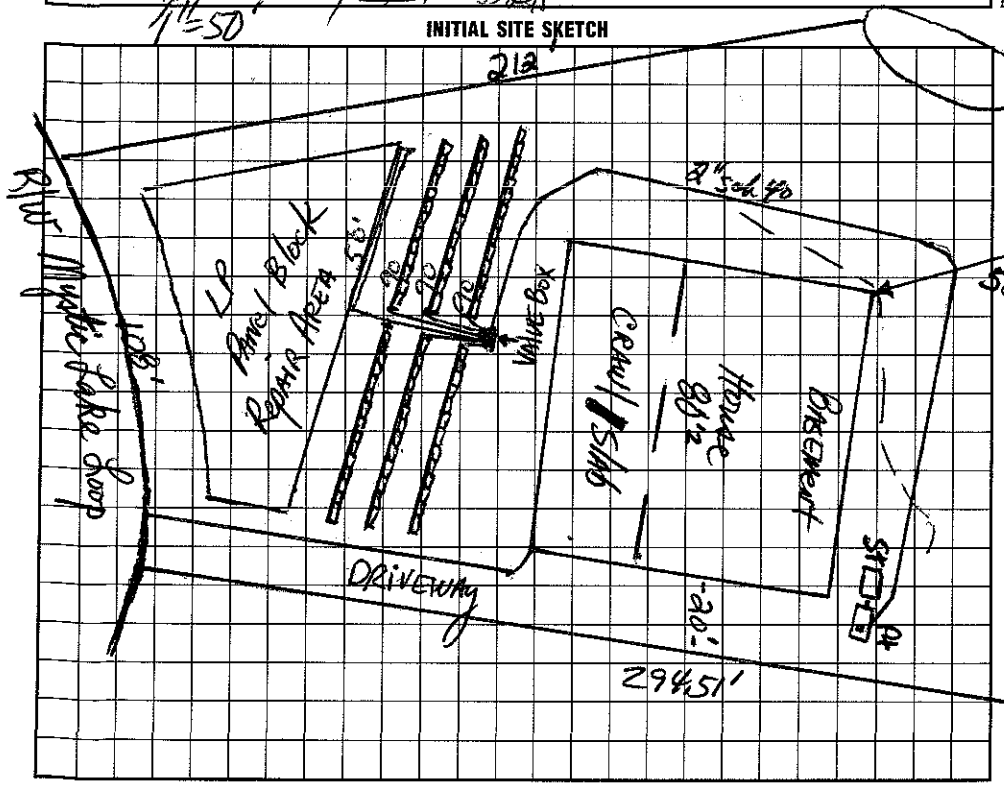

AS BUILT SKETCH

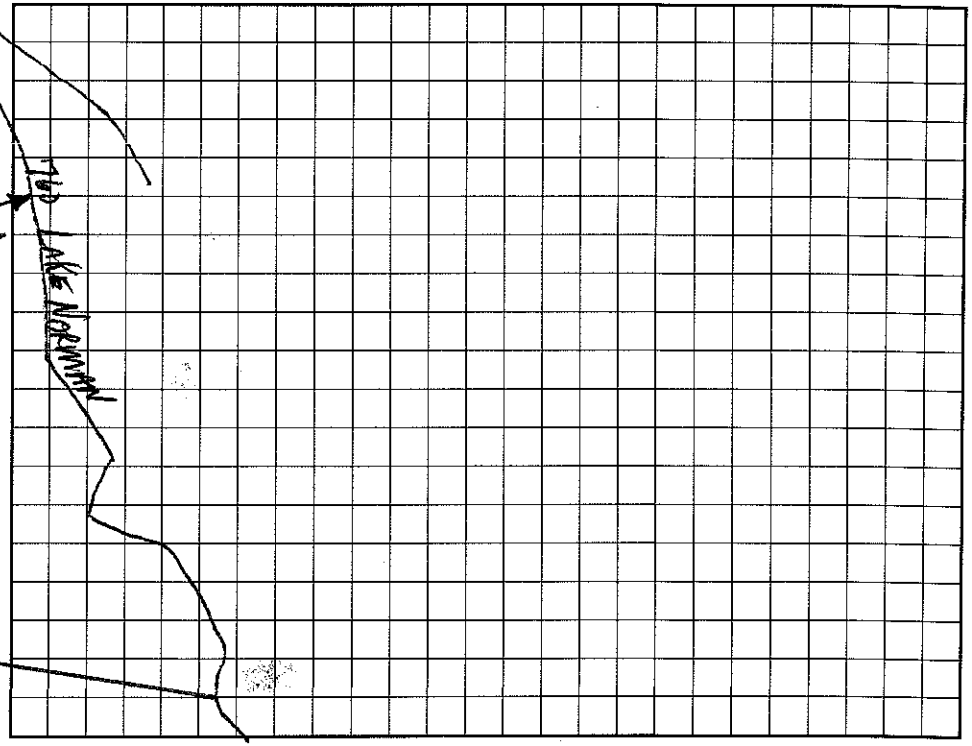

I understand that this permit can be suspended or revoked if any false information is supplied toward securing the permit/any unauthorized changes are made to the site/any unauthorized changes are made in the installation of the system. Improvement Permit with plat valid without expiration. Improvement Permit with site plan valid for sixty months. Authorization to Construct is valid for a period equal to that of Improvement Permit – not to exceed sixty months

Signed: _____ date 8-20-98
Improvement Permit by: _____, RS date 8-3-98
Authorization to Construct by: _____, RS date 9-21-99

Installed by: R+H dug
Operation Permit by: _____, RS. date 5/9/2000
Existing System Inspection by: _____ date _____

HEALTH DEPT. COPY: WHITE INSPECTION COPY (FINAL): GREEN OWNER COPY (FINAL): YELLOW INSPECTION COPY (INITIAL): PINK OWNER COPY (INITIAL): GOLD