IREDELL COUNTY HEALTH DEPARTMENT

#130

STATESVILLE 704-878-5305 MOORESVILLE 704-664-5281 ED

IMPROVEMENT PERMIT / AUTHORIZATION TO CONSTRUCT / OPERATION PERMIT / EXISTING SYSTEM INSPECTION

PERMIT# 111275 PIN# 4625-94-2990 DATE 3-11-03

OWNER OR CONTRACTOR Cresent Resources / Simmonini Build. PHONE: Business 704/663-6905 Home

ADDRESS PO Box 1003 Charlotte NC 28201

LOCATION Brawley Sch, turn on Point Dr. on Lt

SUBDIVISION Point BLOCK / SECTION 1-4 LOT 128 LOT AREA 41,270 ft² SITE CLASS. PS DESIGN FLOW 480 L.T.A.R. 0-3

Septic Tank: 1000 Gallons; STB 338 Date 8-4-03
Pump Tank: 1000 Gallons; PT 283 Date 8-15-03
Pump Make: Goulds Model WE032MV Serial No. 5043580/9
Nitrification Field: No Fields 1 Square Feet 1200 Linear Feet 400
No Lines 3@ 133' Trench Width 36" Max Trench Bottom Depth 36" Gravel Depth —

☒ New System ☐ Repair System Type: I, II, III, IV, V, VI
System Description: Press. Man. 25% Reduct.
Repair System Description: Same / Innovative (Panel)
Maintenance Agreement Required: ☐ Yes ☒ No


☒ House/Mod. Home No. Bedrooms 4
☐ Mobile Home No. Bathrooms 5½
☐ Business No. Employees
☐ Other
☐ Slab ☒ Crawl Space ☐ Basement w/plumbing ☐ Basement wo/plumbing

Water Supply:
☐ Individual
☐ Public
☒ Community


Comments:/Conditions:

Comments:/Conditions: Tanks checked 9/17/03 MB
EZ Flow lines checked 9/25/03

1:40 INITIAL SITE SKETCH

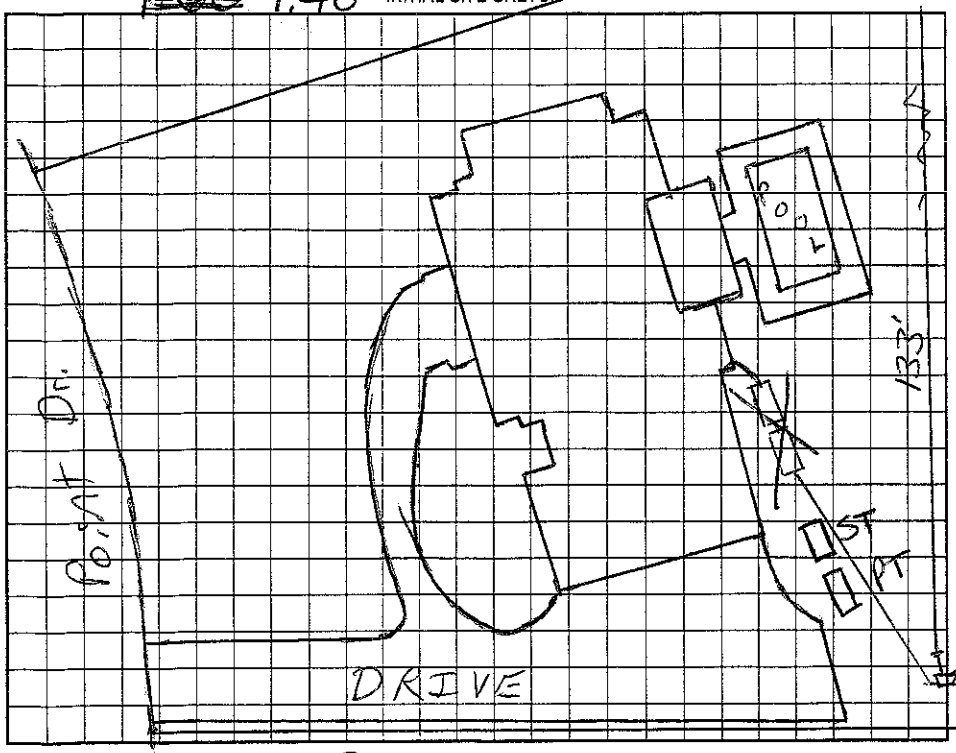

AS BUILT SKETCH

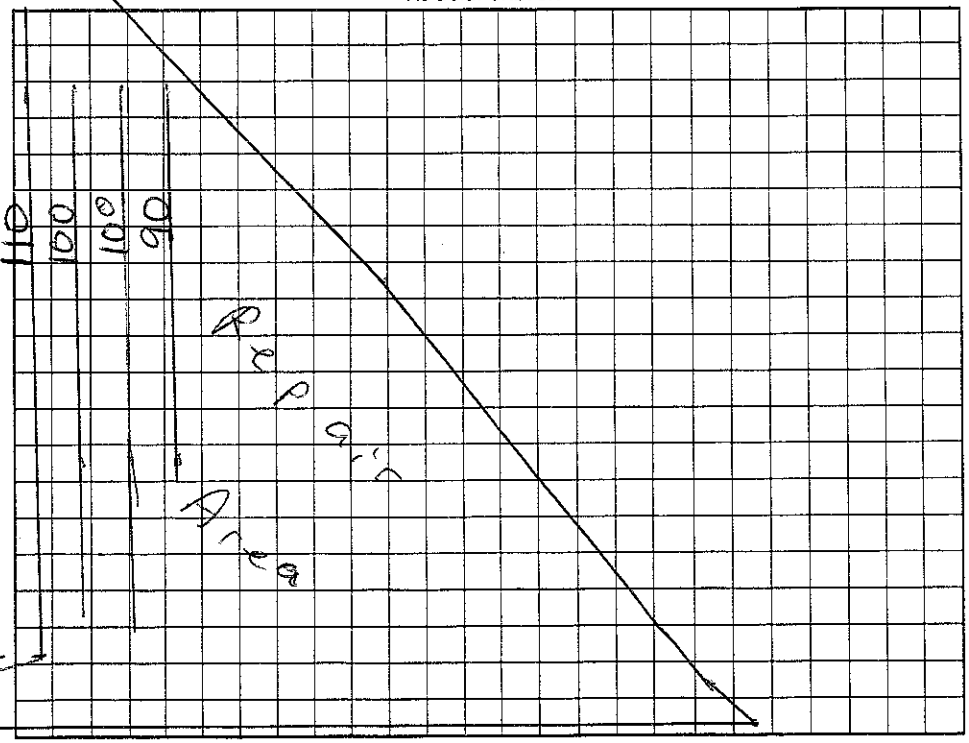

Permit can be suspended or revoked if any false information is supplied toward securing the permit/any unauthorized changes are made to the site/any unauthorized changes are made in the installation of the system. Improvement Permit with plat valid without expiration. Improvement Permit with site plan valid for sixty months. Authorization to Construct is valid for a period equal to that of Improvement Permit – not to exceed sixty months.

Signed: [signature] date 3/11/03 Installed by: R & T Inc

Improvement Permit by: [signature] RS date 3/11/03 Operation Permit by: [signature] date 10/8/03

Authorization to Construct by: [signature] RS date 3/11/03 Existing System Inspection by: date

HEALTH DEPT. COPY: WHITE OWNER COPY (FINAL): YELLOW OWNER COPY (INITIAL): PINK