IREDELL COUNTY HEALTH DEPARTMENT

STATESVILLE 704-878-5305 50.00 Paid MOORESVILLE 704-664-5281

IMPROVEMENT PERMIT / AUTHORIZATION TO CONSTRUCT / OPERATION PERMIT / EXISTING SYSTEM INSPECTION

PERMIT# 071658 PIN# 4625944684 Brian DATE Feb 20, 02

OWNER OR CONTRACTOR CRI // Simonini Builders PHONE: Business 309-3253 Home

ADDRESS 817 E. Morehead St. Charlotte N.C. 28202

LOCATION Brawley School Road Tr The Point Dr. on left just before jct w/ Meeting House

SUBDIVISION The Point BLOCK / SECTION 1A LOT 127 LOT AREA 54,352 ft² SITE CLASS. PB DESIGN FLOW 600 gpd L.T.A.R. .3

Septic Tank: 1500 Gallons; STB Date

Pump Tank: Gallons; PT Date

Pump Make: Model Serial No.

Nitrification Field: No Fields 1 Square Feet 1500 Linear Feet 500

No Lines 10 @ 50'± Trench Width 36" Max Trench Bottom Depth 36" Gravel Depth NR

☑ New System ☐ Repair System Type: I, II, III, IV, V, VI

System Description: Gravity Innovative -25% Red.

Repair System Description: Same or LPP/BS

Maintenance Agreement Required: ☐ Yes ☑ No

☑ House/Mod. Home No. Bedrooms 5

☐ Mobile Home No. Bathrooms 4.5

☐ Business No. Employees

☐ Other

☐ Slab ☑ Crawl Space ☐ Basement w/plumbing ☐ Basement wo/plumbing


Water Supply: ☐ Individual ☑ Public ☐ Community

Comments:/Conditions: Use center-fed distribution (SERIAL) system
This permit Replaces permit issued 8-22-58


Comments:/Conditions:

1"=50'

INITIAL SITE SKETCH

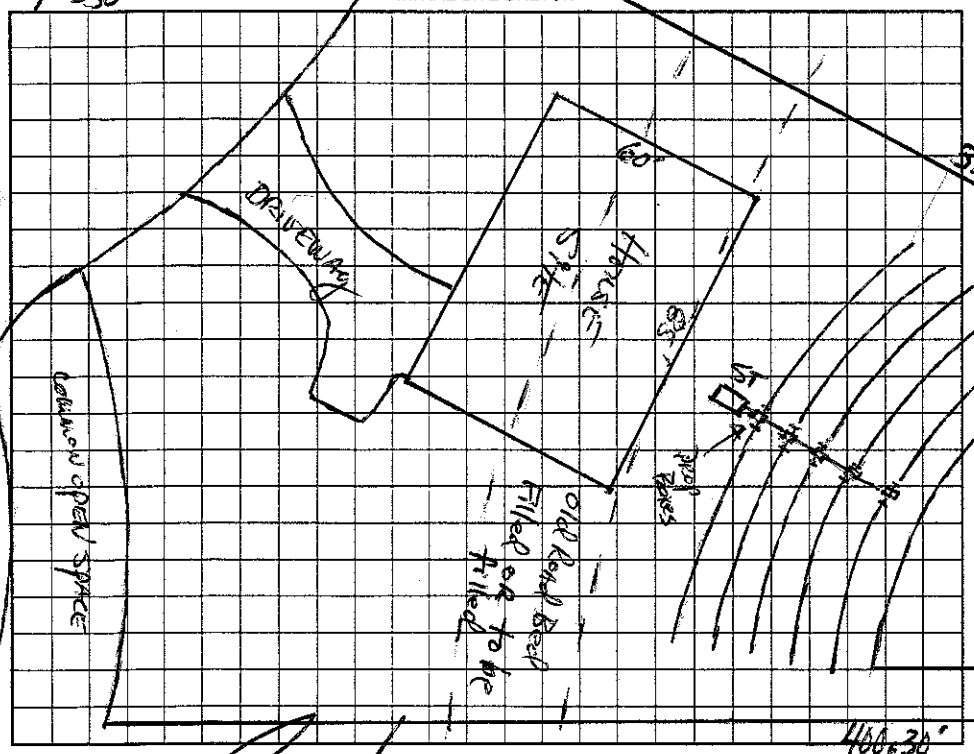

AS BUILT SKETCH

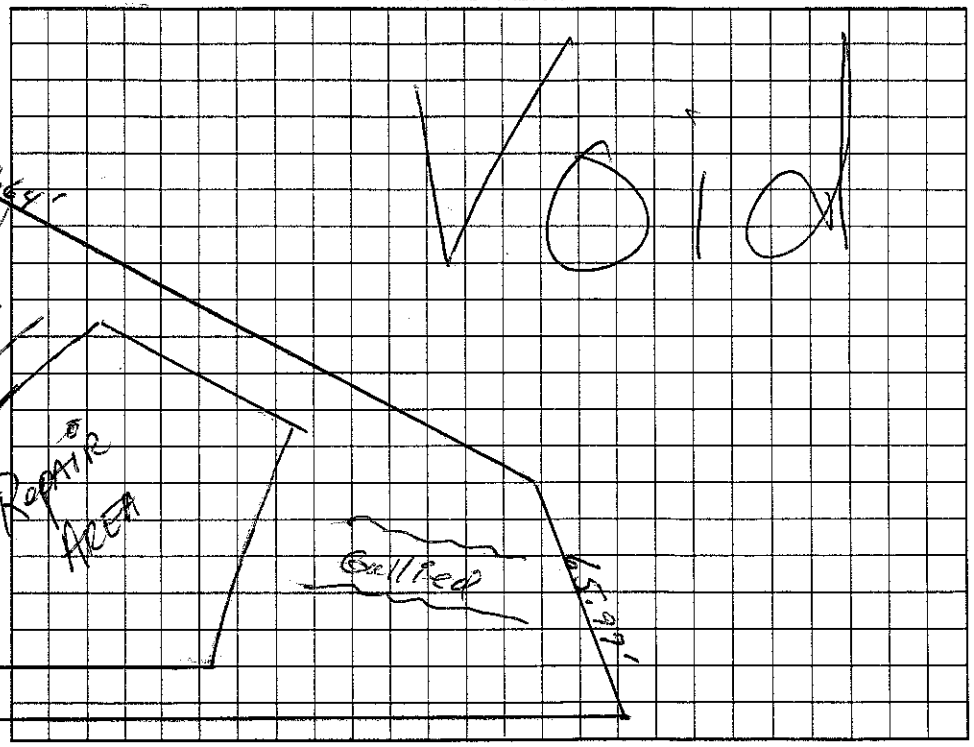

Permit can be suspended or revoked if any false information is supplied toward securing the permit/any unauthorized changes are made to the site/any unauthorized changes are made in the installation of the system. Improvement Permit with plat valid without expiration. Improvement Permit with site plan valid for sixty months. Authorization to Construct is valid for a period equal to that of Improvement Permit – not to exceed sixty months.

Signed: date 3/21/02 Installed by:

Improvement Permit by: date 2-20-02 Operation Permit by: date

Authorization to Construct by: date 2-20-02 Existing System Inspection by: date

HEALTH DEPT. COPY: WHITE OWNER COPY (FINAL): YELLOW OWNER COPY (INITIAL): PINK