...TY HEALTH DEPARTMENT

STATESVILLE 704-878-5305 MOORESVILLE 704-664-5281

...r PERMIT / AUTHORIZATION TO CONSTRUCT / OPERATION PERMIT / EXISTING SYSTEM INSPECTION

2100 - (Stanley)

073405 PIN# 4625941684 (pt.) 4625-94-7366 DATE June 9, '99

FOR Crescent Resources c/o // The Point Woman PHONE: Business 660-1185 Home

LOCATION 2214 Brawley Sch Rd. Brawley Sch Rd. TO Mooresville The Point Dr. Queens Anne Circle to Honeyand Dr.

SUBDIVISION The Point BLOCK / SECTION 1A LOT 53 LOT AREA 31,956 ft² SITE CLASS. PS DESIGN FLOW 480gpd L.T.A.R. = 3 > 36"

Septic Tank: 1600 Gallons; STB 3 Date 3-3-00
Pump Tank: 1500 Gallons; PT Date
Pump Make: Model Serial No.
Nitrification Field: No Fields 1 Square Feet 1200 Linear Feet 400
No Lines 5@80' Trench Width 36" Trench Bottom Depth 48" Gravel Depth NA

☑ New System ☐ Repair System Type: I, II, III, IV, V, VI
System Description: Gravity Innovative-25% Red.
Repair System Description: LPP Innovative-25% Red.
Maintenance Agreement Required: ☐ Yes ☑ No

☑ House/Mod. Home No. Bedrooms 4/4
☐ Mobile Home No. Bathrooms
☐ Business No. Employees
☐ Other
☐ Slab ☑ Crawl Space ☐ Basement w/plumbing ☐ Basement wo/plumbing


Water Supply: ☐ Individual ☑ Public ☐ Community

Comments:/Conditions: Septic System installer note trench bottom depth.
Do not backfill laterals with compacted soil.
1 one inspection port per lateral

Comments:/Conditions:
10-25-99 Reviewed house & site plan - OK to shift to yearly 35' off rear (193.69' side) Keep sidewalk close to house - System should still go in as shown. DPH


1"=50'

INITIAL SITE SKETCH

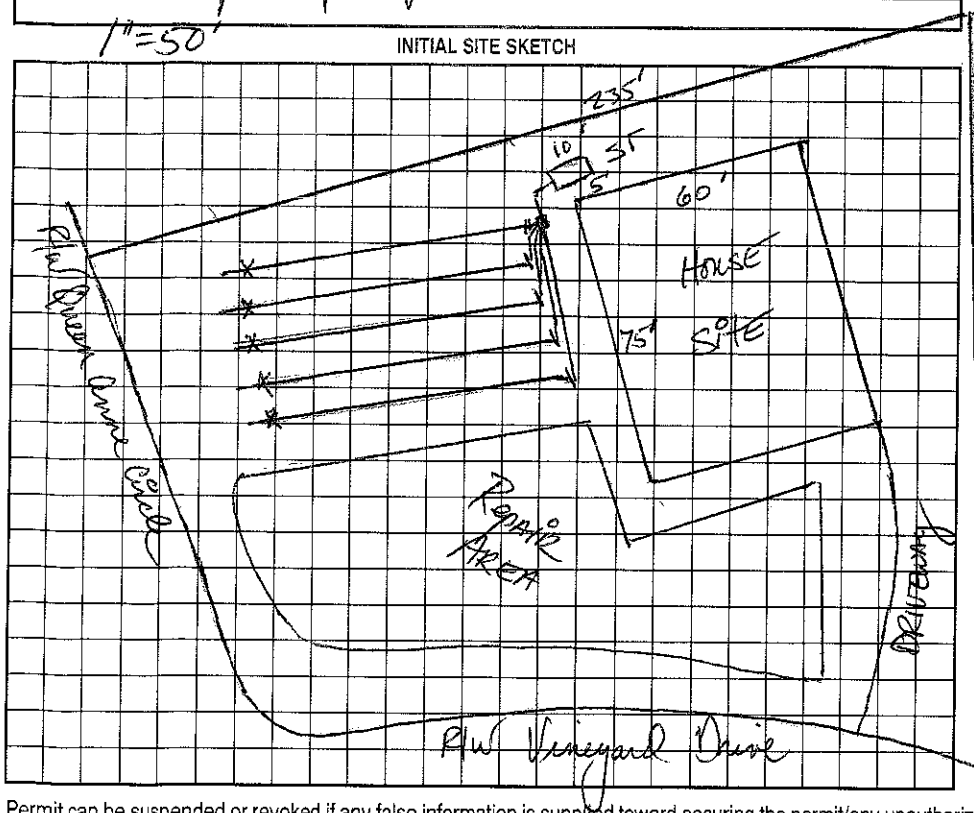

AS BUILT SKETCH

filter & riser mislocated

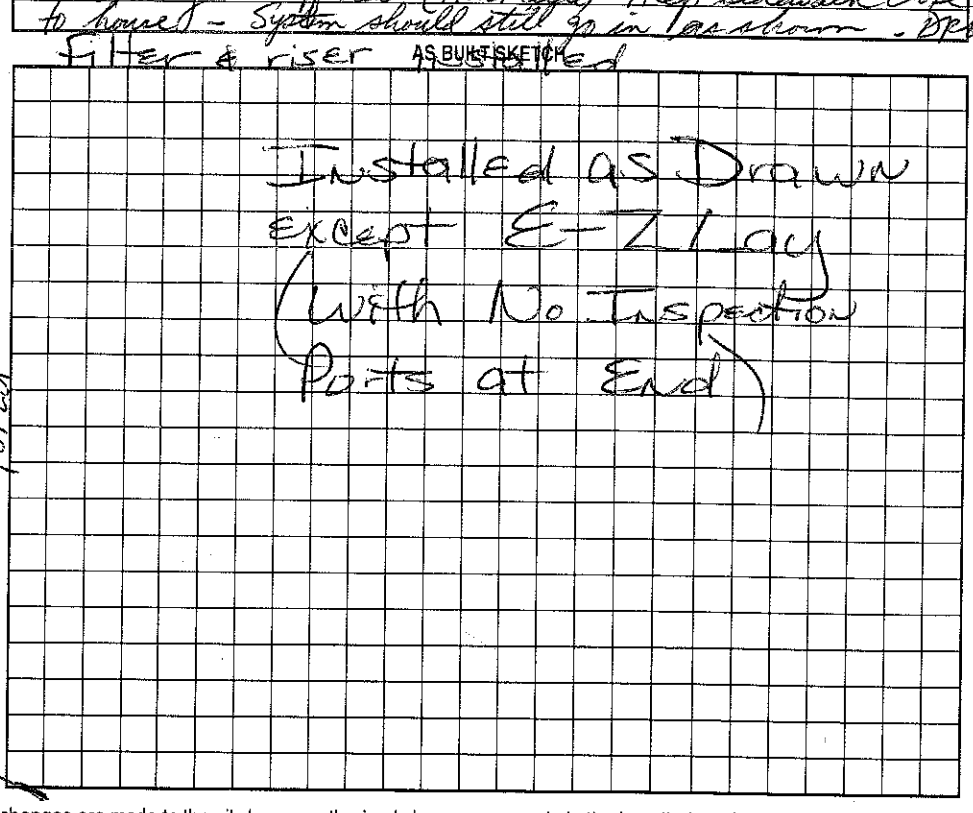

Permit can be suspended or revoked if any false information is supplied toward securing the permit/any unauthorized changes are made to the site/any unauthorized changes are made in the installation of the system. Improvement Permit with plat valid without expiration. Improvement Permit with site plan valid for sixty months. Authorization to Construct is valid for a period equal to that of Improvement Permit – not to exceed sixty months.

Signed: date 6-11-99 Installed by: Stanley Septic RS

Improvement Permit by: RS date 6-9-99 Operation Permit by: RS date 4/20/2000

Authorization to Construct by: RS date 10-25-99 Existing System Inspection by: date

HEALTH DEPT. COPY: WHITE OWNER COPY (FINAL): YELLOW OWNER COPY (INITIAL): PINK