IREDELL COUNTY HEALTH DEPARTMENT

STATESVILLE 704-878-5305 MOORESVILLE 704-664-5281

IMPROVEMENT PERMIT / AUTHORIZATION TO CONSTRUCT / OPERATION PERMIT / EXISTING SYSTEM INSPECTION

PERMIT# 7/656 PIN# 4625941654 4625-94-7932 DATE 8/4/99

OWNER OR CONTRACTOR PATRICK BURKE PHONE: Business Home

ADDRESS

LOCATION BRAWLEY SCHOOL - TL POINTE DR. - QUEEN ANNE CIRCLE - TO EASTON DR ON LT

SUBDIVISION POINTE BLOCK / SECTION 1A LOT 25 LOT AREA 51,422 sq ft SITE CLASS. PS DESIGN FLOW 480GPD L.T.A.R. .3

Septic Tank: ~~1000~~ 1500 Gallons; STB 338 Date 10/15/99

Pump Tank: 1000 Gallons; PT 27 Date 10/1/99

Pump Make: MYERS Model ME-3F Serial No.

Nitrification Field: No Fields 1 Square Feet 1200 Linear Feet 400

No Lines 4 @ 100 Trench Width 36" Max Trench Bottom Depth 36" Gravel Depth

☑ New System ☐ Repair System Type: I, II, (III), IV, V, VI

System Description: PUMP 25% REDUCTION

Repair System Description: SAME

Maintenance Agreement Required: ☐ Yes ☑ No

☑ House/Mod. Home ☐ Mobile Home ☐ Business ☐ Other

No. Bedrooms 4 No. Bathrooms 4 No. Employees

Water Supply: ☐ Individual ☑ Public ☑ Community

☐ Slab ☐ Crawl Space ☑ Basement w/plumbing ☐ Basement wo/plumbing


Comments:/Conditions:

Comments:/Conditions:


ES LAY INSTALLED.

12/29/99 Tanks, Lines, Pressure checked.

INITIAL SITE SKETCH

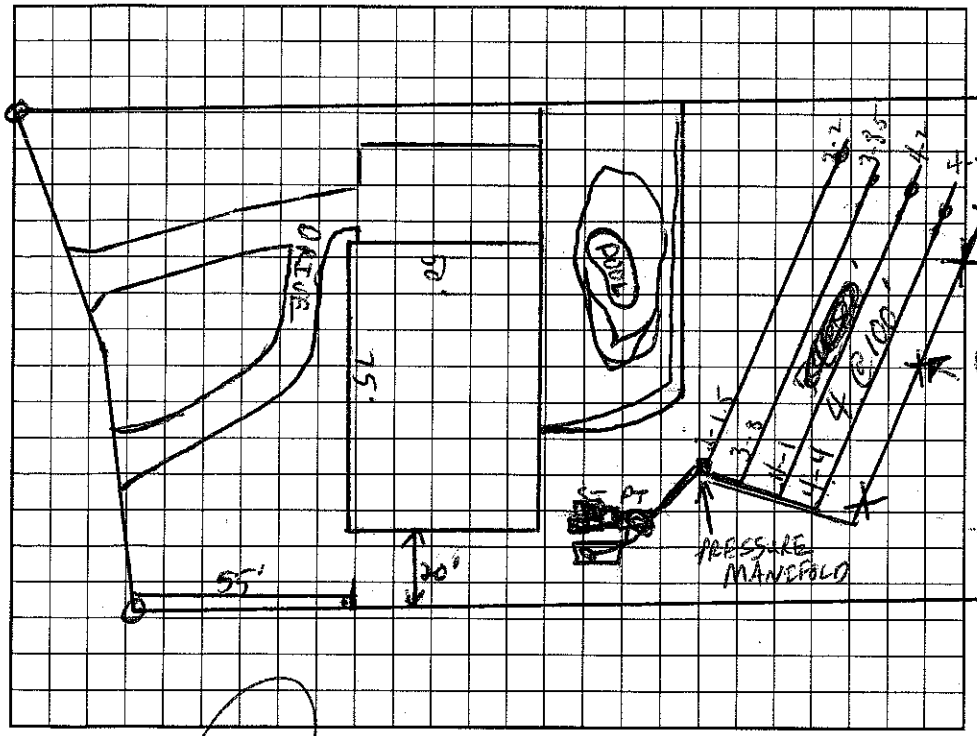

AS BUILT SKETCH

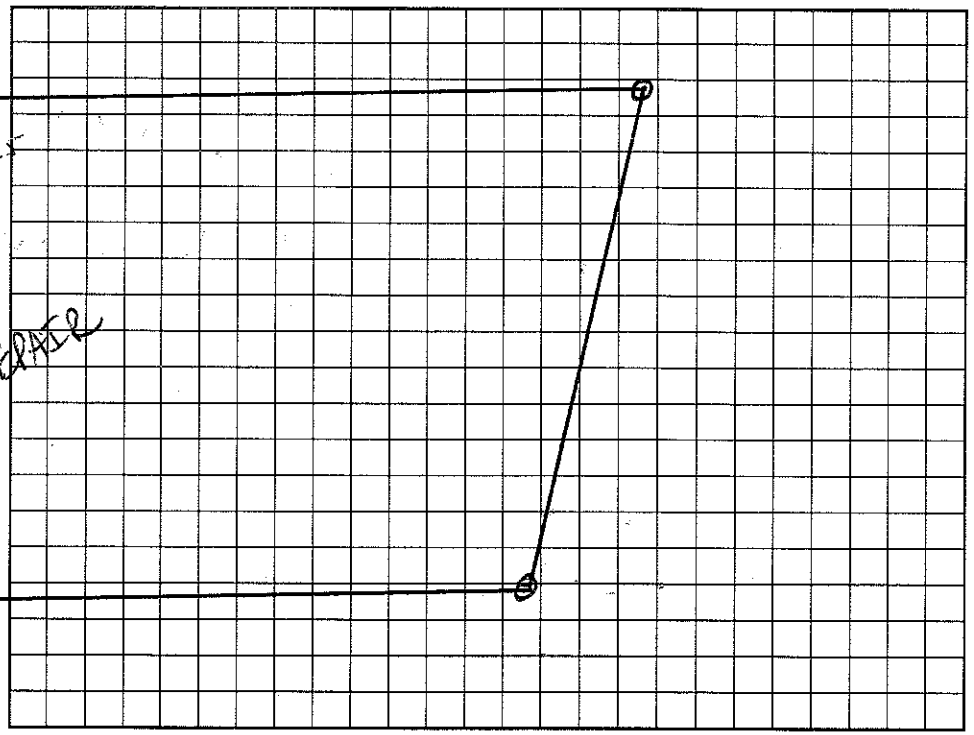

Permit can be suspended or revoked if any false information is supplied toward securing the permit/any unauthorized changes are made to the site/any unauthorized changes are made in the installation of the system. Improvement Permit with plat valid without expiration. Improvement Permit with site plan valid for sixty months. Authorization to Construct is valid for a period equal to that of Improvement Permit – not to exceed sixty months.

Signed: date 4/6/99

Improvement Permit by: C. Myers LS date 4/1/99

Authorization to Construct by: C. Myers LS date 4/1/99

Installed by: Onbyson Const.

Operation Permit by: Wesley Sparks RS. date 3/17/00

Existing System Inspection by: date

HEALTH DEPT. COPY: WHITE OWNER COPY (FINAL): YELLOW OWNER COPY (INITIAL): PINK