IREDELL COUNTY HEALTH DEPARTMENT

STATESVILLE 704-878-5305 MOORESVILLE 704-664-5281

IMPROVEMENT PERMIT / AUTHORIZATION TO CONSTRUCT / OPERATION PERMIT / EXISTING SYSTEM INSPECTION

PERMIT# 071699 PIN# 4625941684 4625 94 8702 DATE Aug 4, '98

OWNER OR CONTRACTOR Crescent Resources dba: Arcadia PHONE: Business Home

ADDRESS P.O. Box 1003, Charlotte

LOCATION Brawley Sch Rd. Tn The Pointe Dr. Queen Anne Circle to Vineyard Dr. immediately on Right

SUBDIVISION The Pointe BLOCK / SECTION 1A LOT 62 LOT AREA 41,334 sf SITE CLASS. PS DESIGN FLOW 480 gpd L.T.A.R. .3

Septic Tank: 1000 1500 Gallons; STB 338 Date 3-23-00

Pump Tank: 1000 Gallons; PT 37 Date 3-7-00

Pump Make: Meyers Model ME 3E Serial No.

Nitrification Field: No Fields 1 Square Feet 1200 Linear Feet 400

No Lines 5@80' Trench Width 36" Max Trench Bottom Depth 36" Gravel Depth N/A

☑ New System ☐ Repair System Type: I, II, (III) IV, V, VI

System Description: pumped-pm - 25% Reduction

Repair System Description: LPP 25-50% Reduction

Maintenance Agreement Required: ☐ Yes ☑ No

☑ House/Mod. Home No. Bedrooms 4

☐ Mobile Home No. Bathrooms 4

☐ Business No. Employees

☐ Other


☐ Slab ☑ Crawl Space ☐ Basement w/plumbing ☐ Basement wo/plumbing

Water Supply: ☐ Individual ☑ Public ☑ Community


Comments/Conditions: * ONE INSPECTION/OBSERVATION PORT PER LATERAL
REMOVE old BERMS/TERRACES

Comments/Conditions: LN Need to install filter
9-2-99 Reviewed house & site plan - appears substantially in compliance w/ I.P. DRAFT
Tanks & lines checked 4/14/2000

INITIAL SITE SKETCH

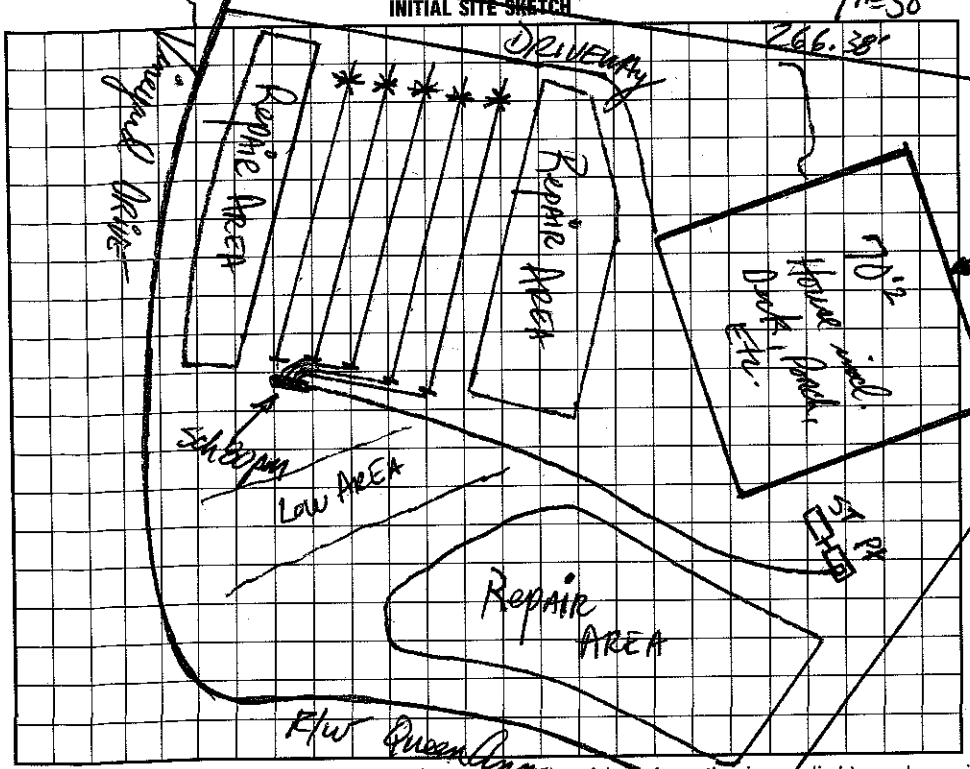

AS BUILT SKETCH

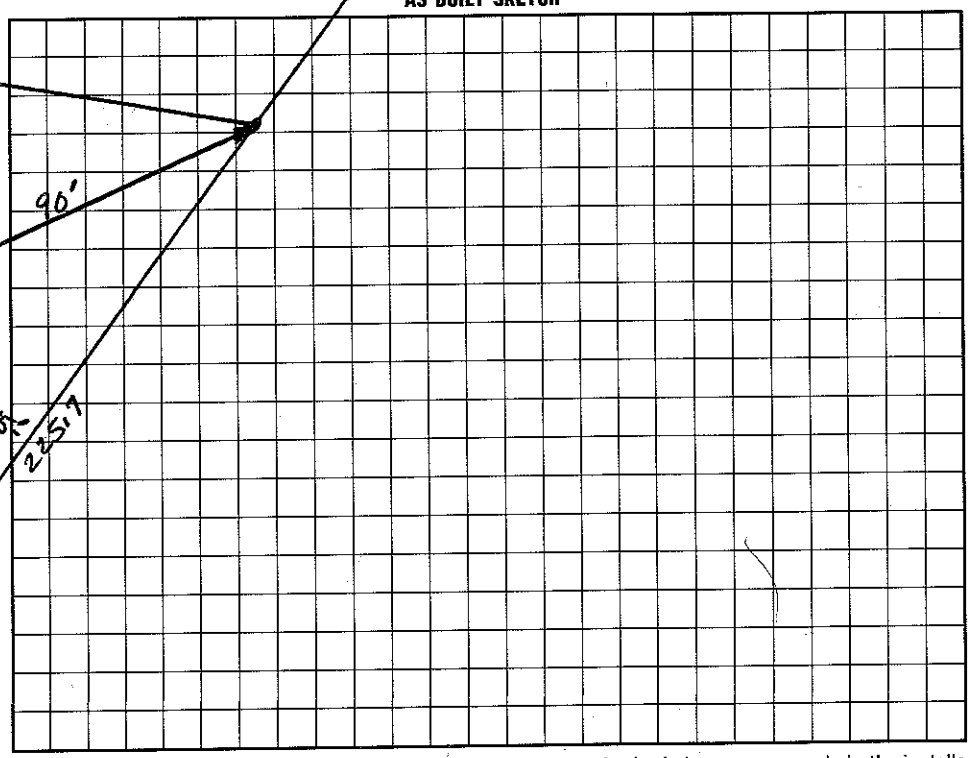

I understand that this permit can be suspended or revoked if any false information is supplied toward securing the permit/any unauthorized changes are made to the site/any unauthorized changes are made in the installation of the system. Improvement Permit with plat valid without expiration; Improvement Permit with site plan valid for sixty months. Authorization to Construct is valid for a period equal to that of Improvement Permit – not to exceed sixty months.

Signed: Paul G. Rogers date 8-20-98

Improvement Permit by: Dana R. Johnson, RS date 8-4-98

Authorization to Construct by: Dana R. Johnson, RS date 9-2-99

Installed by: R & H Inc date

Operation Permit by: Maisie H. Dolan R.S. 5/18/2000

Existing System Inspection by: date

HEALTH DEPT. COPY: WHITE INSPECTION COPY (FINAL): GREEN OWNER COPY (FINAL): YELLOW INSPECTION COPY (INITIAL): PINK OWNER COPY (INITIAL): GOLD