IREDELL COUNTY HEALTH DEPARTMENT

STATESVILLE 704-878-5305 MOORESVILLE 704-664-5281

IMPROVEMENT PERMIT / AUTHORIZATION TO CONSTRUCT / OPERATION PERMIT / EXISTING SYSTEM INSPECT

PERMIT# 07/700 PIN# 46259 46684 4625 94 9064 DATE June 30, '98

OWNER OR CONTRACTOR Crescent Resources, Inc. PHONE: Business Home

ADDRESS PO Box 1003, Charlotte

LOCATION Brawley Sch Rd. TL The Pointe Dr, Queen Anne Circle to Vineyard Drive 2nd Lot on Rt.

SUBDIVISION The Pointe BLOCK / SECTION 1A LOT 63 LOT AREA 34,562 SITE CLASS. PS DESIGN FLOW 480gpd L.T.A.R. .03

Septic Tank: 1000 Gallons; STB 338 Date 4/6/99
Pump Tank: 1000 Gallons; PT 27 Date 9/25/99
Pump Make: MYERS Model ME-100 S-21 Serial No. 9198
Nitrification Field: No Fields 1 Square Feet 1200 Linear Feet 400
No Lines 4@100' Trench Width 36" Max Trench Bottom Depth 36" Gravel Depth N/A

☑ New System ☐ Repair System Type: I, II, III, IV, V, VI
System Description: pumped-pm-25% Reduction
Repair System Description: ~~SAME~~ LP PANEL
Maintenance Agreement Required: ☐ Yes ☑ No

☑ House/Mod. Home No. Bedrooms 4/4
☐ Mobile Home No. Bathrooms 4
☐ Business No. Employees
☐ Other
☐ Slab ☑ Crawl Space ☑ Basement w/plumbing ☐ Basement wo/plumbing


Water Supply: ☐ Individual ☑ Public ☑ Community

Comments:/Conditions: 5-19-99 Reviewed site & house plans - appears substantially in compliance w/ I.P. INSTALLER to shift initial 20' towards street. Tanks to be placed on left side. Repair to be LP Panel Block manifold


Comments:/Conditions: partial

1"=50'

INITIAL SITE SKETCH

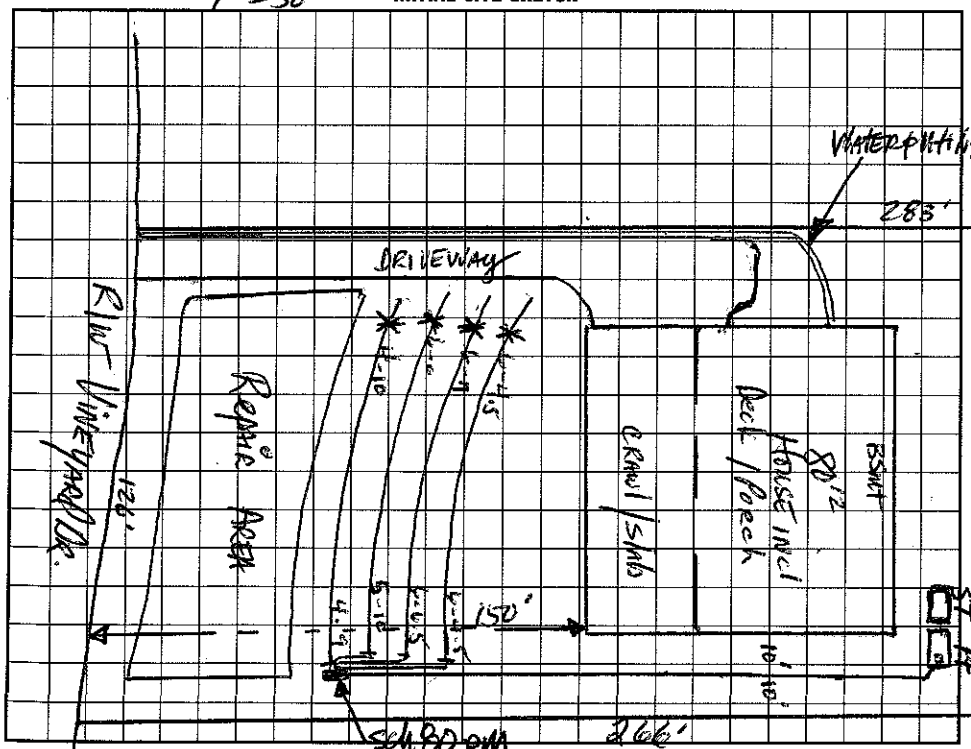

AS BUILT SKETCH

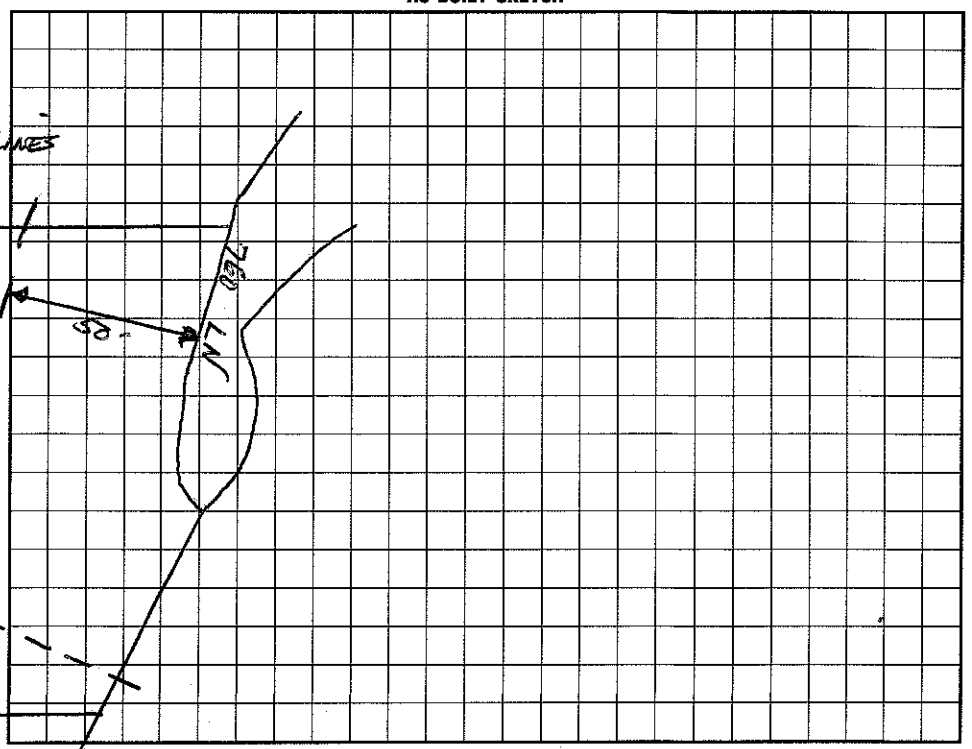

I understand that this permit can be suspended or revoked if any false information is supplied toward securing the permit/any unauthorized changes are made to the site/any unauthorized changes are made in the installation of the system. Improvement Permit with plat valid without expiration. Improvement Permit with site plan valid for sixty months. Authorization to Construct is valid for a period equal to that of Improvement Permit – not to exceed sixty months.

Signed: Patty Pruitt date 8-2-99

Improvement Permit by: Howard Inman RS date 6-30-98

Authorization to Construct by: Howard Inman RS date 5-19-99

Installed by: Orlison Const. Co.

Operation Permit by: Mark H. Dotson RS date 5/19/2000

Existing System Inspection by: date

HEALTH DEPT. COPY: WHITE INSPECTION COPY (FINAL): GREEN OWNER COPY (FINAL): YELLOW INSPECTION COPY (INITIAL): PINK OWNER COPY (INITIAL): GOLD