IREDELL COUNTY HEALTH DEPARTMENT

STATESVILLE 704-878-5305 MOORESVILLE 704-664-528

IMPROVEMENT PERMIT / AUTHORIZATION TO CONSTRUCT / OPERATION PERMIT / EXISTING SYSTEM INSPECT

PERMIT# 073392 / 120637 PIN# 4625 94 4684 4625-94-9631 DATE July 24 '98

OWNER OR CONTRACTOR Crescent Resources, LLC / Courtland Properties PHONE: Business _____ Home _____

ADDRESS PO Box 1003, Charlotte

LOCATION Brawley Sch Rd. TL "The Pointe Dr." take Queen Anne Circle to Easton DRIVE - 2nd on Right

SUBDIVISION The Pointe BLOCK / SECTION 1A LOT 3 LOT AREA 31829 ft² SITE CLASS. PS DESIGN FLOW 480gpd L.T.A.R. .63

Septic Tank: ~~1000~~ 1500 Gallons; STB 797 Date 7/5/04

Pump Tank: _____ Gallons; PT _____ Date _____

Pump Make: _____ Model _____ Serial No. _____

Nitrification Field: No Fields 1 Square Feet 1200 Linear Feet 400

No Lines 5@80' Trench Width 36" Max Trench Bottom Depth 36" Gravel Depth N/A

☑ New System ☐ Repair System Type: I, II, (III), IV, V, VI

System Description: Gravity 25% Reduction

Repair System Description: Grav. Panel Block

Maintenance Agreement Required: ☐ Yes ☑ No

☑ House/Mod. Home No. Bedrooms 4/4

☐ Mobile Home No. Bathrooms

☐ Business No. Employees

☐ Other


☐ Slab ☑ Crawl Space ☐ Basement w/plumbing ☐ Basement wo/plumbing

Water Supply: ☐ Individual ~~☐ Public~~ ☑ Community


Comments:/Conditions: Septic System installers to follow specifications in "The Pointe Wastewater Disposal Manual."
1"=50' * ONE Inspection / observation port per Lateral
Remove old Berms / TERRACES 248'

Comments:/Conditions:
4/19/04 OK house drop boxes or 6" Line; Needed 0.7 DH
8/16/04 EZ FLOW INSTALLED

INITIAL SITE SKETCH

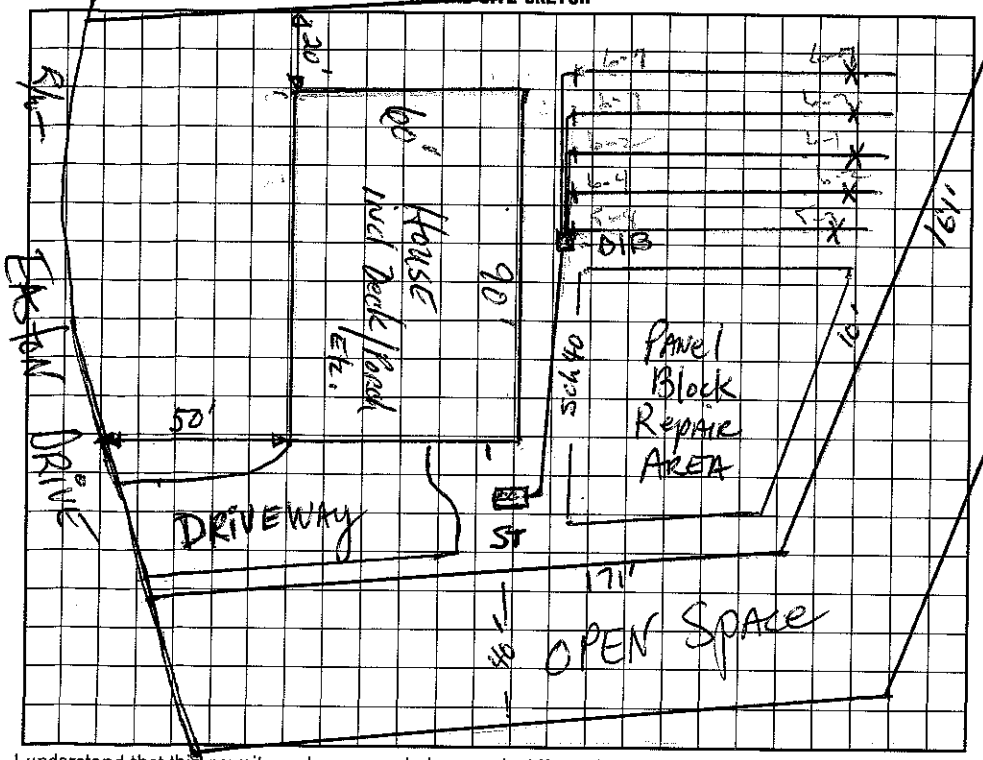

AS BUILT SKETCH

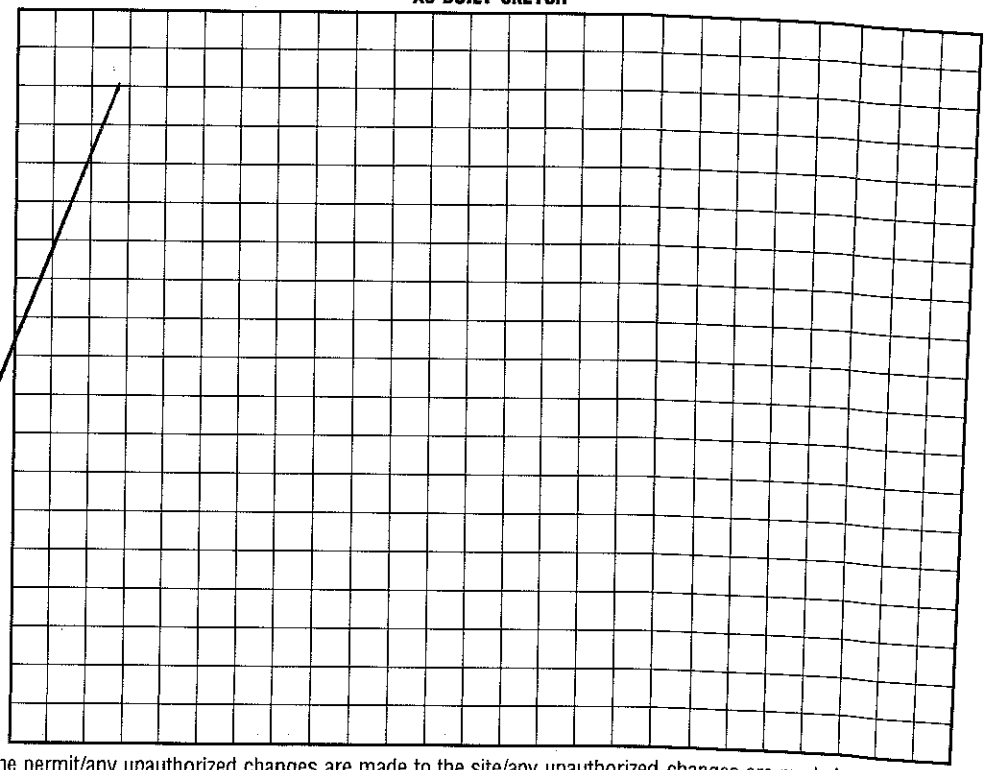

I understand that this permit can be suspended or revoked if any false information is supplied toward securing the permit/any unauthorized changes are made to the site/any unauthorized changes are made in the installation of the system. Improvement Permit with plat valid without expiration. Improvement Permit with site plan valid for sixty months. Authorization to Construct is valid for a period equal to that of Improvement Permit – not to exceed sixty months.

Signed: * Pedro Perez date 8-20-98 Installed by: Stanley Septic

Improvement Permit by: [signature], RS date 7-25-98

Authorization to Construct by: [signature], RS date 4-19-04 Operation Permit by: Wesley Sparks R.S. date 8/16/04

Existing System Inspection by: _____ date _____

HEALTH DEPT. COPY: WHITE INSPECTION COPY (FINAL): GREEN OWNER COPY (FINAL): YELLOW INSPECTION COPY (INITIAL): PINK OWNER COPY (INITIAL): GOLD