IREDELL COUNTY HEALTH DEPARTMENT $130

STATESVILLE 704-878-5305 MOORESVILLE 704-664-5281

IMPROVEMENT PERMIT / AUTHORIZATION TO CONSTRUCT / OPERATION PERMIT / EXISTING SYSTEM INSPECTION

PERMIT# 126711 PIN# 4625 95 1339.000 DATE 4/20/05

OWNER OR CONTRACTOR Point of Norman / David Dobbins PHONE: Business JACOBS 663-6905 Home

ADDRESS PO Box 1003 Charlotte NC. 28201

LOCATION 1100 TL access road before Traffic Circle 2nd lot on (L)

SUBDIVISION Point BLOCK / SECTION ph 1A LOT 131 + 131A AREA .714 + EASEMENT CLASS. PS DESIGN FLOW 480 L.T.A.R. .3

Septic Tank: 1000/500 Gallons; STB 444 Date 11/28/06

Pump Tank: 1000 Gallons; PT 27 Date 11/27/06

Pump Make: Bounds Model WEO-312 Serial No.

Nitrification Field: No Fields 1 Square Feet 1200 Linear Feet 400

No Lines 4@100' Trench Width 3' Max Trench Bottom Depth 3'

☒ New System ☐ Repair System Type: I, II, III, IV, V, VI

System Description: PM → 25% Reduction

Repair System Description: 16" APBPS

Maintenance Agreement Required: ☐ Yes ☒ No

Gravel Depth No

☒ House/Mod. Home No. Bedrooms 4

☐ Mobile Home No. Bathrooms 3

☐ Business No. Employees

☐ Other


☐ Slab ☒ Crawl Space ☐ Basement w/plumbing ☐ Basement wo/plumbing

Water Supply:
☐ Individual
☐ Public
☒ Community
POINT

Comments:/Conditions:

Comments:/Conditions:

(NOT TO SCALE) INITIAL SITE SKETCH

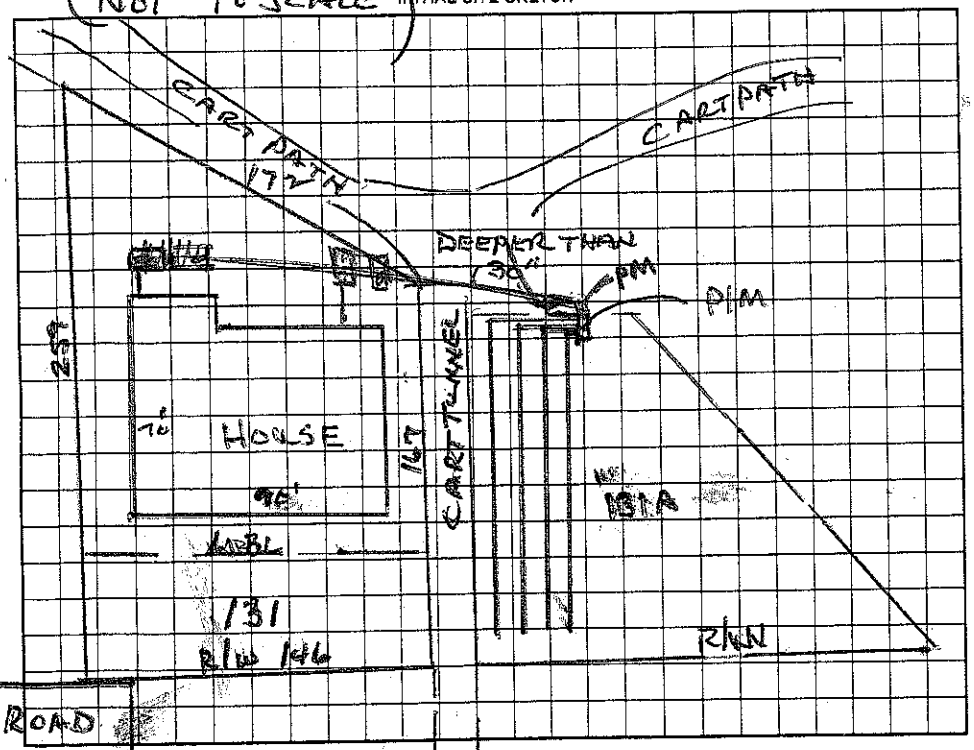

AS BUILT SKETCH

Permit can be suspended or revoked if any false information is supplied toward securing the permit/any unauthorized changes are made to the site/any unauthorized changes are made in the installation of the system. Improvement Permit with plat valid without expiration. Improvement Permit with site plan valid for sixty months. Authorization to Construct is valid for a period equal to that of Improvement Permit – not to exceed sixty months.

Signed: X [signature] RS date 4/20/05

Improvement Permit by: Wesley Sparks R.S. date 4/19/05

Authorization to Construct by: Wesley Sparks RS date 7/20/06

Installed by: Dillingham & Sons

Operation Permit by: Wesley Sparks R.S. date 2/28/07

Existing System Inspection by: date

HEALTH DEPT. COPY: WHITE OWNER COPY (FINAL): YELLOW OWNER COPY (INITIAL): PINK