IREDELL COUNTY HEALTH DEPARTMENT

STATESVILLE 704-878-5305 MOORESVILLE 704-664-5281

IMPROVEMENT PERMIT / AUTHORIZATION TO CONSTRUCT / OPERATION PERMIT / EXISTING SYSTEM INSPECT

PERMIT# 126712 PIN# 4625 95 2467 DATE 2/1/08

OWNER OR APPLICANT Lifestyle Custom Homes PHONE: Business 704-795-1733 Home

ADDRESS 5706 Butch Dixie Concord, NC 28027

LOCATION 1599 Brawley School Rd.

SUBDIVISION POINT BLOCK / SECTION 1A LOT 132 LOT AREA ~1.07Ac SITE CLASS. PS DESIGN FLOW 600 L.T.A.R. .3

Septic Tank: 1500 Gallons: STB 338 Date 11/27/07

Pump Tank: 1500 Gallons: PT 473 Date 2/12/08

Pump Make: Goulds Model WE0712HC Serial No. 08

Nitrification Field: No Fields ___ Square Feet 666 999 Linear Feet 333

No Lines 6 @ 56 Trench Width 2-3' Max Trench Bottom Depth 3'

[X] New System [ ] Repair [ ] Expansion System Type: I II III [IV] V VI

System Description: LP - PPAPS - 50% REDUCTION

Repair System Description: SAME TYPE

Maintenance Agreement Required: [X] Yes [ ] No

[X] House/Mod. Home No. Bedrooms 5

[ ] Mobile Home No. Persons ___

[ ] Business No. Employees ___

[ ] Other ___


Water Supply: [ ] Individual [ ] Public [X] Community POINT

Gravel Depth No [ ] Gravity [X] Pressure [ ] Slab [X] Crawl Space [ ] Basement w/plumbing [ ] Basement wo/plumbing


Comments/Conditions: SIM TECH FILTER REQUIRED.

Comments/Conditions: 3/16" holes; Electrical checked 4/25/08

INITIAL SITE SKETCH

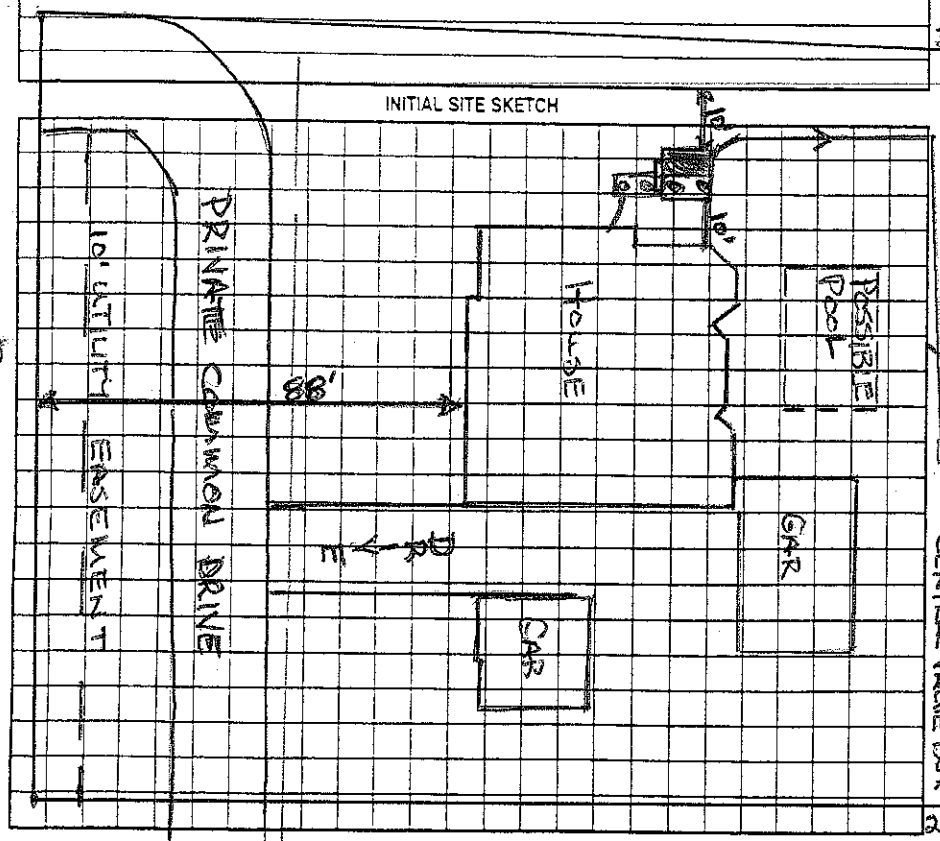

AS BUILT SKETCH

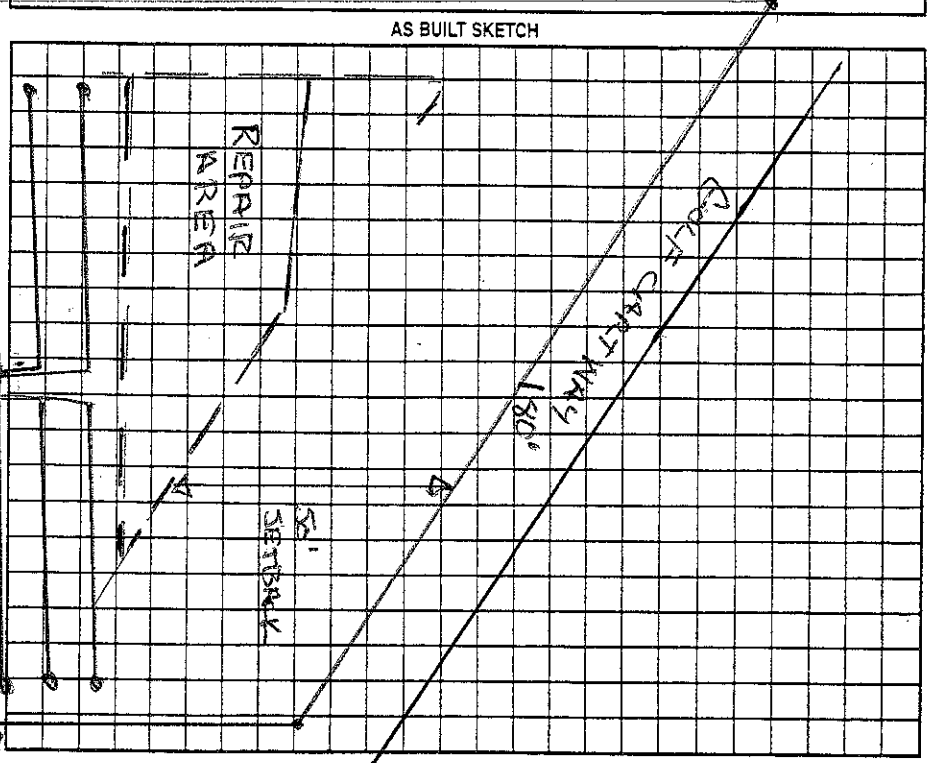

BRAWLEY SCHOOL RD.

Permit can be suspended or revoked if any false information is supplied toward securing the permit/any unauthorized changes are made to the site/any unauthorized changes are made in the installation of the system. Improvement Permit with plat valid without expiration ☐ Improvement Permit with site plan valid for sixty months ☐ Authorization to Construct is valid for a period equal to that of Improvement Permit – not to exceed sixty months.

Signed: [signature] date 2/26/08

Improvement Permit by: Wesley Sparks R.S. date 2/1/08

Authorization to Construct by: Wesley Sparks R.S. date 2/1/08

Installed by: Kevin Hardman

Operation Permit by: Anthony Cobos Jr date 4/25/08

Existing System Inspection by: ___ date ___

HEALTH DEPT. COPY: WHITE OWNER COPY (FINAL): YELLOW OWNER COPY (INITIAL): PINK