IREDELL COUNTY HEALTH DEPARTMENT

STATESVILLE 704-878-5305 MOORESVILLE 704-664-5281

IMPROVEMENT PERMIT / AUTHORIZATION TO CONSTRUCT / OPERATION PERMIT / EXISTING SYSTEM INSPECTION

375.00 Pd. 11.00

PERMIT# 139467 PIN# 4625953597 DATE 11-29-06

OWNER OR APPLICANT Augusta Homes Inc PHONE: Business 892-7795 Home

ADDRESS 10602 J Bailey Road Ste B Cornelius, NC 28031

LOCATION Brawley School Rd on left before Circle

SUBDIVISION Point BLOCK / SECTION 1-B LOT 1 LOT AREA 1.328 Acre SITE CLASS. PS DESIGN FLOW 600gpd L.T.A.R. .3

Septic Tank: 1500 Gallons: STB 338 Date 11-27-07

Pump Tank: 1500 Gallons: PT 477 Date 9-2-07

Pump Make: Myers Model ME50 Serial No.

Nitrification Field: No Fields 1 Square Feet 999 Linear Feet 333

No Lines 3@111ft Trench Width See plan Max Trench Bottom Depth 36" Gravel Depth N/A

☒ New System ☐ Repair ☐ Expansion System Type: I II III IV V VI

System Description: LP-Panel Block

Repair System Description: Same

Maintenance Agreement Required: ☒ Yes ☐ No

☒ House/Mod. Home No. Bedrooms 5

☐ Mobile Home No. Persons

☐ Business No. Employees

☐ Other

Water Supply: ☐ Individual ☒ Public ☒ Community

☐ Gravity ☐ Pressure ☐ Slab ☐ Crawl Space ☐ Basement w/plumbing ☐ Basement wo/plumbing


Comments:/Conditions: Center Feed

* See attached/approved plan by SAME

4/11/08 Checked - tanks & lines

Scale 1:50

INITIAL SITE SKETCH

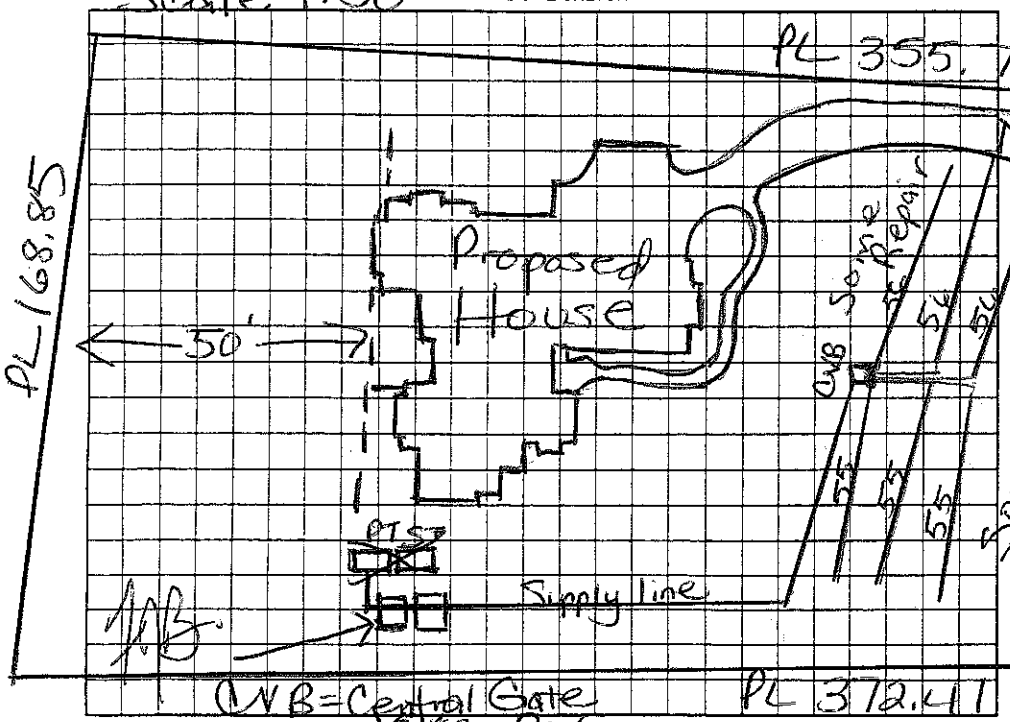


Comments:/Conditions: Reviewed plans, essentially in compliance with I.P.

3/16" hole drilled

4/24/08 Pressure, float & alarm

AS BUILT SKETCH

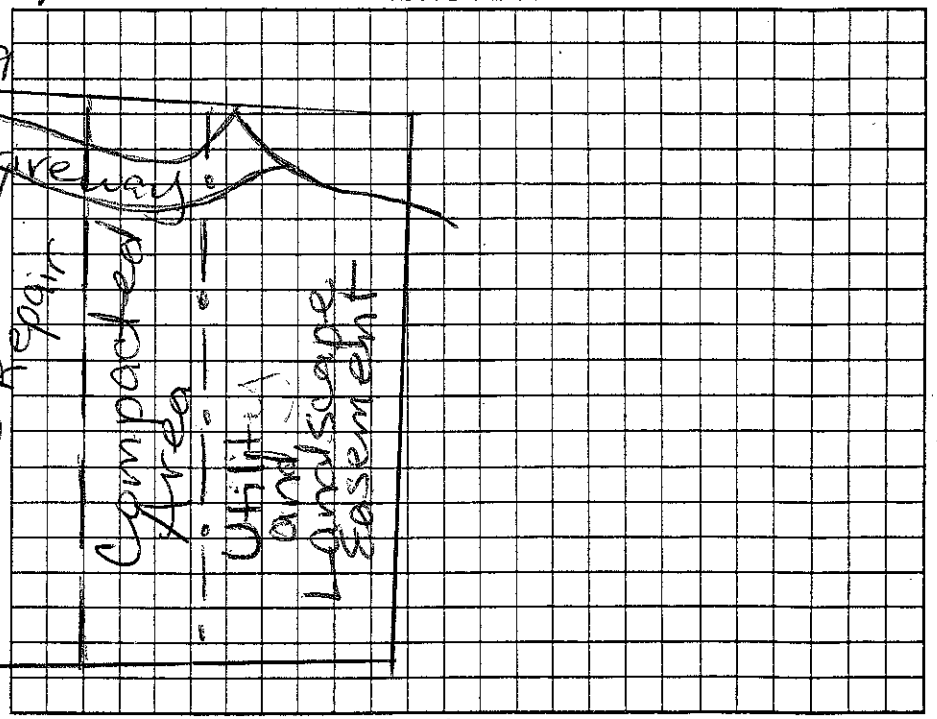

Permit can be suspended or revoked if any false information is supplied toward securing the permit/any unauthorized changes are made to the site/any unauthorized changes are made in the installation of the system. Improvement Permit with plat valid without expiration ☐ Improvement Permit with site plan valid for sixty months ☐ Authorization to Construct is valid for a period equal to that of Improvement Permit – not to exceed sixty months.

Signed: [signature] RS date 11/30/06 Installed by: R&L

Improvement Permit by: Maina M. Dolan RS date 11/29/06 Operation Permit by: Maina M. Dolan RS date 4/24/08

Authorization to Construct by: Maina M. Dolan RS date 11/30/06 Existing System Inspection by: date

HEALTH DEPT. COPY: WHITE OWNER COPY (FINAL): YELLOW OWNER COPY (INITIAL): PINK