IREDELL COUNTY HEALTH DEPARTMENT

Statesville Office (704) 878-5305 Mooresville Office (704) 660-3625 AP PERMIT # 209431 ✓

IMPROVEMENT PERMIT / AUTHORIZATION TO CONSTRUCT / OPERATION PERMIT / EXISTING SYSTEM

PIN # 4625953597 ✓

APPLICANT: Michael Dotson/Lake Vision Dev. APPLICANT ADDRESS: 8915 Warwick Ln. Sherrills Ford, NC 28673

SITE ADDRESS: 1881 Brawley School Rd Mooresville, NC PHONE: 704 506-0807 ALT. PHONE: 704 576-3887

SITE DIRECTIONS: Brawley School Rd II before traffic circle

SUBDIVISION: The Point On Norman SECTION: B LOT # 1 LOT AREA: 1.16 Ac DESIGN FLOW: 600gpd L.T.A.R.: .3

Existing / Existing

Septic Tank 1500 (gal) STB Date

Pump Tank 1500 (gal) PT Date

Pump Make Model Serial #

Nitrification Fields 1 # Lines 3 Linear Ft: 333

Trench Width 36" Max. Trench Bottom Depth 36" Gravel Depth N/A

☐ New System ☐ Repair ☐ Expansion System Type: I II III IV V VI

System Description: LP- Panel Block

Repair System Description: Same

Maintenance Agreement Required: ☒ YES ☐ NO

☐ GRAVITY ☒ PRESSURE

☒ Residence No. Bedrooms 5

☐ Business No. Persons

☐ Other No. Employees

☐ Slab ☐ Crawl Space

☐ Basement w/plumbing ☐ Basement w/o plumbing

Water Supply: ☐ Private ☒ Public ☒ Community

Comments / Conditions: Existing Septic "appears" to be functioning OK at the time of inspection

The proposed Patio/outdoor living area does not appear to impact the existing Septic System.

INITIAL SITE SKETCH

See attached/approved plan by Michael Athanas (rec 4/20/2015)

AS BUILT SKETCH

Permit can be suspended or revoked if any false information is supplied toward securing the permit / any unauthorized changes are made to the site / any unauthorized changes are made in the installation of the system. **CONTACT A LOCATOR SERVICE PRIOR TO ANY EXCAVATION**


☐ **IMPROVEMENT PERMIT** *with plat valid without expiration.* ☐ **IMPROVEMENT PERMIT** *with site plan valid for 60 mos.* ☐ **AUTHORIZATION TO CONSTRUCT** *valid for period equal to IMPROVEMENT PERMIT--not to exceed 60 mo.*

Owner / Applicant Signature: SBishop Date: 5-4-15 Installed by:

IMPROVEMENT PERMIT by: Date: OPERATION PERMIT by: Date:

AUTHORIZATION TO CONSTRUCT by: Date: Existing System Inspected by: Mark Dotson RS Date: 5/1/15

Health Dept. Copy - WHITE Applicant (Final Approval) - YELLOW Applicant (Conditional Approval) - PINK

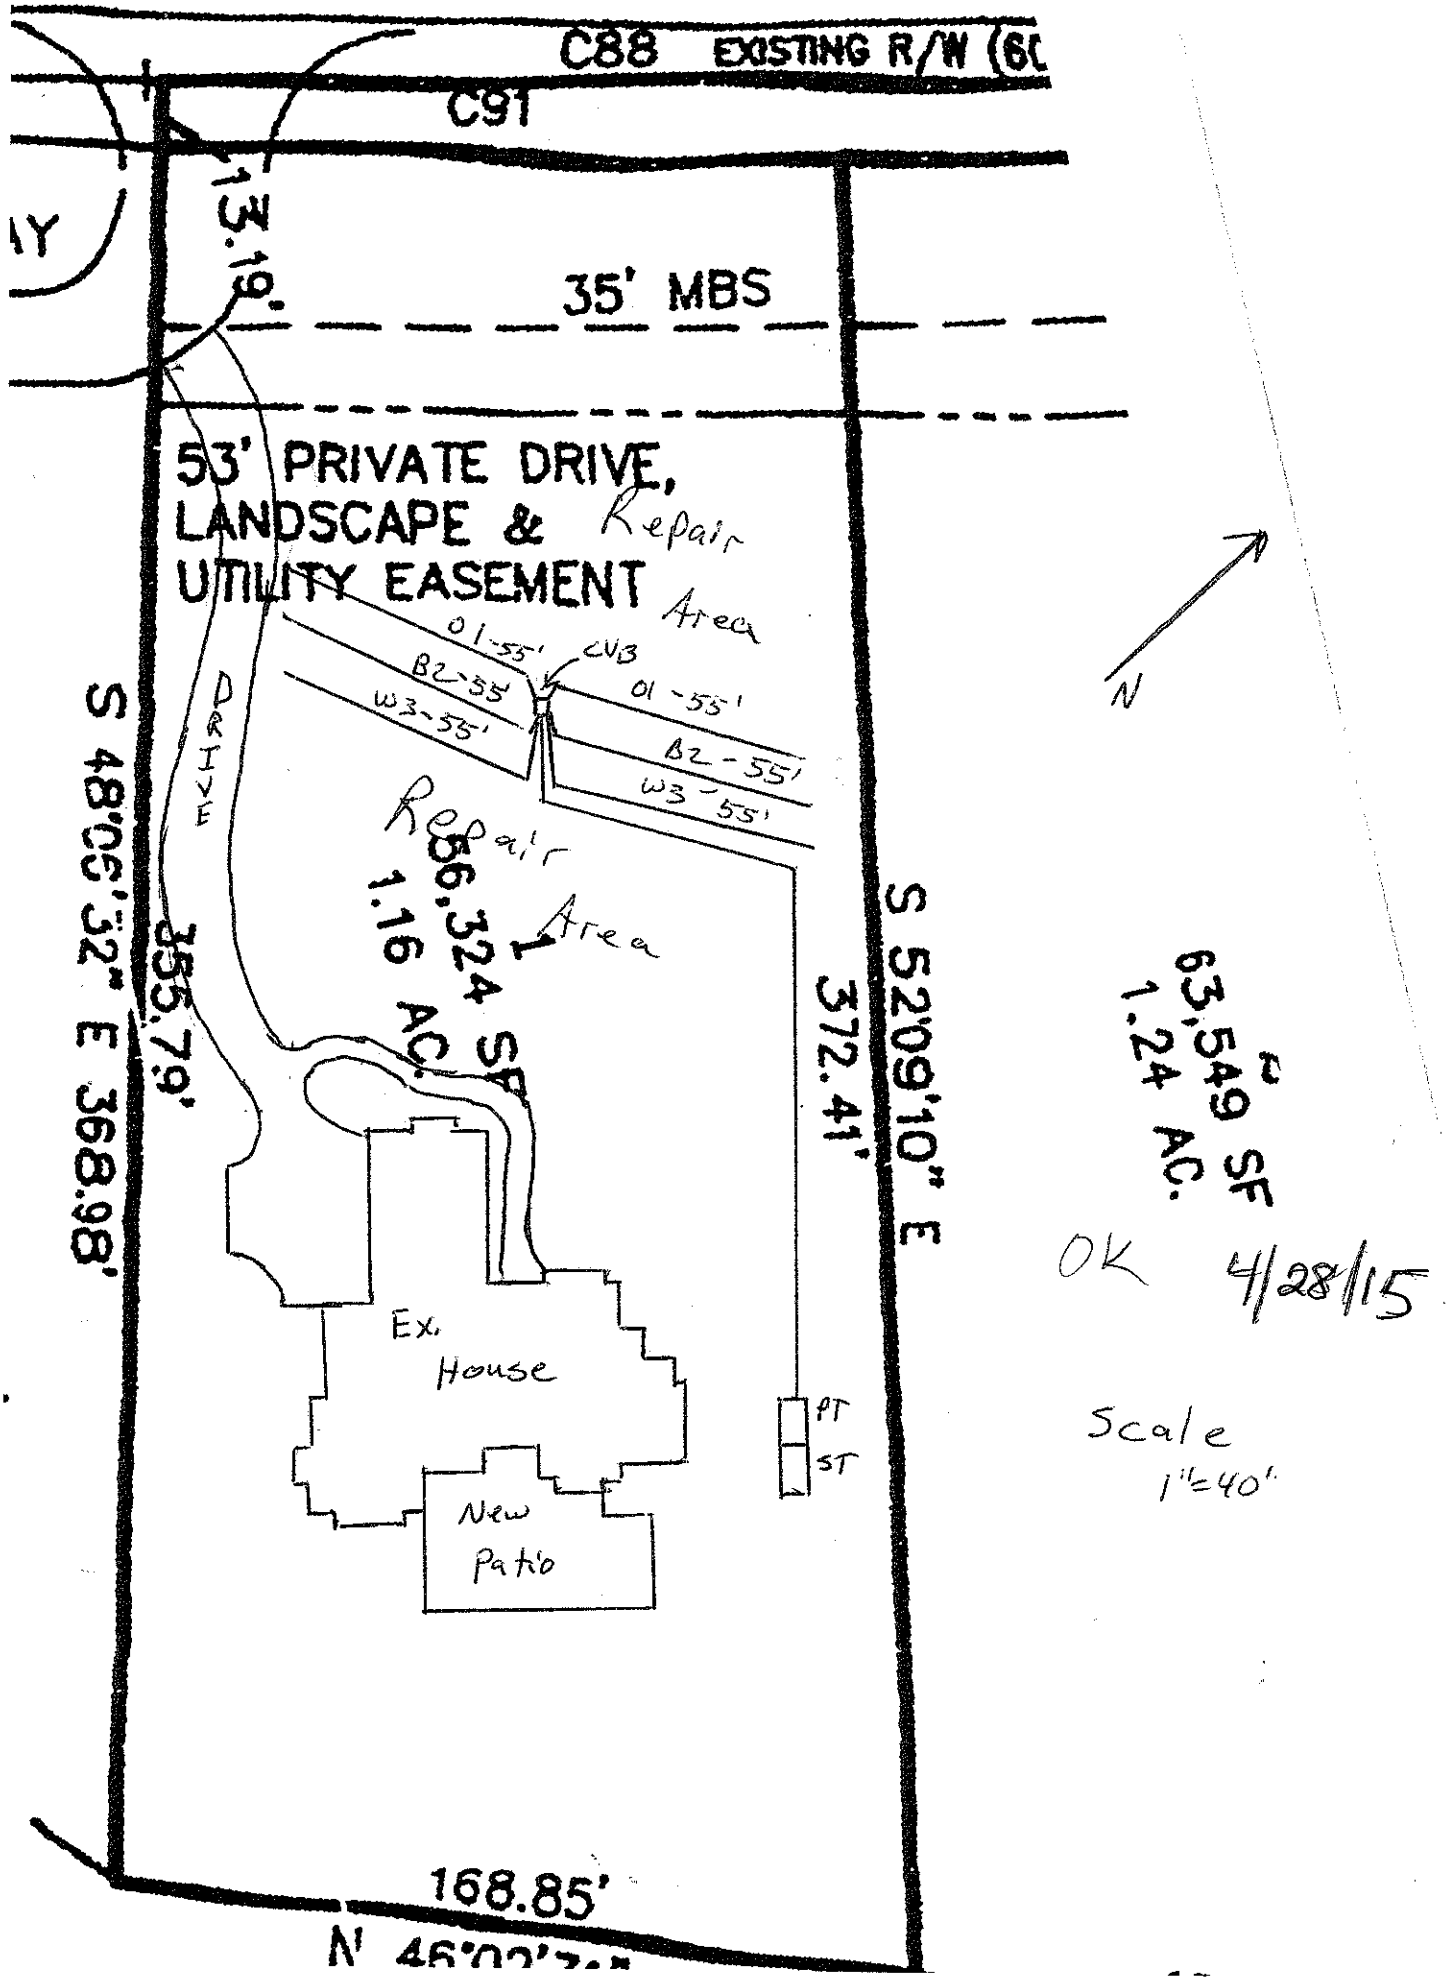

OK 4/28/15

Scale
1"=40'