IREDELL COUNTY HEALTH DEPARTMENT

STATESVILLE 704-878-5305 MOORESVILLE 704-66- 31

IMPROVEMENT PERMIT / AUTHORIZATION TO CONSTRUCT / OPERATION PERMIT / EXISTING SYSTEM INSPE[illegible]ON

PERMIT# 82421 PIN# ~~4625941684 PT~~ 4625-96-1752 DATE 1/4/00

OWNER OR CONTRACTOR CRESCENT RESOURCES / DIENST Homes PHONE: Business 663-6905 JACOBS Home

ADDRESS PO BOX 1003 CHARLOTTE - NC 28202

LOCATION BRAWLEY SCHOOL - TR MARSONS MILL - TL WHITEHORSE - TL BALLSPN - TL BROWNSMORE ON LT

SUBDIVISION POINT BLOCK / SECTION 4 LOT 463 LOT AREA 41564 SITE CLASS. FS DESIGN FLOW 480GPD L.T.A.R. [illegible] N.3

Septic Tank: 1000 + 1500 Gallons; STB 338 Date 11-22-00
Pump Tank: 1000 + Gallons; PT 27 Date 12-8-00
Pump Make: Myers Model ME3F Serial No.
Nitrification Field: No Fields 1 Square Feet 900 Linear Feet 300
No Lines 3 @ 100' Trench Width 36" Max Trench Bottom Depth 36" Gravel Depth N/A

☑ New System ☐ Repair System Type: I, II, III (IV) V, VI
System Description: LP PANEL
Repair System Description: SAME
Maintenance Agreement Required: ☑ Yes ☐ No


☑ House/Mod. Home No. Bedrooms 4
☐ Mobile Home No. Bathrooms 4
☐ Business No. Employees
☐ Other
☐ Slab ☑ Crawl Space ☐ Basement w/plumbing ☐ Basement wo/plumbing

Water Supply:
☐ Individual
☐ Public
☑ Community

Comments/Conditions:

Comments/Conditions: Lines checked 10/26/2000 MD
Tanks Checked 1/26/2001
REMOVE ALL TERRACES AND BERMS

INITIAL SITE SKETCH

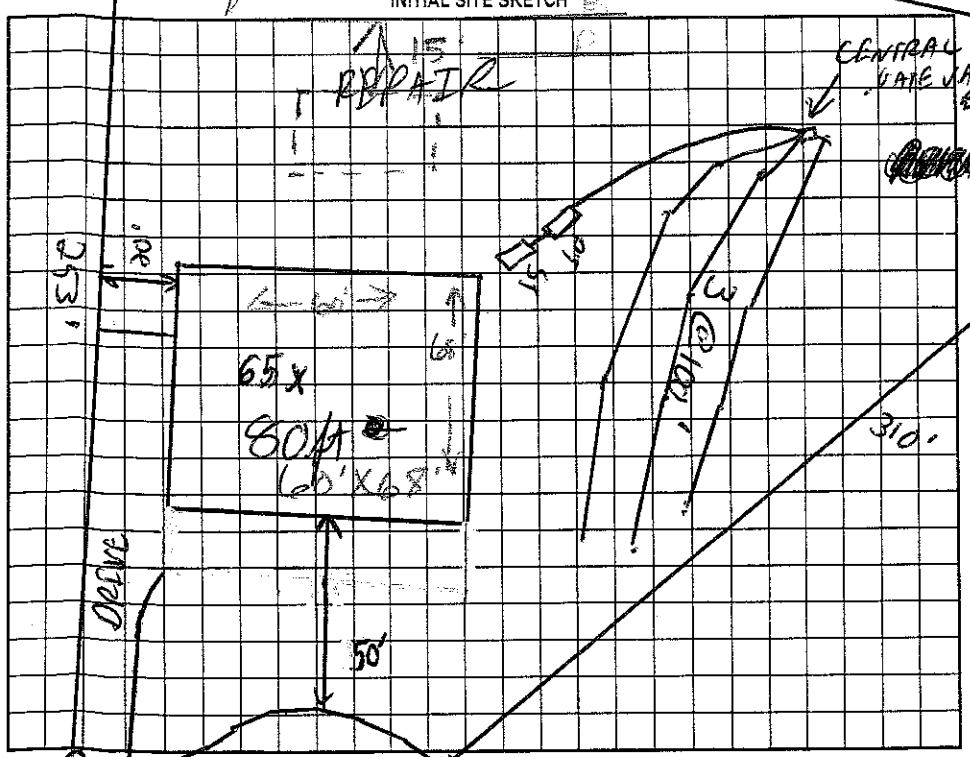

AS BUILT SKETCH

Permit can be suspended or revoked if any false information is supplied toward securing the permit/any unauthorized changes are made to the site/any unauthorized changes are made in the installation of the system. Improvement Permit with plat valid without expiration. Improvement Permit with site plan valid for sixty months. Authorization to Construct is valid for a period equal to that of Improvement Permit – not to exceed sixty months.

Signed: [signature] date 1-22-00 Installed by: R & H Inc

Improvement Permit by: C. Ryan RS date 1/4/00 Operation Permit by: Maria H. Dotson RS date 4/6/2001

Authorization to Construct by: C. Ryan RS date 9/28/00 Existing System Inspection by: date

HEALTH DEPT. COPY: WHITE OWNER COPY (FINAL): YELLOW OWNER COPY (INITIAL): PINK