IREDELL COUNTY HEALTH DEPARTMENT

STATESVILLE 704-878-5305 MOORESVILLE 704-664-5281

IMPROVEMENT PERMIT / AUTHORIZATION TO CONSTRUCT / OPERATION PERMIT / EXISTING SYSTEM INSPECTION

PERMIT# 082422/130236 PIN# ~~4625-94-1684~~ 4625-96-1959 DATE 11/16/07

OWNER OR APPLICANT Ray Tomasco PHONE: Business 203-556-8093 Home 704-831-8861

ADDRESS 106 Shelburn Place Mooresville, NC 28117

LOCATION 197 Brownstone Dr. 1100TR Mountain Rd OTL White Horse TL Ballston TL Brownstone on (L) near end

SUBDIVISION Pointe BLOCK / SECTION 4 LOT 464 LOT AREA 237,500 SITE CLASS. PS DESIGN FLOW 720 L.T.A.R. .3

Septic Tank: 1500 Gallons; STB 444 Date 8/19/07

Pump Tank: 1500 Gallons; PT 477 Date 9/19/07

Pump Make: MYERS Model ~~ME505~~ Serial No. 27590A004

Nitrification Field: No Fields 1 Square Feet 1200 Linear Feet 400

No Lines 6 Trench Width 2-3' Max Trench Bottom Depth 3' Gravel Depth No ☐ Gravity ☐ Pressure

☒ New System ☐ Repair ☐ Expansion System Type: I II III (IV) V VI

System Description: Pres Dosed - 16" PPBPS

Repair System Description: Same Type

Maintenance Agreement Required: ☒ Yes ☐ No

☒ House/Mod. Home ☐ Mobile Home ☐ Business ☐ Other

No. Bedrooms 6 No. Persons ___ No. Employees ___


Water Supply: ☐ Individual ☐ Public ☒ Community POINT

☐ Slab ☐ Crawl Space ☒ Basement w/plumbing ☐ Basement wo/plumbing

Comments:/Conditions:

Comments:/Conditions: (1) SIMTECH FILTER REQUIRED (2) CENTRAL VALVE BOX (3) LINES ON CONTOUR

INITIAL SITE SKETCH

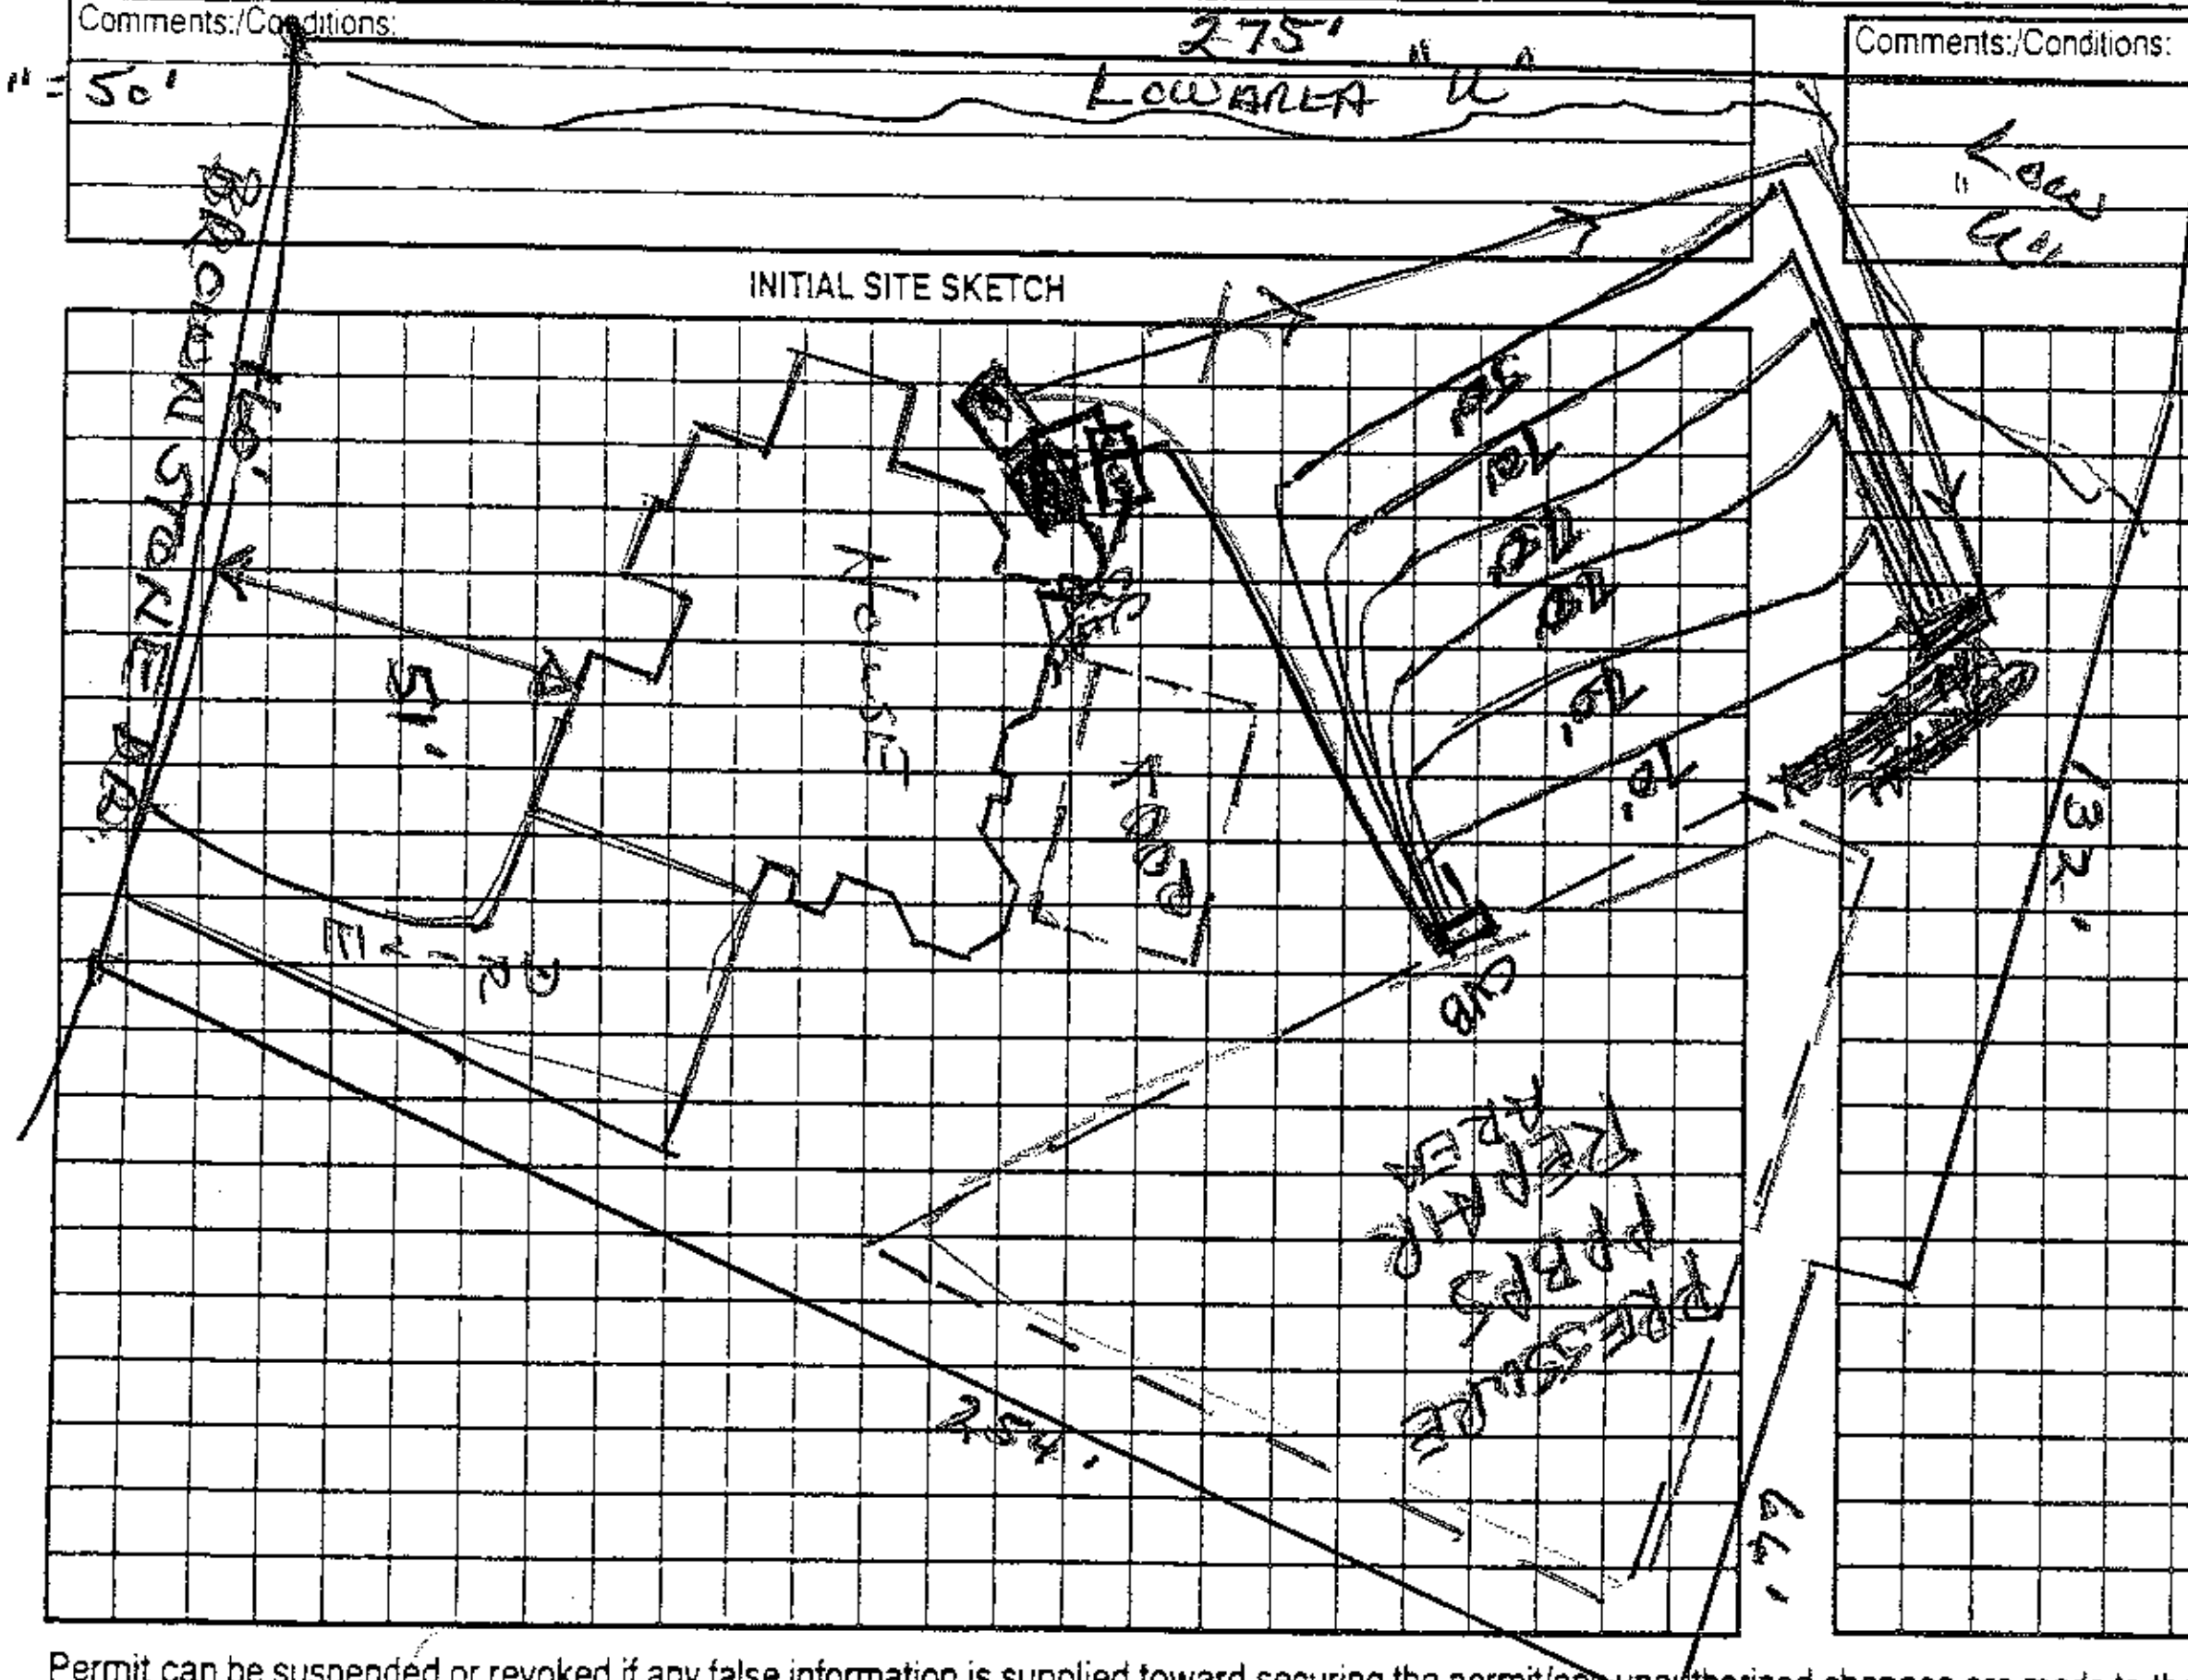

AS BUILT SKETCH

ME75B-21
25325 Dop 6

Permit can be suspended or revoked if any false information is supplied toward securing the permit/any unauthorized changes are made to the site/any unauthorized changes are made in the installation of the system. Improvement Permit with plat valid without expiration ☐ Improvement Permit with site plan valid for sixty months ☐ Authorization to Construct is valid for a period equal to that of Improvement Permit – not to exceed sixty months.

Signed: X Christine Tomasco date 11/19/07

Improvement Permit by: Wesley Sparks RS date 11/16/07

Authorization to Construct by: Wesley Sparks RS. date 11/16/07

Installed by: Stanley Septic Tank

Operation Permit by: Wesley Sparks RS date 12/21/07

Existing System Inspection by: ___ date ___

HEALTH DEPT. COPY: WHITE OWNER COPY (FINAL): YELLOW OWNER COPY (INITIAL): PINK