IREDELL COUNTY HEALTH DEPARTMENT

Statesville Office (704) 878-5305 Mooresville Office (704) 660-3625 PERMIT # 208244

IMPROVEMENT PERMIT / AUTHORIZATION TO CONSTRUCT / OPERATION PERMIT / EXISTING SYSTEM

PIN # 4625966607

APPLICANT: Warren Smith APPLICANT ADDRESS: 178 Torrence Chapel Rd Mooresville, NC 28117

SITE ADDRESS: 1857 Brawley School Rd. Mooresville, NC PHONE: 704 363-1622 ALT. PHONE:


SITE DIRECTIONS: Brawley School Rd on left right before Chatham

SUBDIVISION: The Point on Norman SECTION: 1B LOT # 58 LOT AREA: 1.16 Acre DESIGN FLOW: 480gpd L.T.A.R.: .3


Septic Tank	X 1500 (gal)	STB 335	Date 3-4-16	☒ New System ☐ Repair ☐ Expansion	System Type: I II (III) IV V VI	☒ Residence	No. Bedrooms 4	Water Supply
Pump Tank	(gal)	PT Top Serum	Date tank w/a	System Description: Gravity – 25% Reduction		☐ Business	No. Persons 8	☐ Private
Pump Make		Model Polylok PL-68	Serial # Effluent filter	Repair System Description: Pump – PPBPS		☐ Other	No. Employees	☐ Public
# Nitrification Fields	1	# Lines 4	Linear Ft: 400	Maintenance Agreement Required: ☐ YES ☒ NO		☐ Slab	☒ Crawl Space	☒ Community
Trench Width	36"	Max. Trench Bottom Depth 20"-22" Initial	Gravel Depth N/A	☒ GRAVITY ☐ PRESSURE		☐ Basement w/plumbing	☐ Basement w/o plumbing	

Comments / Conditions: X required in Crescent Communities * This permit replaces previous permit issued 2/23/15

INITIAL SITE SKETCH

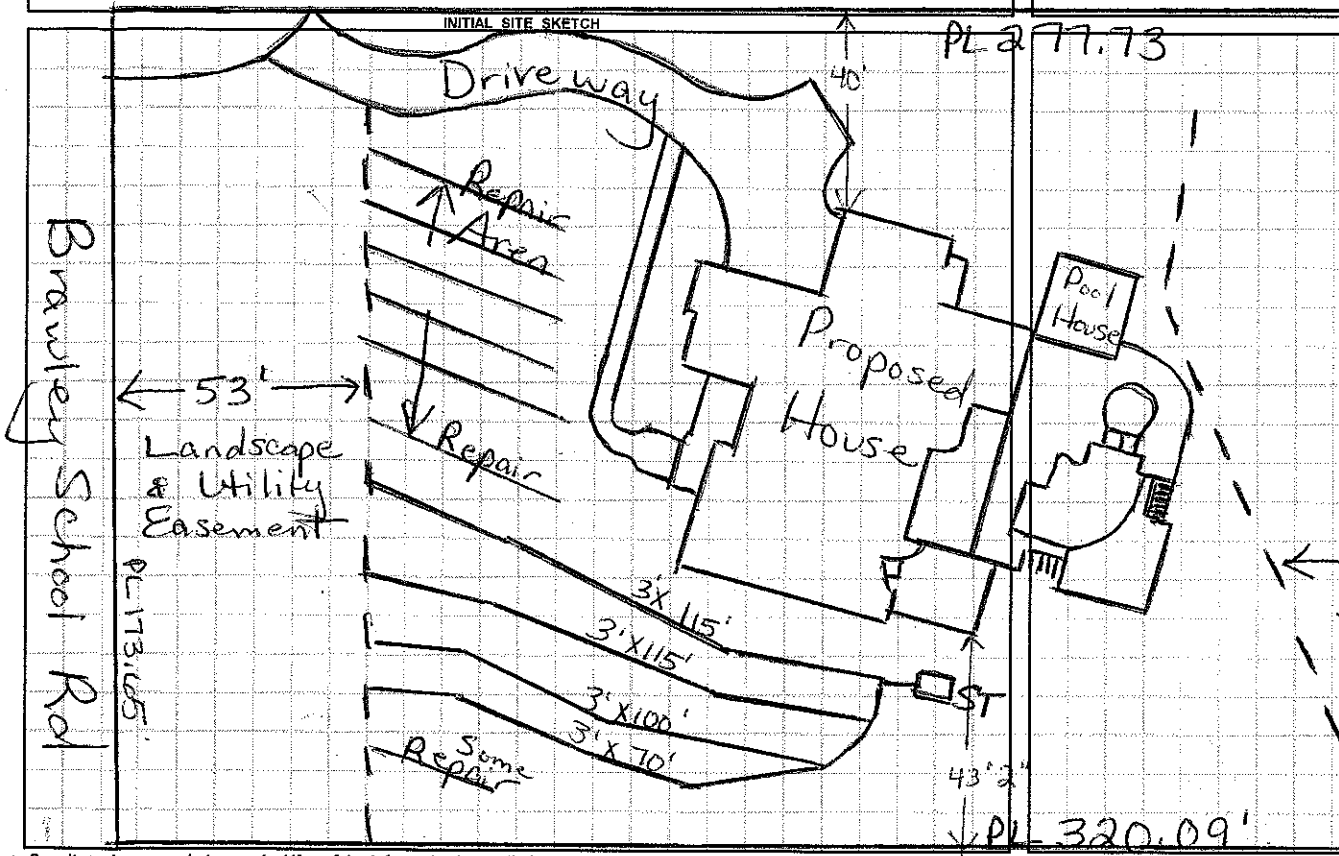

AS BUILT SKETCH

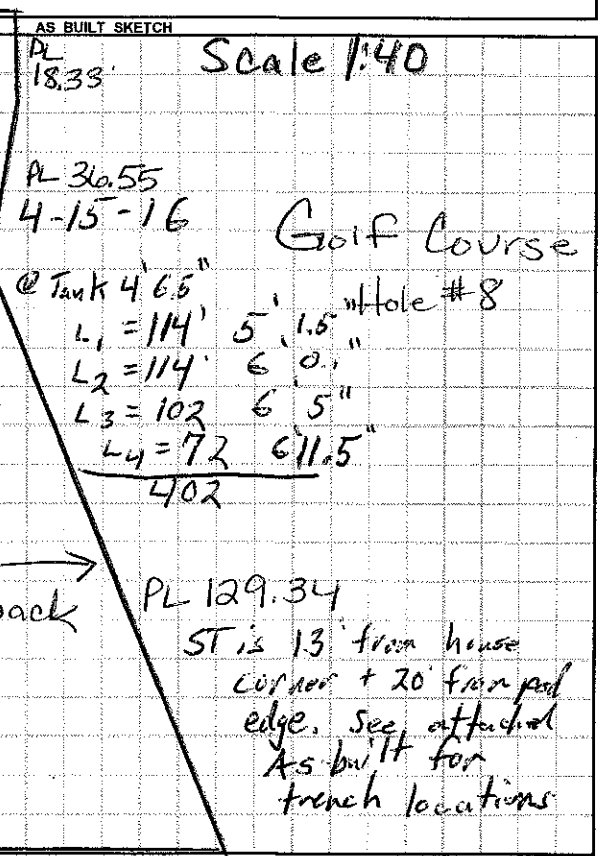

Permit can be suspended or revoked if any false information is supplied toward securing the permit / any unauthorized changes are made to the site / any unauthorized changes are made in the installation of the system. **CONTACT A LOCATOR SERVICE PRIOR TO ANY EXCAVATION**

☐ **IMPROVEMENT PERMIT** *with plat* valid without expiration. ☒ **IMPROVEMENT PERMIT** *with site plan* valid for 60 mos. ☒ **AUTHORIZATION TO CONSTRUCT** valid for period equal to IMPROVEMENT PERMIT--not to exceed 60 mo.

Owner / Applicant Signature: Date: 8-3-15 Installed by: Richard Abernathy

IMPROVEMENT PERMIT by: Marian H. Nelson REHS Date: 8/1/15 OPERATION PERMIT by: Thomas Shuck Date: 4-15-16

AUTHORIZATION TO CONSTRUCT by: Marian H. Nelson REHS Date: 8/1/15 Existing System Inspected by: Date:

Health Dept. Copy - WHITE Applicant (Final Approval) - YELLOW Applicant (Conditional Approval) - PINK