DELL COUNTY HEALTH DEPARTMENT

STATESVILLE 704-878-5305 MOORESVILLE 704-664-5281

2:00

PROVEMENT PERMIT / AUTHORIZATION TO CONSTRUCT / OPERATION PERMIT / EXISTING SYSTEM INSPECTION

RMIT# 12703 PIN# 4625-99-3936.504 46259 Lot 09 DATE 10/12/05

OWNER OR CONTRACTOR John R. Poore Bldrs. Wilberding PHONE: Business Home

ADDRESS 10590 Independence Parkway Matthews NC 28105

LOCATION BSR, on Rt. across From Quaker Rd

SUBDIVISION Point BLOCK / SECTION 5 LOT 509 LOT AREA 1.6 Ac SITE CLASS. PS DESIGN FLOW 600 L.T.A.R. 0.5

Septic Tank: 1500 Gallons; STB 4411 Date 4-28-01

Pump Tank: Gallons; PT Date

Pump Make: Model Serial No.

Nitrification Field: No Fields 1 Square Feet 1500 Linear Feet 500

No Lines 5@100' Trench Width 36" Max Trench Bottom Depth 36" Gravel Depth —

☒ New System ☐ Repair System Type: I (II) III, IV, V, VI

System Description: Gravity 25% Reduction

Repair System Description: 4" Found Block

Maintenance Agreement Required: ☐ Yes ☒ No

☒ House/Mod. Home No. Bedrooms 5

☐ Mobile Home No. Bathrooms

☐ Business No. Employees

☐ Other


☐ Slab ☐ Crawl Space ☒ Basement w/plumbing ☐ Basement wo/plumbing

Water Supply: ☐ Individual ☐ Public ☒ Community


Comments:/Conditions:

Comments:/Conditions: Installed Quick 4 for Drainfield, essentially as Drawn

INITIAL SITE SKETCH

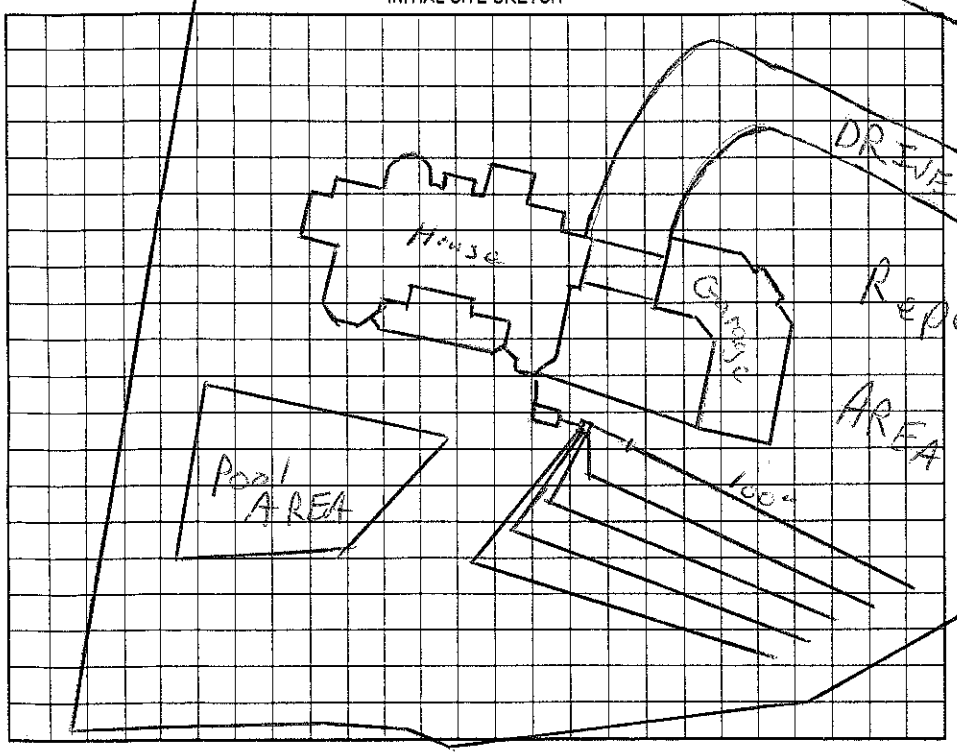

AS BUILT SKETCH

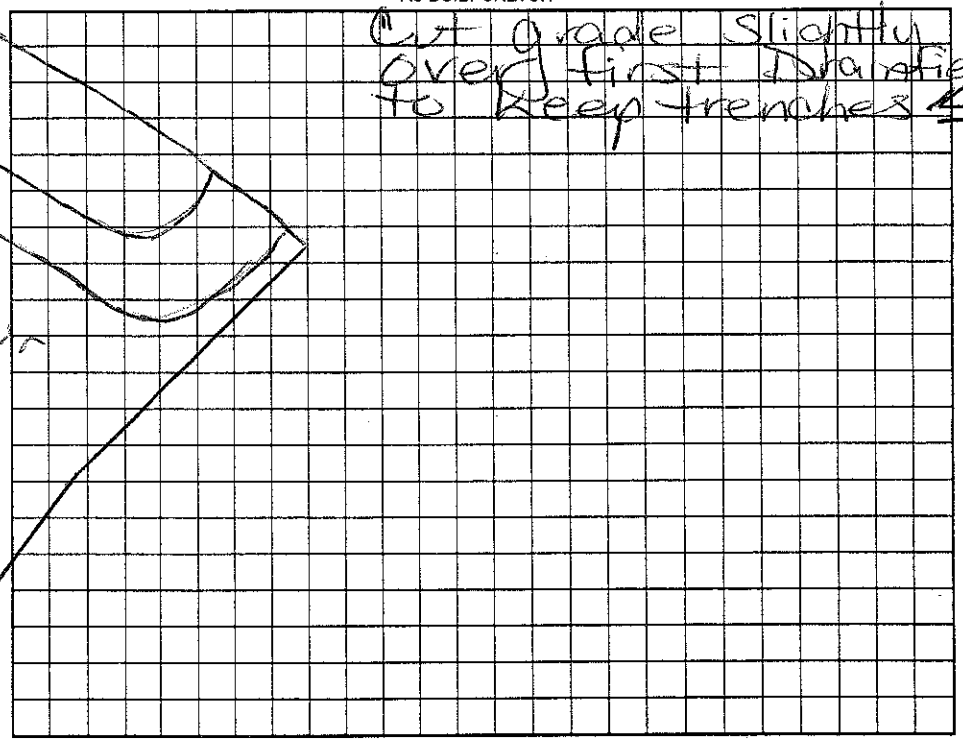

Permit can be suspended or revoked if any false information is supplied toward securing the permit/any unauthorized changes are made to the site/any unauthorized changes are made in the installation of the system. Improvement Permit with plat valid without expiration. Improvement Permit with site plan valid for sixty months. Authorization to Construct is valid for a period equal to that of Improvement Permit – not to exceed sixty months.

Signed: date 10/12/05 Installed by: RS date

Improvement Permit by: RS date 10/12/05 Operation Permit by: date 6/16/07

Authorization to Construct by: RS date 10/12/05 Existing System Inspection by: date

HEALTH DEPT. COPY: WHITE OWNER COPY (FINAL): YELLOW OWNER COPY (INITIAL): PINK