IREDELL COUNTY HEALTH DEPARTMENT

Statesville Office (704) 878-5305 Mooresville Office (704) 660-3625 PERMIT # 216172

BA

IMPROVEMENT PERMIT / AUTHORIZATION TO CONSTRUCT / OPERATION PERMIT / EXISTING SYSTEM

PIN # 4625-96-7169

APPLICANT: Jason Cook APPLICANT ADDRESS: 1849 Brawley School Rd. Mooresville, NC 28117

SITE ADDRESS: ~~Same~~ 1849 Brawley School Rd. Mooresville, NC PHONE: unknown ALT. PHONE:

SITE DIRECTIONS: BSR towards Lake Norman → Enter The Point → House on left (among 2 others)

SUBDIVISION: The Point ON NORMAN SECTION: 2B LOT # 59 LOT AREA: 1.1 acres DESIGN FLOW: 480 gal/day L.T.A.R.: 0.25 (existing)

Septic Tank EXIS (gal) STB — Date —
Pump Tank — (gal) PT INC Date —
Pump Make — Model — Serial # —
Nitrification Fields — # Lines — Linear Ft: —
Trench Width — Max. Trench Bottom Depth — Gravel Depth —

☐ New System ☐ Repair ☐ Expansion System Type: I II (III) IV V VI
System Description: Existing 25% Reduction
Repair System Description: Existing 50% Reduction
Maintenance Agreement Required: ☐ YES ☒ NO ☐ GRAVITY ☒ PRESSURE

☒ Residence ☐ Business ☐ Other ☐ Slab ☐ Basement w/plumbing
No. Bedrooms 4 No. Persons 8 No. Employees — ☒ Crawl Space
Water Supply: ☐ Private ☐ Public ☒ Community ☐ Basement w/o plumbing

Comments / Conditions: ~~No~~ New patio MUST match proposed plans on file with the health department. Any deviation in patio location, size or design invalidates this approval. No building materials are to be stored on the septic repair area. Recommend pumping septic tank + pump tank every 3-5 years.

INITIAL SITE SKETCH

See attached plans from Michael Athanas + Associates [Dated 1-21-16]

AS BUILT SKETCH

Permit can be suspended or revoked if any false information is supplied toward securing the permit / any unauthorized changes are made to the site / any unauthorized changes are made in the installation of the system. **CONTACT A LOCATOR SERVICE PRIOR TO ANY EXCAVATION**

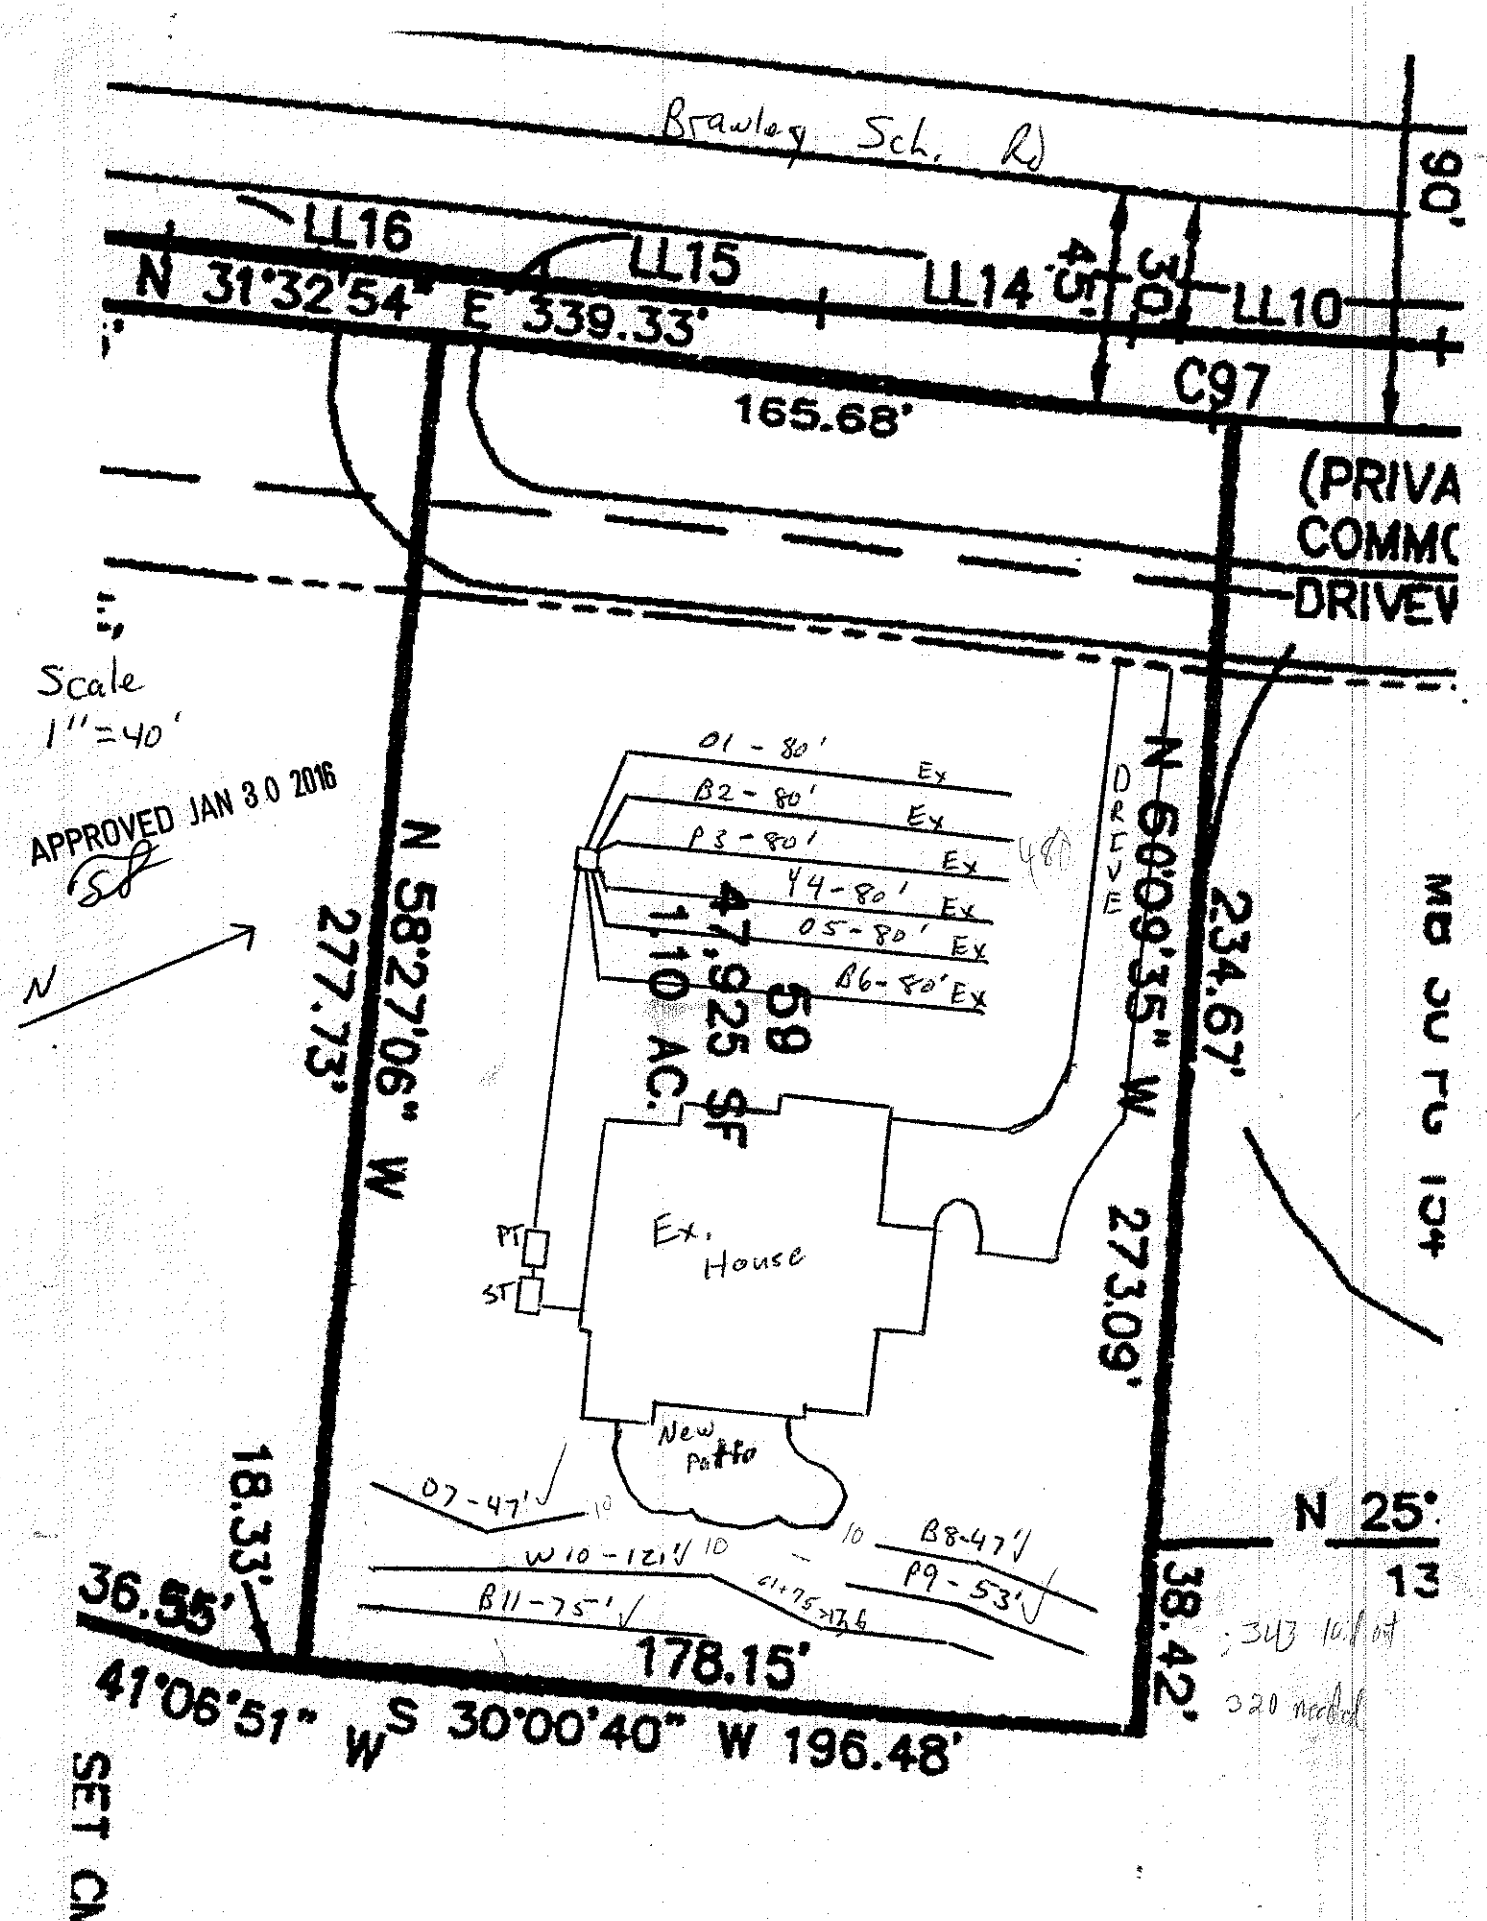
☐ **IMPROVEMENT PERMIT** *with plat valid without expiration.* ☐ **IMPROVEMENT PERMIT** *with site plan valid for 60 mos.* ☐ **AUTHORIZATION TO CONSTRUCT** *valid for period equal to IMPROVEMENT PERMIT--not to exceed 60 mo.*

Owner / Applicant Signature: [signature] Date: 2/8/16 Installed by: —

IMPROVEMENT PERMIT by: — Date: — OPERATION PERMIT by: — Date: —

AUTHORIZATION TO CONSTRUCT by: — Date: — Existing System Inspected by: Tom Shack Date: 1-30-16

Health Dept. Copy - WHITE Applicant (Final Approval) - YELLOW Applicant (Conditional Approval) - PINK


Brawley Sch. Rd
60.
LL16
LL15
LL14
LL10
N 31°32'54" E 339.33'
45'
30'
C97
165.68'
(PRIVA
COMM(
DRIVEV
Scale
1"=40'
APPROVED JAN 30 2016
N
01 - 80' Ex
B2 - 80' Ex
P3 - 80' Ex
44 - 80' Ex
05 - 80' Ex
B6 - 80' Ex
DRIVE
48
N 58°27'06" W
277.73'
1.10 AC.
47,925 SF
N 60°09'35" W
234.67'
Ex. House
PT
ST
273.09'
New Patio
07 - 47'
W10 - 121'
B11 - 75'
B8 - 47'
P9 - 53'
10
10
18.33'
36.55'
178.15'
41°06'51" W
S 30°00'40" W 196.48'
38.42'
N 25°
13
SET CA

Previously Approved Design

APPROVED JUL 07 2014

ACP

