IREDELL COUNTY HEALTH DEPARTMENT

STATESVILLE 704-878-5305 MOORESVILLE 704-664-5281

IMPROVEMENT PERMIT / AUTHORIZATION TO CONSTRUCT / OPERATION PERMIT / EXISTING SYSTEM INSPECTION

PERMIT# 82425 PIN# 4625 94 1684 PT 4625-97-0352 DATE 1/7/00

OWNER OR CONTRACTOR CRESCENT RESOURCES PHONE: Business 663 6905 JACOBS Home

ADDRESS PO BOX 1003 CHARLOTTE NC 28202

LOCATION BRAWLEY SCHOOL - TR MARSHANS MILL - TL WHITEHORSE - TL BALLSTON - TL BROWNSTONE 2nd LT

SUBDIVISION POINT BLOCK / SECTION 4 LOT 47 LOT AREA 47589 SITE CLASS. PS DESIGN FLOW 480 L.T.A.R .125 gal/ft²

Septic Tank: 1600 + Gallons; STB 338 Date 2/1/05

Pump Tank: Gallons; PT Date

Pump Make: Model Serial No.

Nitrification Field: No Fields 1 Square Feet 1440 Linear Feet 480

No Lines 4@120' Trench Width 36" Max Trench Bottom Depth 36" Gravel Depth N/A

☑ New System ☐ Repair System Type: I, II, III, IV, V, VI

System Description: GRAVITY EFFLUENT

Repair System Description: LP PANEL

Maintenance Agreement Required: ☐ Yes ☑ No

☑ House/Mod. Home No. Bedrooms 4

☐ Mobile Home No. Bathrooms 4

☐ Business No. Employees

☐ Other


☐ Slab ☑ Crawl Space ☑ Basement w/plumbing ☐ Basement wo/plumbing

Water Supply: ☐ Individual ☐ Public ☑ Community


Comments:/Conditions: REMOVE ALL TERRACES AND BERMS

Comments:/Conditions: ½ BASEMENT ONLY

INITIAL SITE SKETCH 1"=50'

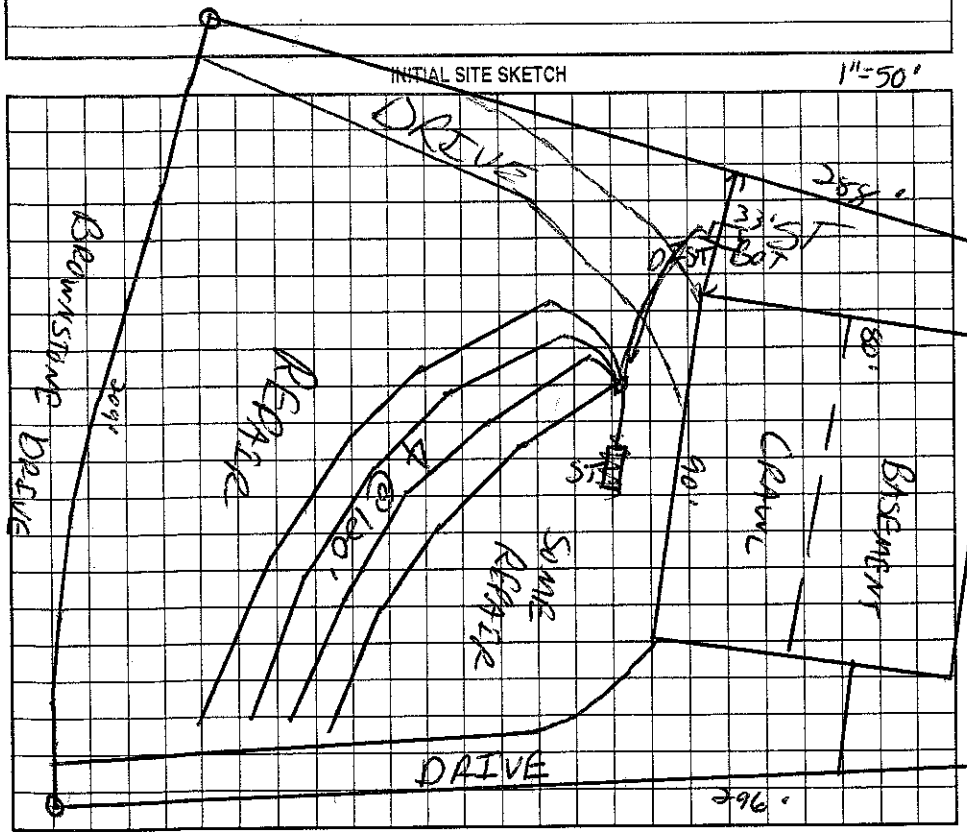

AS BUILT SKETCH

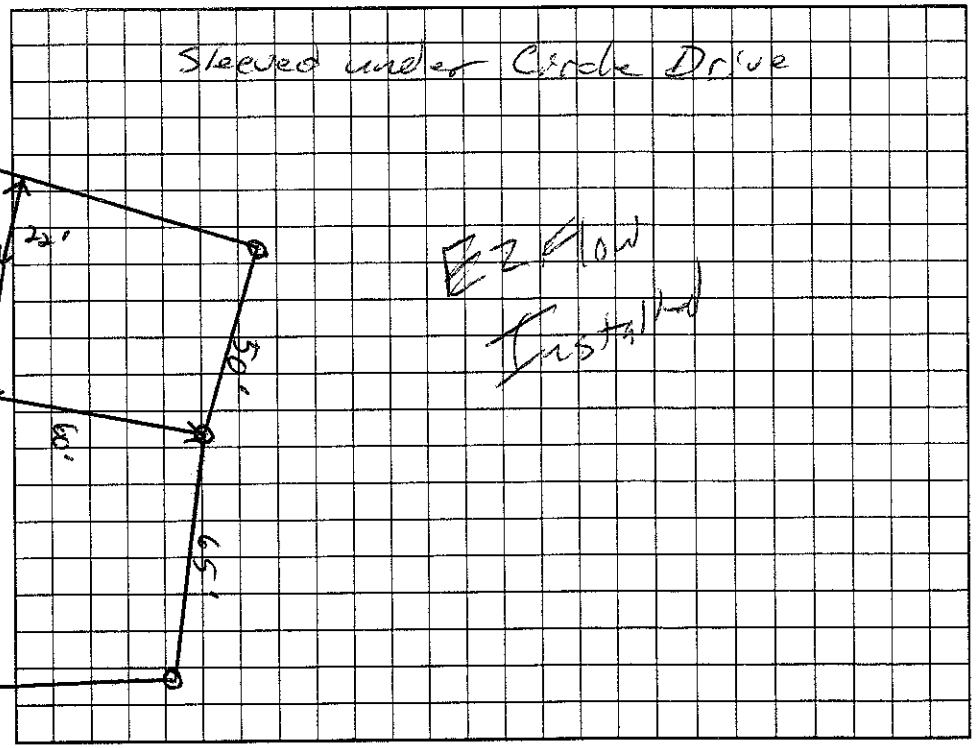

Permit can be suspended or revoked if any false information is supplied toward securing the permit/any unauthorized changes are made to the site/any unauthorized changes are made in the installation of the system. Improvement Permit with plat valid without expiration. Improvement Permit with site plan valid for sixty months. Authorization to Construct is valid for a period equal to that of Improvement Permit – not to exceed sixty months.

Signed: date 1-2-3

Improvement Permit by: RS date 1/7/00

Authorization to Construct by: RS date 4/6/04

Installed by: Hallmann Const.

Operation Permit by: RS date 3/4/05

Existing System Inspection by: date

HEALTH DEPT. COPY: WHITE OWNER COPY (FINAL): YELLOW OWNER COPY (INITIAL): PINK