IREDELL COUNTY HEALTH DEPARTMENT

~~STATES~~VILLE 704-878-5305 MOORESVILLE 704-664-5281

IMPROVEMENT PERMIT / AUTHORIZATION TO CONSTRUCT / OPERATION PERMIT / EXISTING SYSTEM INSPECTION

PERMIT# 82425 PIN# 4625 94 1684 PT 4625-97-0352 DATE 1/7/00

OWNER OR CONTRACTOR CRESCENT RESOURCES PHONE: Business 663 6905 JACOBS Home

ADDRESS PO BOX 1003 CHARLOTTE NC 28202

LOCATION BRAWLEY SCHOOL - TR MARSONS MILL - TL WHITE HORSE - TL BALLSTON - TL BROWNSTONE CR LT

SUBDIVISION POINT BLOCK / SECTION 4 LOT 467 LOT AREA 47589 SITE CLASS. PS DESIGN FLOW 480 L.T.A.R. .125 gal/sq ft

Septic Tank: 1600+ Gallons; STB 338 Date 2/1/05

Pump Tank: Gallons; PT Date

Pump Make: Model Serial No.

Nitrification Field: No Fields 1 Square Feet 1440 Linear Feet 480

No Lines 4@120' Trench Width 36" Max Trench Bottom Depth 36" Gravel Depth N/A

☑ New System ☐ Repair System Type: I, II, III, IV, V, VI

System Description: GRAVITY EZFLOW LAY

Repair System Description: LP PANEL

Maintenance Agreement Required: ☐ Yes ☑ No

☑ House/Mod. Home ☐ Mobile Home ☐ Business ☐ Other

No. Bedrooms 4 No. Bathrooms 4 No. Employees


☐ Slab ☑ Crawl Space ☑ Basement w/plumbing ☐ Basement wo/plumbing

Water Supply: ☐ Individual ☐ Public ☑ ~~Community~~


Comments/Conditions: REMOVE ALL TERRACES AND BERMS

Comments/Conditions: ½ BASEMENT ONLY

INITIAL SITE SKETCH

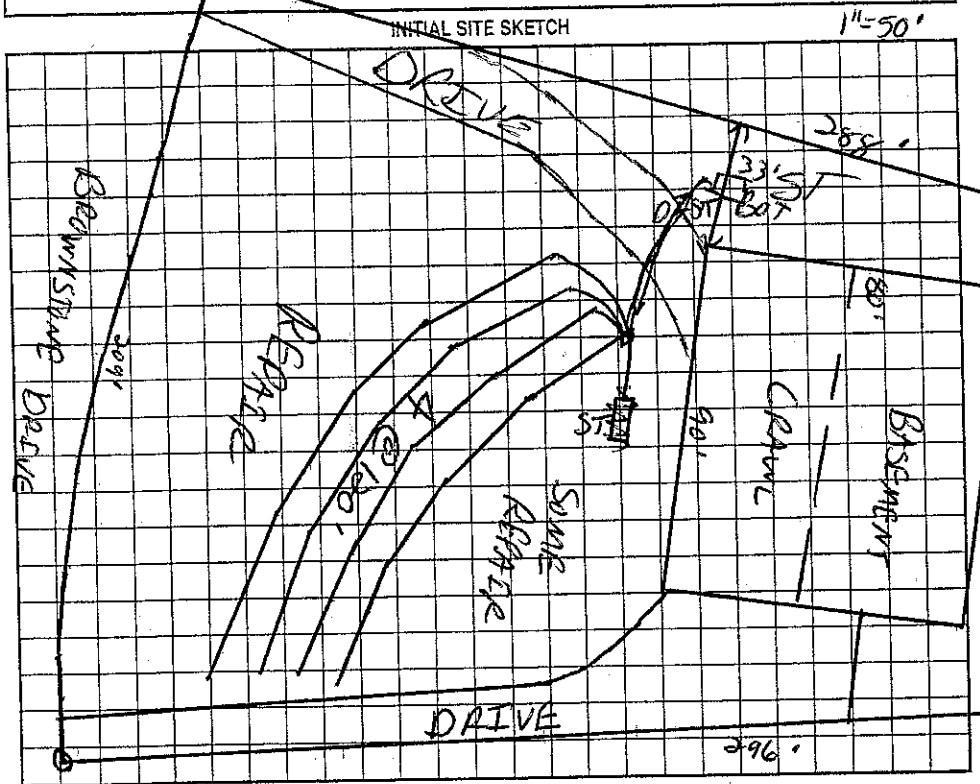

AS BUILT SKETCH

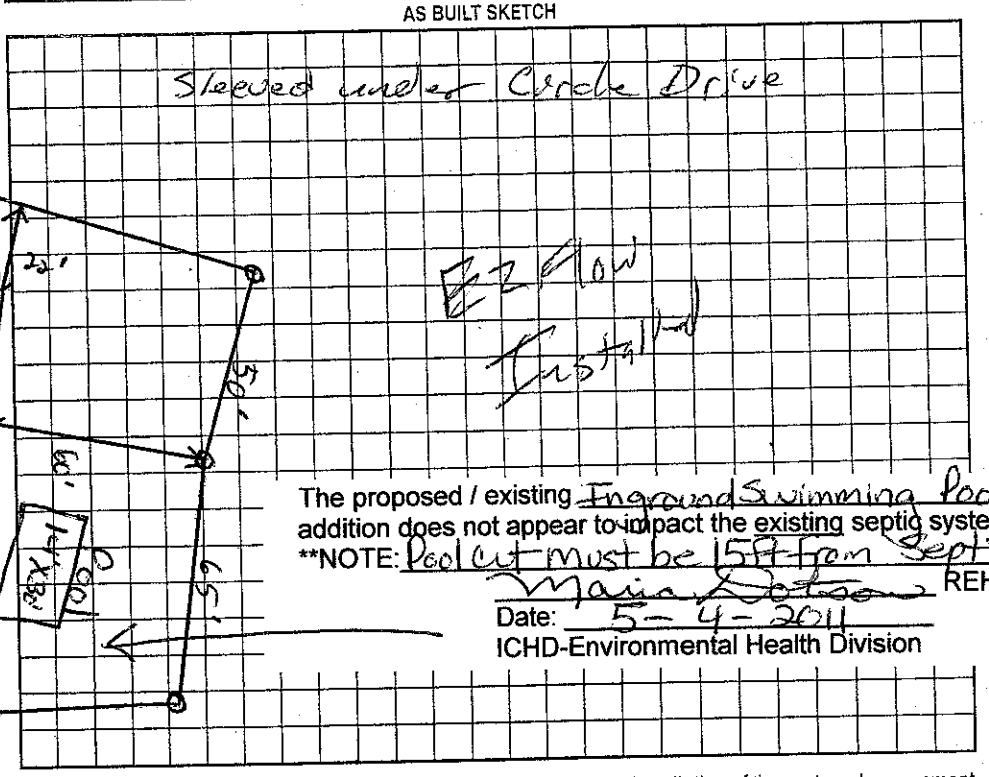

The proposed / existing Inground Swimming Pool addition does not appear to impact the existing septic system

**NOTE: Pool cut must be 15ft from Septic

Maria Dotson REHS

Date: 5-4-2011

ICHD-Environmental Health Division

Permit can be suspended or revoked if any false information is supplied toward securing the permit/any unauthorized changes are made to the site/any unauthorized changes are made in the installation of the system. Improvement Permit with plat valid without expiration. Improvement Permit with site plan valid for sixty months. Authorization to Construct is valid for a period equal to that of Improvement Permit – not to exceed sixty months.

Signed: date 1-25-00 Installed by: Hallman Const.

Improvement Permit by: C. B. Dotson RS date 1/7/00 Operation Permit by: RS date 3/4/05

Authorization to Construct by: RS date 4/6/04 Existing System Inspection by: date

HEALTH DEPT. COPY: WHITE OWNER COPY (FINAL): YELLOW OWNER COPY (INITIAL): PINK