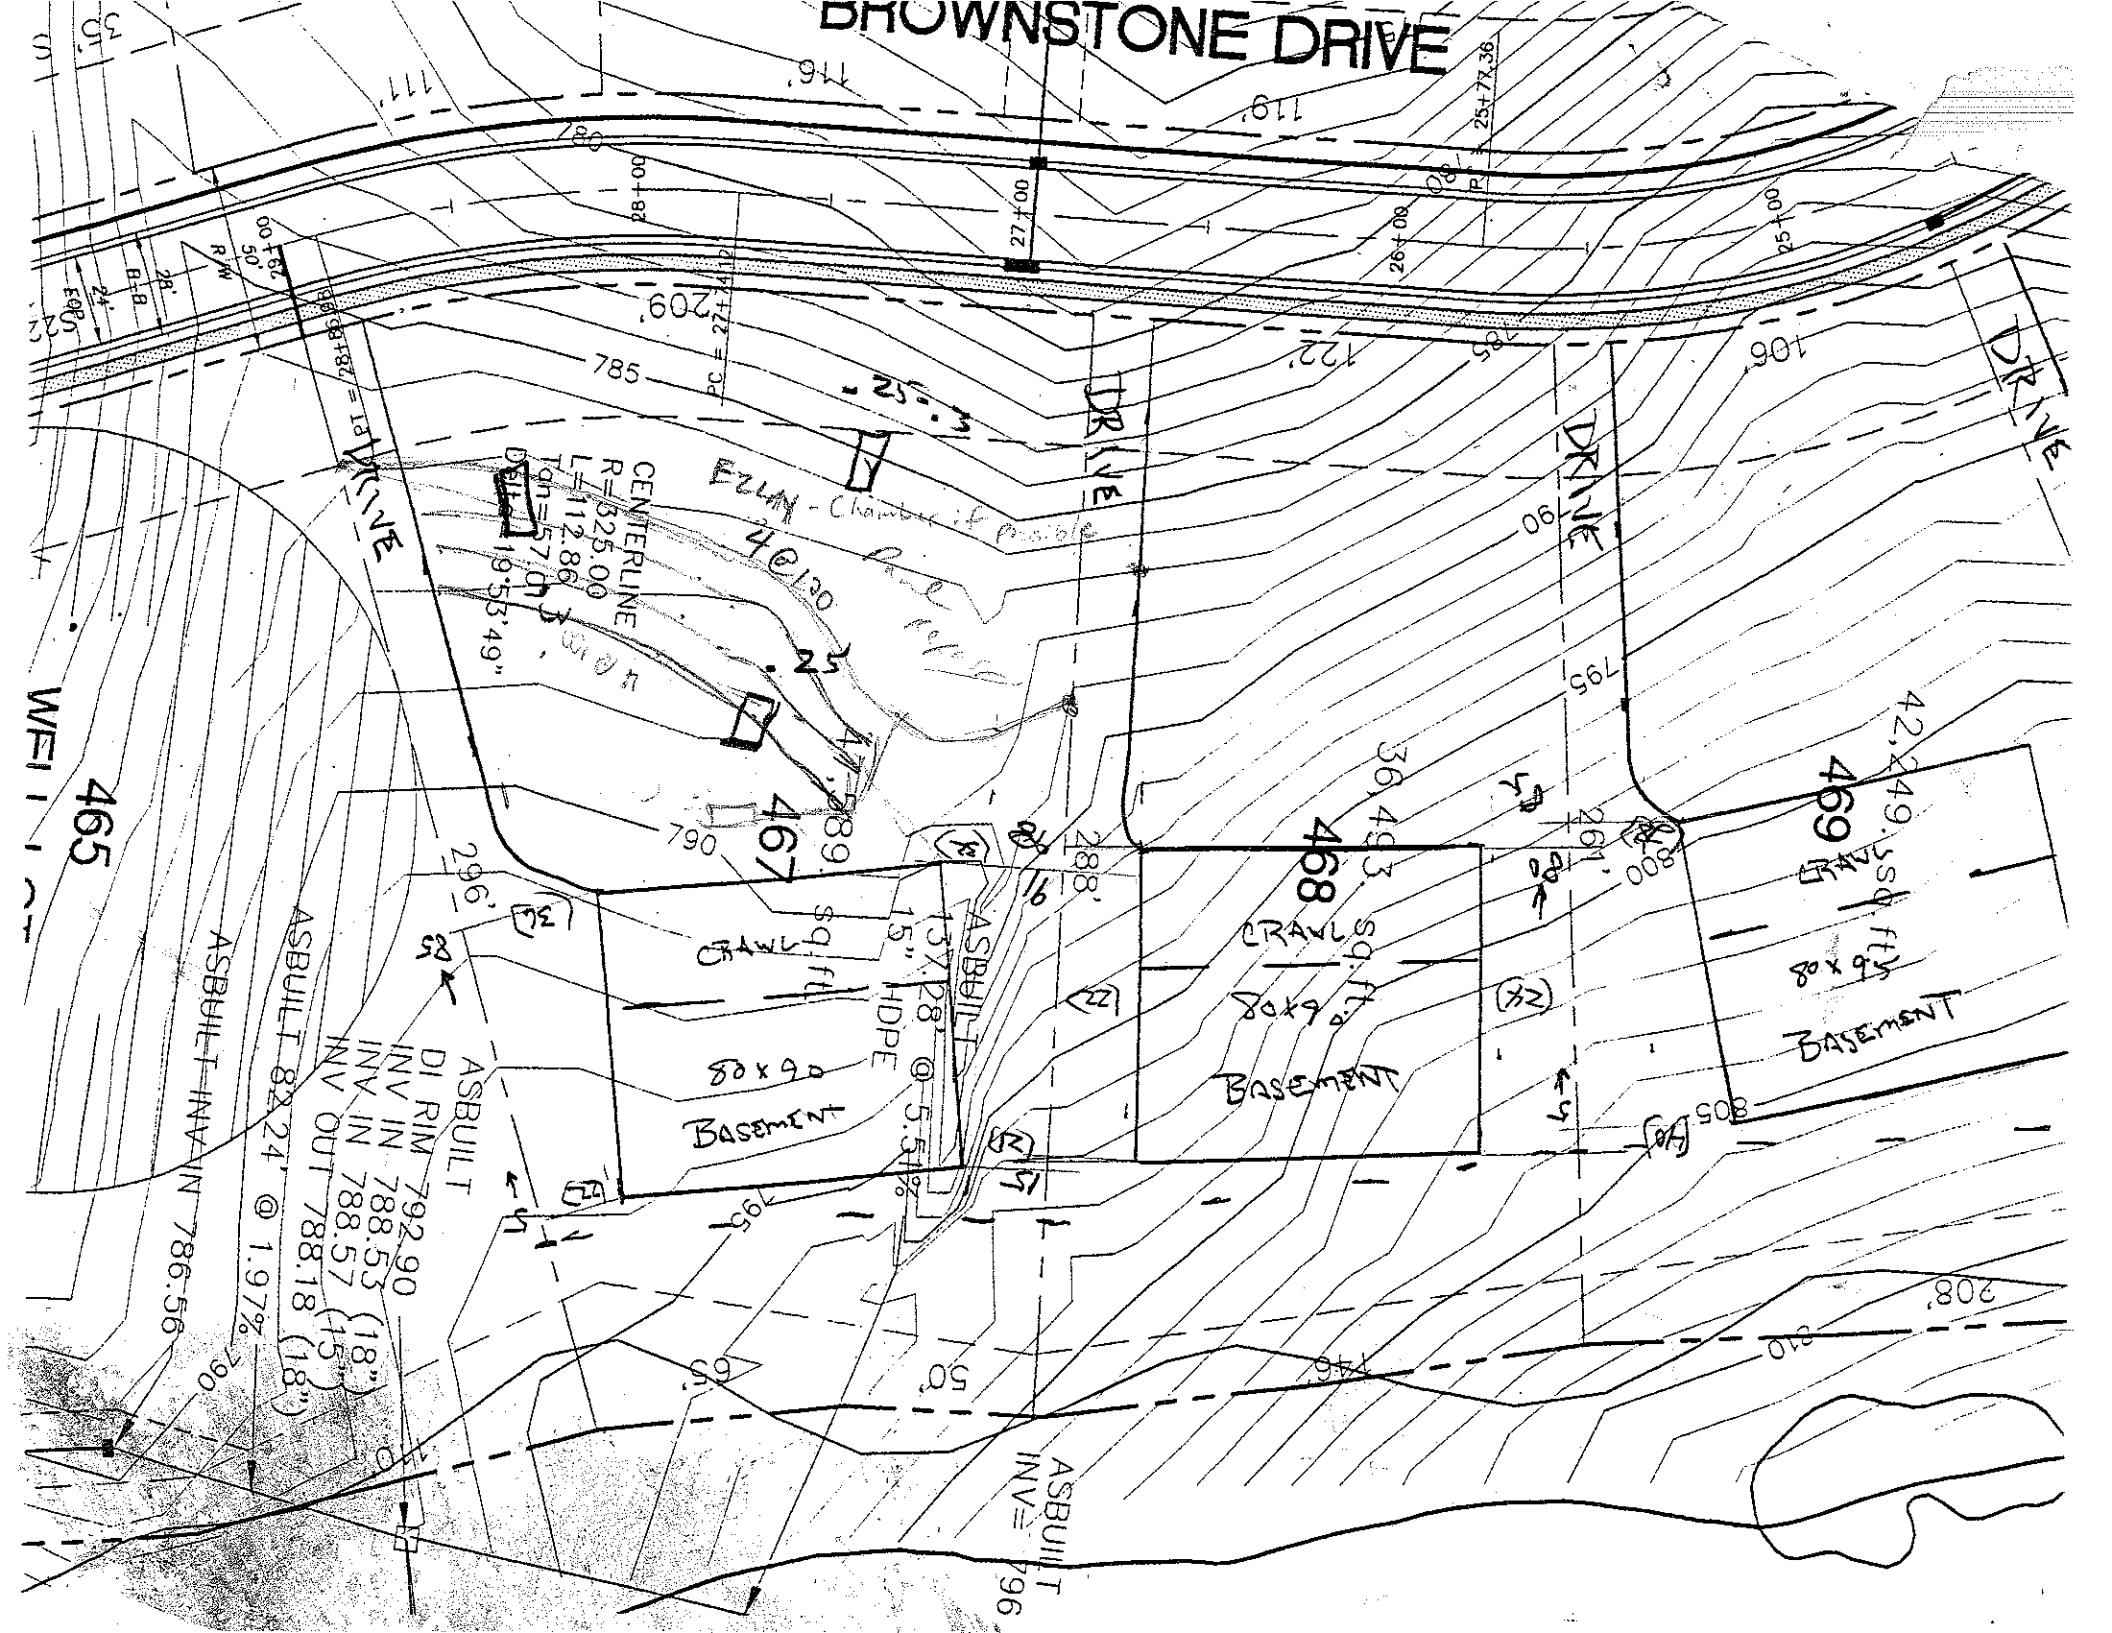

BROWNSTONE DRIVE
DRIVE
DRIVE
DRIVE
WEI
465
467
468
469
CENTERLINE
R=325.00
L=112.86
Tan=57.04
Delta=19°53'49"
EZLW - Chamber if possible
4@30
CRAWL
Sq ft
80 x 90
Basement
80x90 Sq.ft
Basement
42,249 Sq ft
80 x 95
Basement
ASBUILT
15" X 28' @ 5.54%
HDPE
ASBUILT
DI RIM 792.90
INV IN 788.53 (18")
INV IN 788.57 (15")
INV OUT 788.18 (18")
ASBUILT 82.24' @ 1.97%
ASBUILT INV IN 786.56
ASBUILT INV=
296'
36,493 Sq ft
PC = 27+34.00
PT = 28+80.00
25+77.36
27+00
26+00
25+00
209'
208'
785
790
795
800
805
810