IREDELL COUNTY HEALTH DEPARTMENT

STATESVILLE 704-878-5305 MOORES 04-664-5281

Parcel 400-37606

IMPROVEMENT PERMIT / AUTHORIZATION TO CONSTRUCT / OPERATION PERMIT / EXISTING SYSTEM INSPECTION

PERMIT# 081142 PIN# 4625-94-1684 4625-97-5058 DATE

OWNER OR CONTRACTOR Augusta Homes PHONE: Business Home

ADDRESS 10602-B Bailey Rd Cornelius NC 28031

LOCATION BSR, on Rt Post Brawly Harbor Rd

SUBDIVISION The Point BLOCK / SECTION 5 LOT 502 LOT AREA 48,676 Ft² SITE CLASS PS DESIGN FLOW 480 L.T.A.R. 0.3

Septic Tank: ~~1000~~ 1500 Gallons; STB 338 Date 9/19/05

Pump Tank: 1000 Gallons; PT 263 Date 11/1/04

Pump Make: Goulds Model WE0312M4 Serial No.

Nitrification Field: No Fields 1 Square Feet 1200 Linear Feet 400

No Lines 5@80' Trench Width 36" Max Trench Bottom Depth 36" Gravel Depth —

☒ New System ☐ Repair System Type: I, II, III, IV, V, VI

System Description: ~~Conv~~ 25% Reduction

Repair System Description: LOP Panel Block

Maintenance Agreement Required: ☐ Yes ☒ No

☒ House/Mod. Home ☐ Mobile Home ☐ Business ☐ Other

No. Bedrooms 4 No. Bathrooms No. Employees


☐ Slab ☒ Crawl Space ☐ Basement w/plumbing ☐ Basement wo/plumbing

Water Supply: ☐ Individual ☐ Public ☒ Community


Comments:/Conditions:

Comments:/Conditions: Tanks & lines checked by GM 9/6/05
Elect, pres: & alarm 9/2/05

INITIAL SITE SKETCH

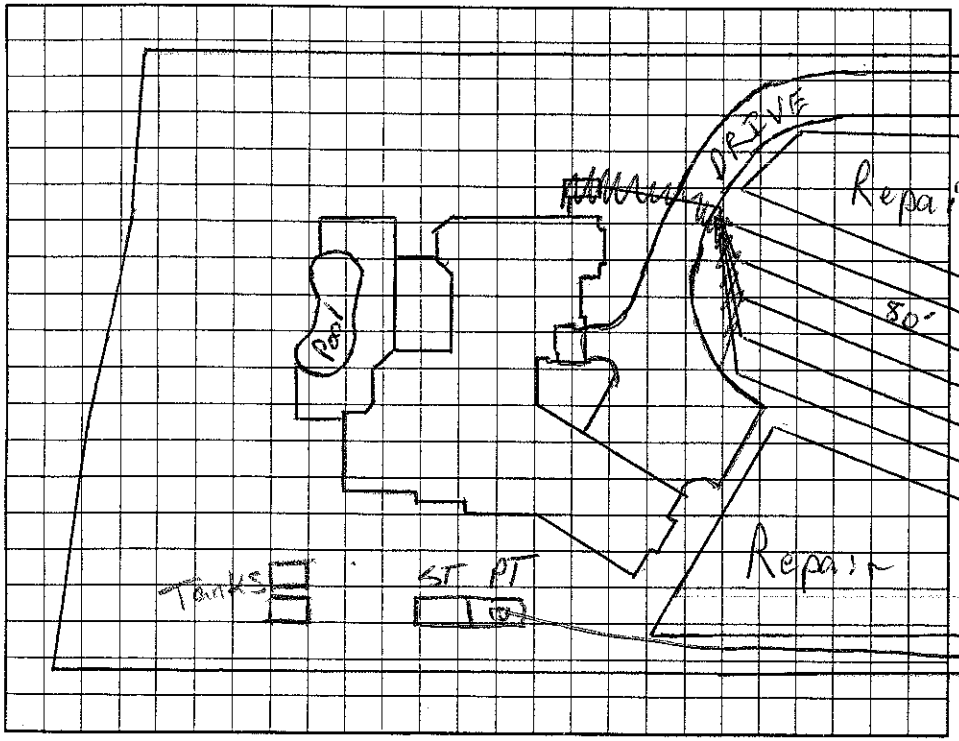

AS BUILT SKETCH

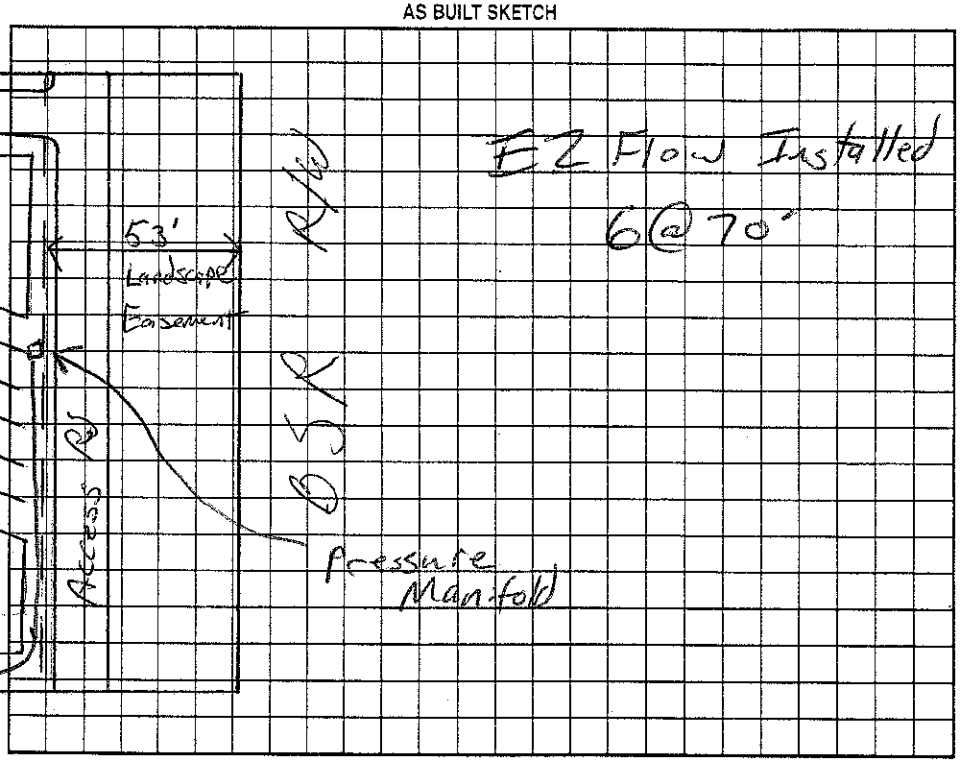

Permit can be suspended or revoked if any false information is supplied toward securing the permit/any unauthorized changes are made to the site/any unauthorized changes are made in the installation of the system. Improvement Permit with plat valid without expiration. Improvement Permit with site plan valid for sixty months. Authorization to Construct is valid for a period equal to that of Improvement Permit – not to exceed sixty months.

Signed: date Installed by: R+H RS

Improvement Permit by: RS date 10/27/04 Operation Permit by: RS date 9/2/05

Authorization to Construct by: RS date 10/27/04 Existing System Inspection by: date

HEALTH DEPT. COPY: WHITE OWNER COPY (FINAL): YELLOW OWNER COPY (INITIAL): PINK