IREDELL COUNTY HEALTH DEPARTMENT

Statesville Office (704) 878-5305 Mooresville Office (704) 660-3625 PERMIT # 220001

IMPROVEMENT PERMIT / AUTHORIZATION TO CONSTRUCT / OPERATION PERMIT / EXISTING SYSTEM

PIN # 4625975732 v

APPLICANT: LANCE PATTERSON APPLICANT ADDRESS: 312 N MYERS ST CHARLOTTE

SITE ADDRESS: 1780 BRAWLEY SCHOOL RD ; Mocksville PHONE: ALT. PHONE: 704-201-9812

SITE DIRECTIONS: BSR - PAST MARSTONS MILL ON SIDE STREET - RT SIDE

SUBDIVISION: The POINT on Norman SECTION: 5 LOT # 498 LOT AREA: .95 Ac DESIGN FLOW: 480 L.T.A.R.:


Septic Tank ____ (gal) STB ____ Date ____
Pump Tank ____ (gal) PT Fx7857646 Date ____
Pump Make ____ Model ____ Serial # ____
Nitrification Fields ____ # Lines ____ Linear Ft: ____
Trench Width ____ Max. Trench Bottom Depth ____ Gravel Depth ____

☐ New System ☐ Repair ☐ Expansion System Type: I II (III) IV V VI
System Description: Pump & RECOVERY
Repair System Description: LP PPBPS
Maintenance Agreement Required: ☐ YES ☒ NO ☐ GRAVITY ☒ PRESSURE


☐ Residence ☐ Business ☐ Other ☐ Slab ☐ Basement w/plumbing
No. Bedrooms 4 No. Persons 8 No. Employees ____ ☒ Crawl Space
Water Supply: ☐ Private ☐ Public ☒ Community ☐ Basement w/o plumbing

Comments / Conditions:

INITIAL SITE SKETCH

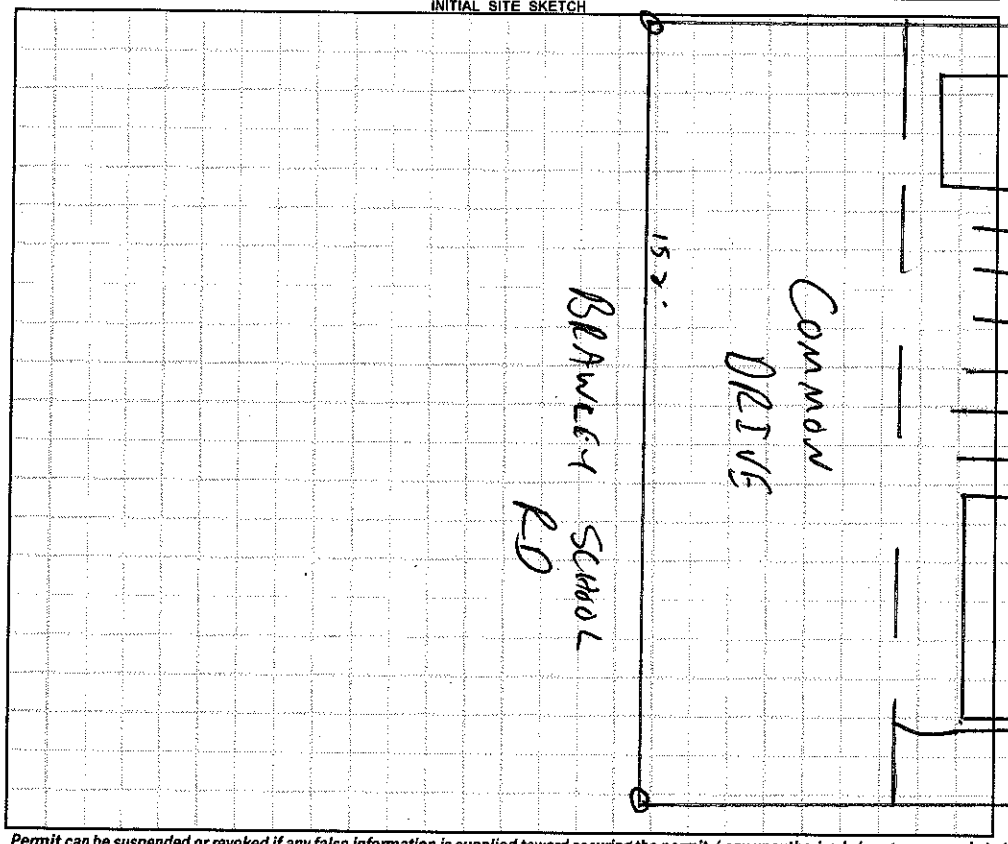

AS BUILT SKETCH

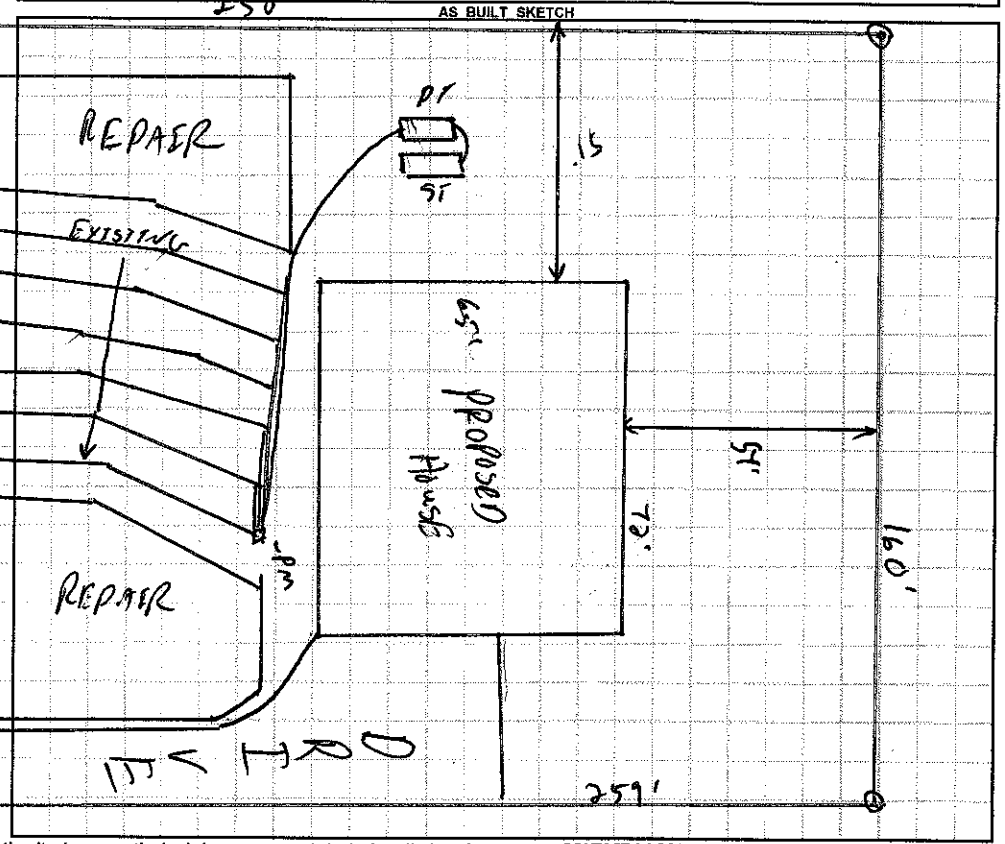

Permit can be suspended or revoked if any false information is supplied toward securing the permit / any unauthorized changes are made to the site / any unauthorized changes are made in the installation of the system. **CONTACT A LOCATOR SERVICE PRIOR TO ANY EXCAVATION**

☐ **IMPROVEMENT PERMIT** ***with plat*** *valid without expiration.* ☐ **IMPROVEMENT PERMIT** ***with site plan*** *valid for 60 mos.* ☐ **AUTHORIZATION TO CONSTRUCT** *valid for period equal to IMPROVEMENT PERMIT--not to exceed 60 mo.*

Owner / Applicant Signature: Bobby Cat Date: 8-8-16 Installed by: ____

IMPROVEMENT PERMIT by: ____ Date: ____ OPERATION PERMIT by: ____ Date: ____

AUTHORIZATION TO CONSTRUCT by: ____ Date: ____ Existing System Inspected by: [signature] Date: 8/3/16

Health Dept. Copy - WHITE Applicant (Final Approval) - YELLOW Applicant (Conditional Approval) - PINK