IREDELL COUNTY HEALTH DEPARTMENT

$325

STATESVILLE 704-878-5305 MOORESVILLE 704-664-5281

IMPROVEMENT PERMIT / AUTHORIZATION TO CONSTRUCT / OPERATION PERMIT / EXISTING SYSTEM INSPECTION

PERMIT# 081136 PIN# 4625944684 (PT) 4625-97-5829 DATE July 23, 1999

OWNER OR CONTRACTOR Crescent Resources Inc. - The Point on Norman / Hughes & Assoc PHONE: Business 660-1185 Home

ADDRESS 2214 Brawley Sch Rd. Mooresville

LOCATION Brawley Sch Rd. on Right past Brawley Harbor Rd.

SUBDIVISION The Point BLOCK / SECTION 5 LOT 497 LOT AREA 39,338 SF SITE CLASS. DESIGN FLOW 480 gpd L.T.A.R. .025-.3

Septic Tank 1500 Concr Gallons; STB 338 Date 3-15-02

Pump Tank: 1000 Gallons; PT 27 Date 3-26-02

Pump Make: Model ME 3F-21 Serial No 26229D001

Nitrification Field: No Fields 1 Square Feet 1050 Linear Feet 350

No Lines 6 @ 70' Trench Width 36" Max Trench Bottom Depth 36" Gravel Depth N/A

☑ New System ☐ Repair System Type: I, II, III, ☑ V, VI

System Description: LPP PANEL Block

Repair System Description: SAME

Maintenance Agreement Required: ☑ Yes ☐ No

☑ House/Mod. Home ☐ Mobile Home ☐ Business ☐ Other

No. Bedrooms 4 No. Bathrooms 4 No. Employees

☑ Slab ☑ Crawl Space ☑ Basement w/plumbing ☐ Basement wo/plumbing

Water Supply: ☐ Individual ☑ Public ☑ Community


Comments:/Conditions:

Comments:/Conditions: (partial)


Tanks & lines inspected 5/3/2002. MD

Note: Lines had to be shortened due to Electrical line in front; added extra line

INITIAL SITE SKETCH 1"=50'

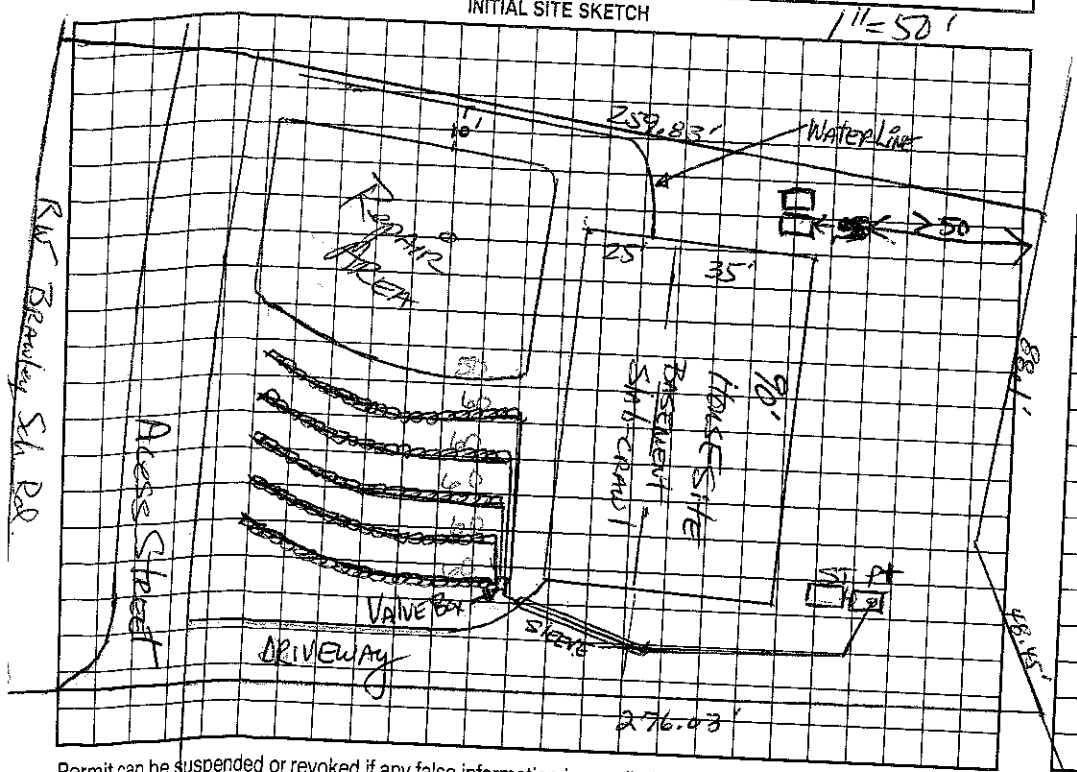

AS BUILT SKETCH

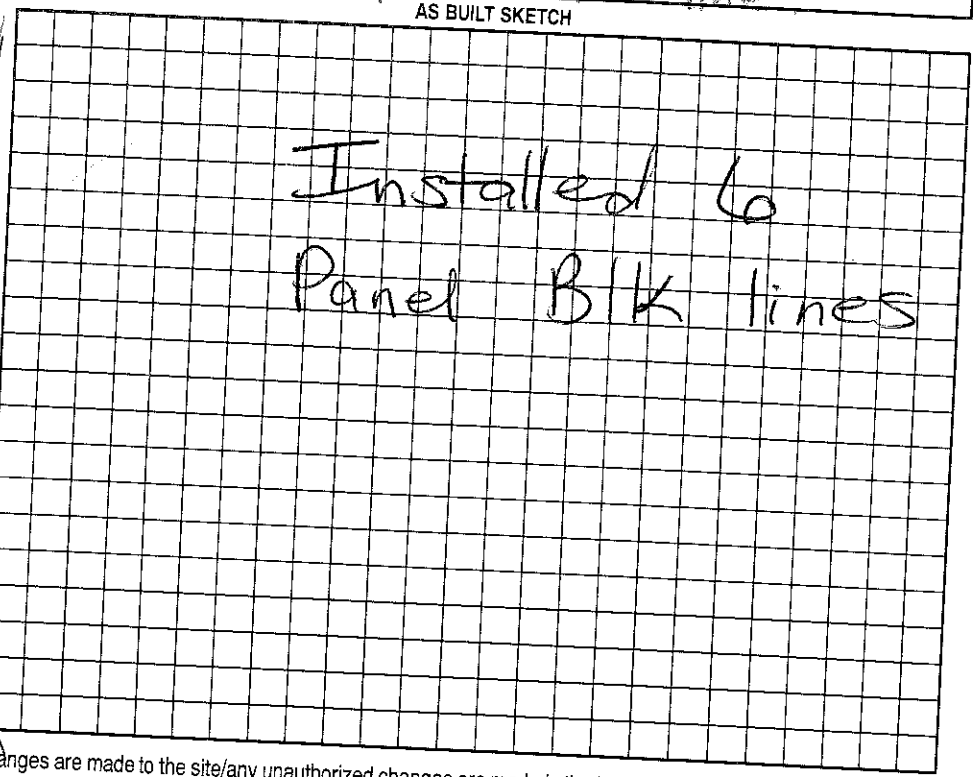

Permit can be suspended or revoked if any false information is supplied toward securing the permit/any unauthorized changes are made to the site/any unauthorized changes are made in the installation of the system. Improvement Permit with plat valid without expiration. Improvement Permit with site plan valid for sixty months. Authorization to Construct is valid for a period equal to that of Improvement Permit – not to exceed sixty months.

Signed:

Improvement Permit by: date 9-10-99

Authorization to Construct by: date 7-23-99

date 1-16-02

Installed by: R & H Inc

Operation Permit by: date 7/30/02

Existing System Inspection by: date

HEALTH DEPT. COPY: WHITE OWNER COPY (FINAL): YELLOW OWNER COPY (INITIAL): PINK