IREDELL COUNTY HEALTH DEPARTMENT

STATESVILLE 704-878-5305 315.00 Paid MOORESVILLE 704-664-5281

IMPROVEMENT PERMIT / AUTHORIZATION TO CONSTRUCT / OPERATION PERMIT / EXISTING SYSTEM INSPECTION

PERMIT# 128433 PIN# ~~4625978747~~ 4625-97-8747 Laura DATE 5-2-05

OWNER OR CONTRACTOR Hughes Home Link & Zande PHONE: Business 363-0853 Home

ADDRESS 909 C East Blvd Charlotte NC 28203

LOCATION Brawley School Rd on left before Quaker

SUBDIVISION The Point BLOCK / SECTION 1-C LOT 36 LOT AREA .82 Acre SITE CLASS. PS DESIGN FLOW 480gpd L.T.A.R. ~.25

Septic Tank: ~~1000~~ 1500 Gallons; STB 338 Date 9/12/05

Pump Tank: 1000 Gallons; PT 283 Date 9/24/05

Pump Make: Gaulds Model WE=0312/14 Serial No.

Nitrification Field: No Fields 1 Square Feet 960 Linear Feet 320'

No Lines 4 @ 80' Trench Width 24"-36" Max Trench Bottom Depth ~30"

☒ New System ☐ Repair System Type: I, II, III, IV, V, VI

System Description: Pump-4-Panel Block

Repair System Description: Pump-4-25% Reduction Offsite 36A

Maintenance Agreement Required: ☒ Yes ☐ No

☒ House/Mod. Home ☐ Mobile Home ☐ Business ☐ Other

No. Bedrooms 4 No. Bathrooms 4 No. Employees

☐ Slab ☒ Crawl Space ☐ Basement w/plumbing ☐ Basement wo/plumbing


Water Supply: ☐ Individual ☒ Public ☒ Community

Comments/Conditions: A Repair offsite on 36A
Remove all old berms & terraces.

Comments/Conditions: Checked lines 11/3/05
Pressure, elect & alarm 12/13/05

Scale 1:50

INITIAL SITE SKETCH

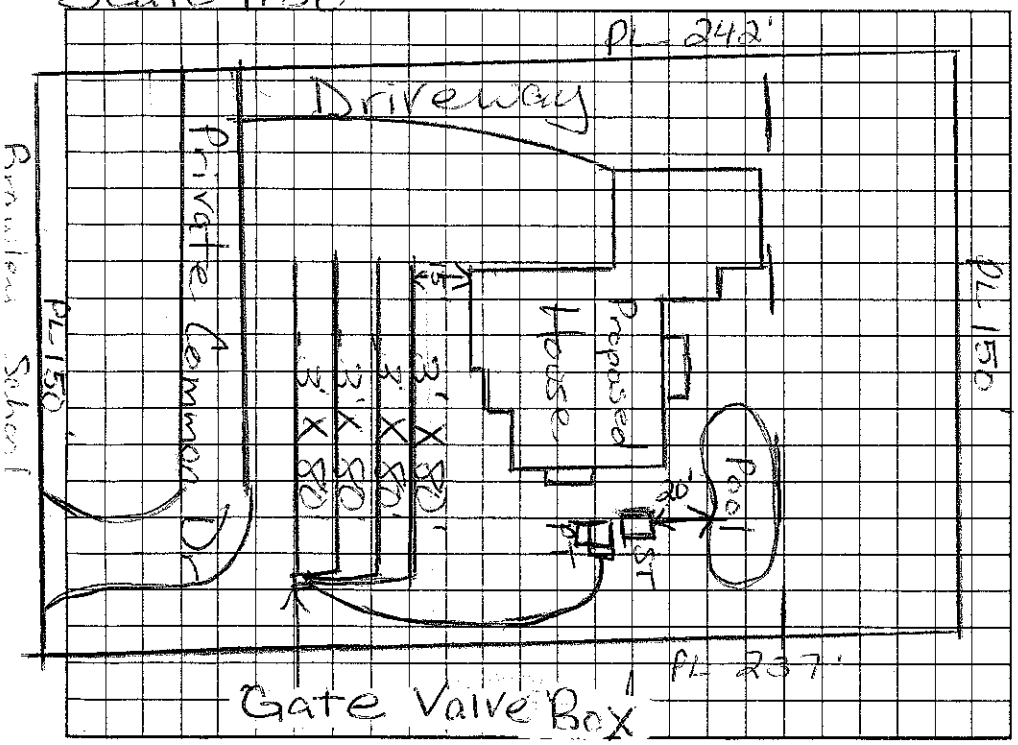

AS BUILT SKETCH

Installed 05

Drawn

Permit can be suspended or revoked if any false information is supplied toward securing the permit/any unauthorized changes are made to the site/any unauthorized changes are made in the installation of the system. Improvement Permit with plat valid without expiration. Improvement Permit with site plan valid for sixty months. Authorization to Construct is valid for a period equal to that of Improvement Permit – not to exceed sixty months.

Signed: Sheeky Dent RS date 5/10/05 Installed by: Bobby Mayhew RS

Improvement Permit by: Maria H. Dotson RS date 5/3/05 Operation Permit by: Maria H. Dotson RS date 12/13/05

Authorization to Construct by: Maria H. Dotson RS date 5/3/05 Existing System Inspection by: date

HEALTH DEPT. COPY: WHITE OWNER COPY (FINAL): YELLOW OWNER COPY (INITIAL): PINK