IREDELL COUNTY HEALTH DEPARTMENT

STATESVILLE 704-878-5305 MOORESVILLE 704-664-5281

IMPROVEMENT PERMIT / AUTHORIZATION TO CONSTRUCT / OPERATION PERMIT / EXISTING SYSTEM INSPECTION

PERMIT# 074989 PIN# ~~4625941684~~ 4625-97-8925 DATE Nov. 14 '98

OWNER OR CONTRACTOR ~~Crescent Resources~~ c/o Sandra Crabtree PHONE: Business _____ Home _____

ADDRESS P.O. Box 1003, Charlotte

LOCATION Brawley School Road on left before Quaker Road

SUBDIVISION The Point BLOCK / SECTION 1-C LOT 37 LOT AREA 37,976 ft² SITE CLASS. PS DESIGN FLOW 480gpd L.T.A.R. .025

Septic Tank: ~~1000+1500~~ Gallons; STB 338 Date 8/20/01

Pump Tank: 1000 Gallons; PT 253 Date 10/5/01

Pump Make: Meyers Model ME 5052 Serial No. 253250 007

Nitrification Field: No Fields 1 Square Feet 960 Linear Feet 320

No Lines 6 Trench Width 36" Max Trench Bottom Depth ~30" Gravel Depth NA

☑ New System ☐ Repair System Type: I, II, III, ⓘ V, VI

System Description: LP Panel Block

Repair System Description: SAME

Maintenance Agreement Required: ☑ Yes ☐ No

☑ House/Mod. Home No. Bedrooms 4

☐ Mobile Home No. Bathrooms 4

☐ Business No. Employees ____

☐ Other ____

☐ Slab ☑ Crawl Space ☐ Basement w/plumbing ☐ Basement wo/plumbing


Water Supply: ☐ Individual ☑ ~~Public~~ ☑ Community

Comments:/Conditions: Remove any old drums, terraces.


Comments:/Conditions:

1"=50'

INITIAL SITE SKETCH

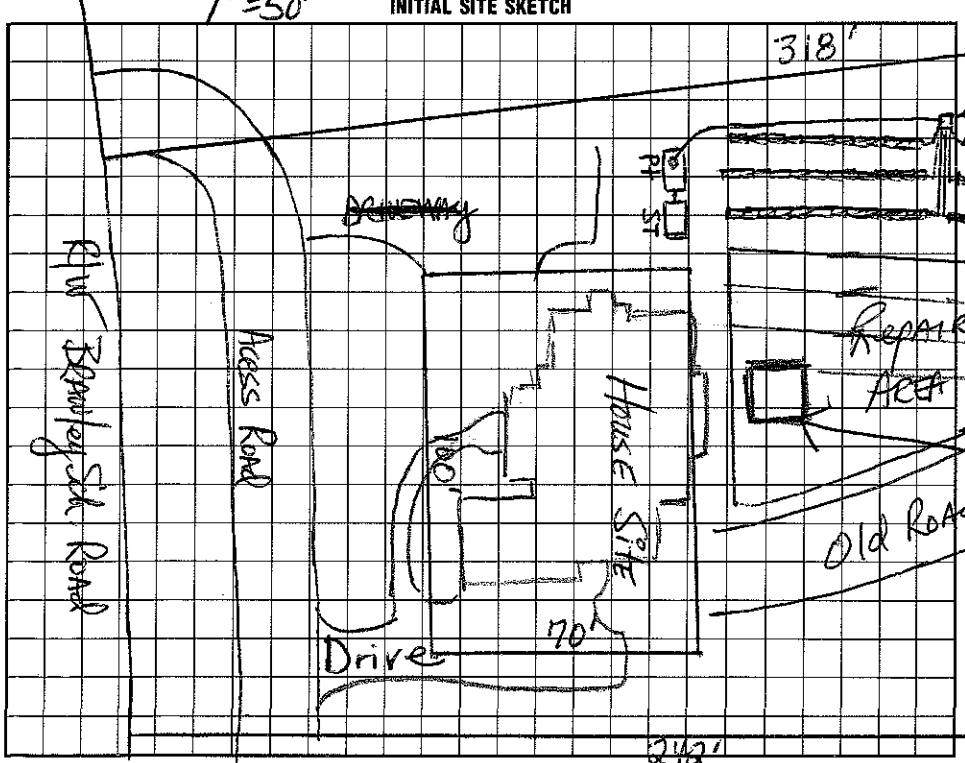

AS BUILT SKETCH

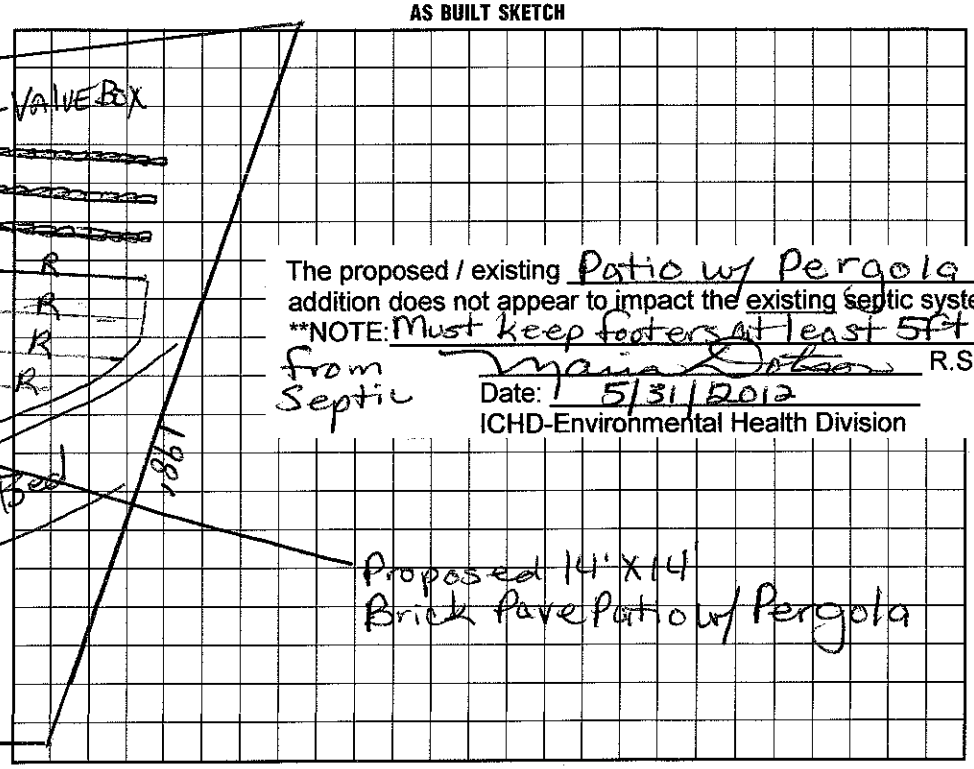

The proposed / existing Patio w/ Pergola addition does not appear to impact the existing septic system.

**NOTE: Must keep footers at least 5ft from Septic

Maria H. Dotson R.S.

Date: 5/31/2012

ICHD-Environmental Health Division

I understand that this permit can be suspended or revoked if any false information is supplied toward securing the permit/any unauthorized changes are made to the site/any unauthorized changes are made in the installation of the system. Improvement Permit with plat valid without expiration. Improvement Permit with site plan valid for sixty months. Authorization to Construct is valid for a period equal to that of Improvement Permit – not to exceed sixty months.

Signed: _____ date 11/17/98

Improvement Permit by: _____ RS date 11-14-98

Authorization to Construct by: _____ RSE date 5/1/01

Installed by: R+I

Operation Permit by: Maria H. Dotson R.S. date 1/17/02

Existing System Inspection by: _____ date _____

HEALTH DEPT. COPY: WHITE INSPECTION COPY (FINAL): GREEN OWNER COPY (FINAL): YELLOW INSPECTION COPY (INITIAL): PINK OWNER COPY (INITIAL): GOLD