3-3:30

IREDELL COUNTY HEALTH DEPARTMENT

STATESVILLE 704-878-5305 MOORESVILLE 704-664-5281

IMPROVEMENT PERMIT / AUTHORIZATION TO CONSTRUCT / OPERATION PERMIT / EXISTING SYSTEM INSPECTI

PERMIT# 074984 PIN# 4625941684 4625-97-9602 DATE Nov. 14, 98

OWNER OR CONTRACTOR Cresent Resources Attn: / Elrod Custom PHONE: Business Homes Home

ADDRESS P.O. Box 1003, Charlotte

LOCATION Brawley School Rd. on left before Quaker Road

SUBDIVISION The Point BLOCK / SECTION 1-C LOT 35 LOT AREA 42,719 ft² SITE CLASS. PS DESIGN FLOW 480gpd L.T.A.R. .03

Septic Tank: ~~1000~~ 1500 Gallons; STB 338 Date 6/10/03

Pump Tank: 1000 Gallons; PT ~~327~~ 327 Date 6/10/03

Pump Make: Gould's Model WE0512H4 Serial No. C0337297

Nitrification Field: No Fields 1 Square Feet 1200 Linear Feet 400

No Lines 3 Trench Width 36" Max Trench Bottom Depth 36"

☑ New System ☐ Repair System Type: I, II, III, IV, V, VI

System Description: Pumped pm-25% Red. Turbinette

Repair System Description: LP-25-50% Reduction

Maintenance Agreement Required: ☐ Yes ☑ No

Gravel Depth N/A ☐ Slab ☑ Crawl Space ☐ Basement w/plumbing ☐ Basement wo/plumbing

☑ House/Mod. Home No. Bedrooms 4

☐ Mobile Home No. Bathrooms 4

☐ Business No. Employees

☐ Other


Water Supply: ☐ Individual ☑ Public ☐ Community

Comments:/Conditions: *ONE INSPECTION PORT PER LATERAL

Comments:/Conditions: Reviewed Building plans & Site plan essentially in Compliance with original permit MD 2/6/03

1"=50'

INITIAL SITE SKETCH

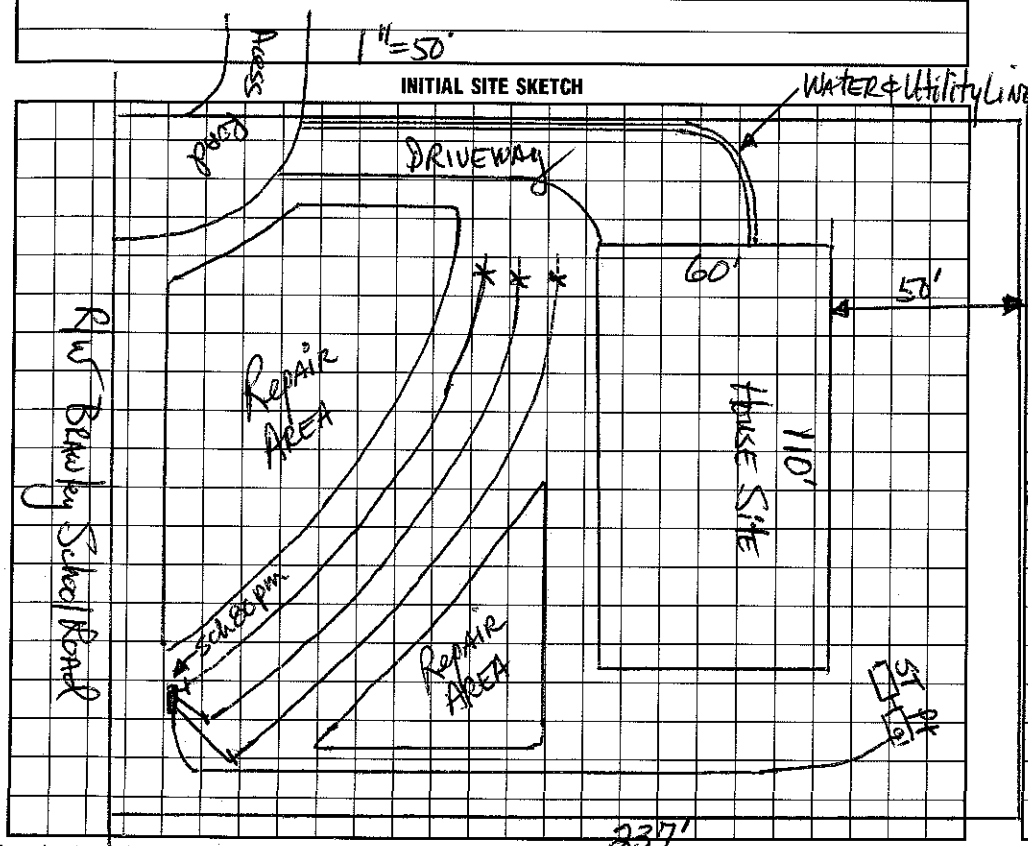

AS BUILT SKETCH

The proposed / existing Pool addition does not appear to impact the existing septic system.

**NOTE:

REHS

Date: 8-4-10

ICHD-Environmental Health Division

I understand that this permit can be suspended or revoked if any false information is supplied toward securing the permit/any unauthorized changes are made to the site/any unauthorized changes are made in the installation of the system. Improvement Permit with plat valid without expiration. Improvement Permit with site plan valid for sixty months. Authorization to Construct is valid for a period equal to that of Improvement Permit – not to exceed sixty months.

Signed: date 11/17/98

Improvement Permit by: date 11-14-98

Authorization to Construct by: RS date 2/6/03

Installed by: Ocbison

Operation Permit by: date 9/23/03

Existing System Inspection by: date

HEALTH DEPT. COPY: WHITE INSPECTION COPY (FINAL): GREEN OWNER COPY (FINAL): YELLOW INSPECTION COPY (INITIAL): PINK OWNER COPY (INITIAL): GOLD