125

IREDELL COUNTY HEALTH DEPARTMENT

STATESVILLE 704-878-5305 MOORESVILLE 704-664-5281

IMPROVEMENT PERMIT / AUTHORIZATION TO CONSTRUCT / OPERATION PERMIT / EXISTING SYSTEM INSPECTION

PERMIT# 079159 / 127223 PIN# 4625842809 (pt.) DIBBLE Const 4625 983921 DATE April 29, '99

OWNER OR CONTRACTOR Crescent Resources, Inc. / The Point at Worsham PHONE: Business 660-1185 Home

ADDRESS 2214 Brawley Sch Rd. Mooresville DIBBLE

LOCATION Brawley Sch Rd. on left past BRAWLEY HARBOR Place

SUBDIVISION The Point BLOCK / SECTION II LOT 238/238A LOT AREA 36,337 sf± 2 38A SITE CLASS. PS DESIGN FLOW 480 appl L.T.A.R. .3

Septic Tank: 1500 F Gallons; STB 338 Date 4/7/05

Pump Tank: 1000 Gallons; PT 27 Date 6/13/05

Pump Make: Goulds Model WE0-512HA Serial No. 5/16/05

Nitrification Field: No Fields 1 Square Feet 1200 Linear Feet 400

No Lines 4@10' Trench Width 36" Max Trench Bottom Depth 36" Gravel Depth N/A

☑ New System ☐ Repair System Type: I, II, III, IV, V, VI

System Description: pm - Innovative 125% Reduction

Repair System Description: LP Panel Block

Maintenance Agreement Required: ☐ Yes ☑ No

☑ House/Mod. Home ☐ Mobile Home ☐ Business ☐ Other

No. Bedrooms 4 No. Bathrooms 4 No. Employees


☐ Slab ☑ Crawl Space ☐ Basement w/plumbing ☐ Basement wo/plumbing

Water Supply: ☐ Individual ☒ Public ☑ Community

Comments:/Conditions: * ONE INSPECTION PORT PER LATERAL

Comments:/Conditions:

INITIAL SITE SKETCH 1" = 100'

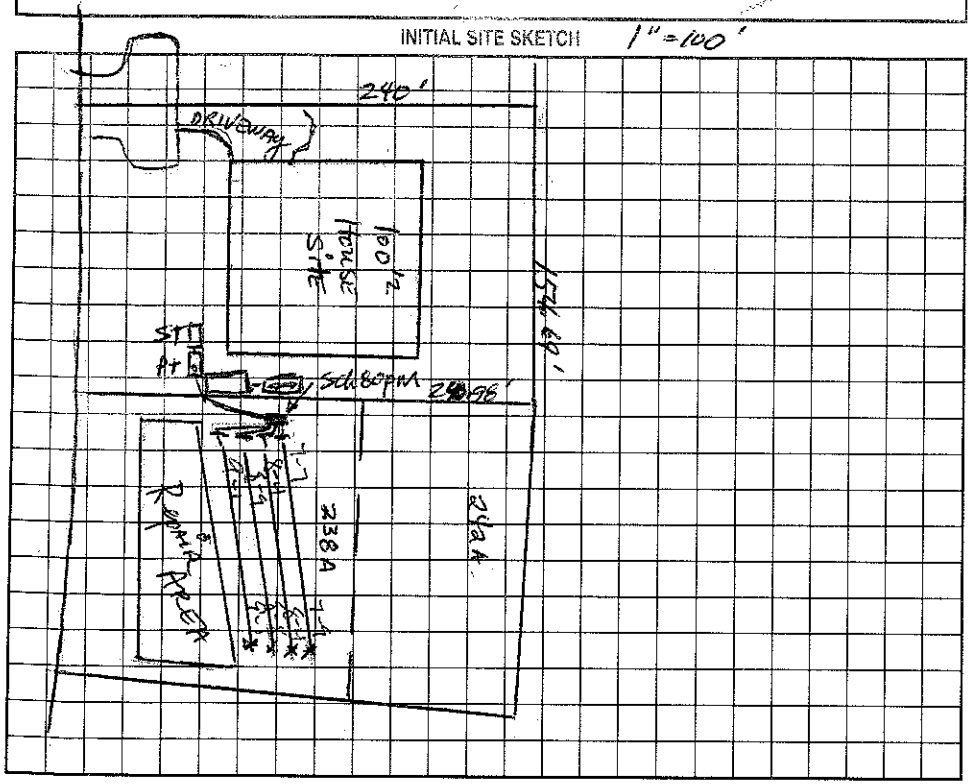

AS BUILT SKETCH

Permit can be suspended or revoked if any false information is supplied toward securing the permit/any unauthorized changes are made to the site/any unauthorized changes are made in the installation of the system. Improvement Permit with plat valid without expiration. Improvement Permit with site plan valid for sixty months. Authorization to Construct is valid for a period equal to that of Improvement Permit – not to exceed sixty months.

Signed: [signature] date 1/30/99 Installed by: Ordonez Sons

Improvement Permit by: [signature] RS date 4-29-99 Operation Permit by: [signature] RS date 10/24/05

Authorization to Construct by: [signature] RS. date 3/1/05 Existing System Inspection by: date

HEALTH DEPT. COPY: WHITE OWNER COPY (FINAL): YELLOW OWNER COPY (INITIAL): PINK