...NT HEALTH DEPARTMENT

STATESVILLE 704-878-5305 | MOORESVILLE 704-664-5281

...ENT PERMIT / AUTHORIZATION TO CONSTRUCT / OPERATION PERMIT / EXISTING SYSTEM INSPECTION

PERMIT# 078153 | PIN# 4625584280? (Lot) | 4625-98-8321

OWNER OR CONTRACTOR Crescent Resources dba / The Point on Norman / Dieck | PHONE: Business | Home | DATE March 15, '99

ADDRESS 2214 Brawley Sch Rd. / Mooresville, N.C. | Custom Homes

LOCATION Brawley Sch Rd. on left past Bay Harbour Rd

SUBDIVISION The Point | BLOCK / SECTION II | LOT 233 | LOT AREA 72,035 Sq | SITE CLASS PS | DESIGN FLOW 480gpd | L.T.A.R. .25-.3

Septic Tank: 1000 Gallons; STB 5-16-03 Date 338

Pump Tank: 1000 Gallons; PT 4-19-03 Date PT27

Pump Make: Myers Model ME50 Serial No.

Nitrification Field: No. Fields 1 Square Feet 900 Linear Feet 300

No. Lines 3@100 Trench Width 36" Max Trench Bottom Depth 36" Gravel Depth NA

☑ New System ☐ Repair System Type: I, II, III, IV, V, VI

System Description: LPP Panel Block

Repair System Description: LPP Panel Blk, LPP

Maintenance Agreement Required: ☑ Yes ☐ No

☐ Slab ☑ Crawl Space ☐ Basement w/plumbing ☐ Basement wo/plumbing

☑ House/Mod. Home ☐ Mobile Home ☐ Business ☐ Other

No. Bedrooms 4 No. Bathrooms 4 No. Employees

Water Supply: ☐ Individual ☑ Public ☑ Community


Comments/Conditions: Reviewed Building plans & site plan is essentially in Compliance with permit. MB

Comments/Conditions: Tanks Checked 6/26/03 Upper 2 lines Checked 8/21/03 Lower line 8/22/03 Pres, Elect & Alarm 9/15/03

1"=50' INITIAL SITE SKETCH



AS BUILT SKETCH

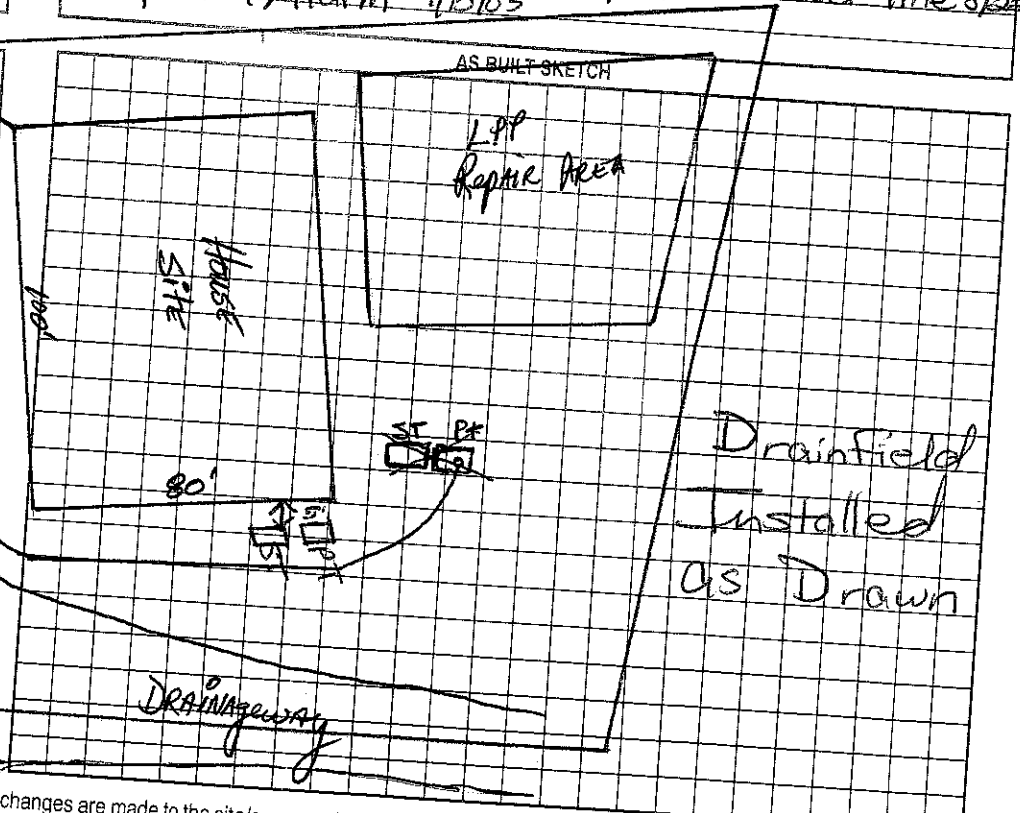

Permit can be suspended or revoked if any false information is supplied toward securing the permit/any unauthorized changes are made to the site/any unauthorized changes are made in the installation of the system. Improvement Permit with plat valid without expiration. Improvement Permit with site plan valid for sixty months. Authorization to Construct is valid for a period equal to that of Improvement Permit – not to exceed sixty months.

Signed:

Improvement Permit by: [signature] date 3/24/99

Authorization to Construct by: [signature] RS date 3-15-99

Installed by: R&H Inc

Operation Permit by:

Existing System Inspection by: [signature] RS date 9/15/2003

HEALTH DEPT. COPY: WHITE OWNER COPY (FINAL): YELLOW