IREDELL COUNTY HEALTH DEPARTMENT

Statesville Office (704) 878-5305 | Mooresville Office (704) 660-3625 | PERMIT # 212333

IMPROVEMENT PERMIT / AUTHORIZATION TO CONSTRUCT / OPERATION PERMIT / EXISTING SYSTEM

PIN # 4625-98-8321.000

APPLICANT: Charlotte Pools & Spa | APPLICANT ADDRESS: 158 Brawley Rd. Mooresville NC

SITE ADDRESS: 1753 Brawley School Rd. Mooresville, NC | PHONE: 704-799-7547 | ALT. PHONE:


SITE DIRECTIONS: I-77 to Point, Site on L

SUBDIVISION: The Point at Norman | SECTION: 2 | LOT # 233 | LOT AREA: 1.654 Acre | DESIGN FLOW: Ex. 480 GPD | L.T.A.R.: Existing


Septic Tank: Existing (gal)	STB	Date	☐ New System ☐ Repair ☐ Expansion System Type: I II III IV V VI	☒ Residence	No. Bedrooms: Ex. 4	Water Supply
Pump Tank: Existing (gal)	PT	Date	System Description: Existing LP-PPBS	☐ Business	No. Persons: Ex. 8	☐ Private
Pump Make: Existing	Model	Serial #	Repair System Description: LP-PPBS, Drip	☐ Other	No. Employees	☐ Public
# Nitrification Fields: Ex.	# Lines: Existing	Linear Ft: Existing	Maintenance Agreement Required: ☒ YES ☐ NO	☐ Slab	☐ Crawl Space	☒ Community
Trench Width: Ex.	Max. Trench Bottom Depth: Ex.	Gravel Depth: Ex.	☐ GRAVITY ☒ PRESSURE	☒ Basement w/plumbing	☐ Basement w/o plumbing	

Comments / Conditions: Maintain 15' from Tanks & Repair Area w/ Proposed Pool. System Appeared To Be Functioning @ Time of Inspection.

INITIAL SITE SKETCH

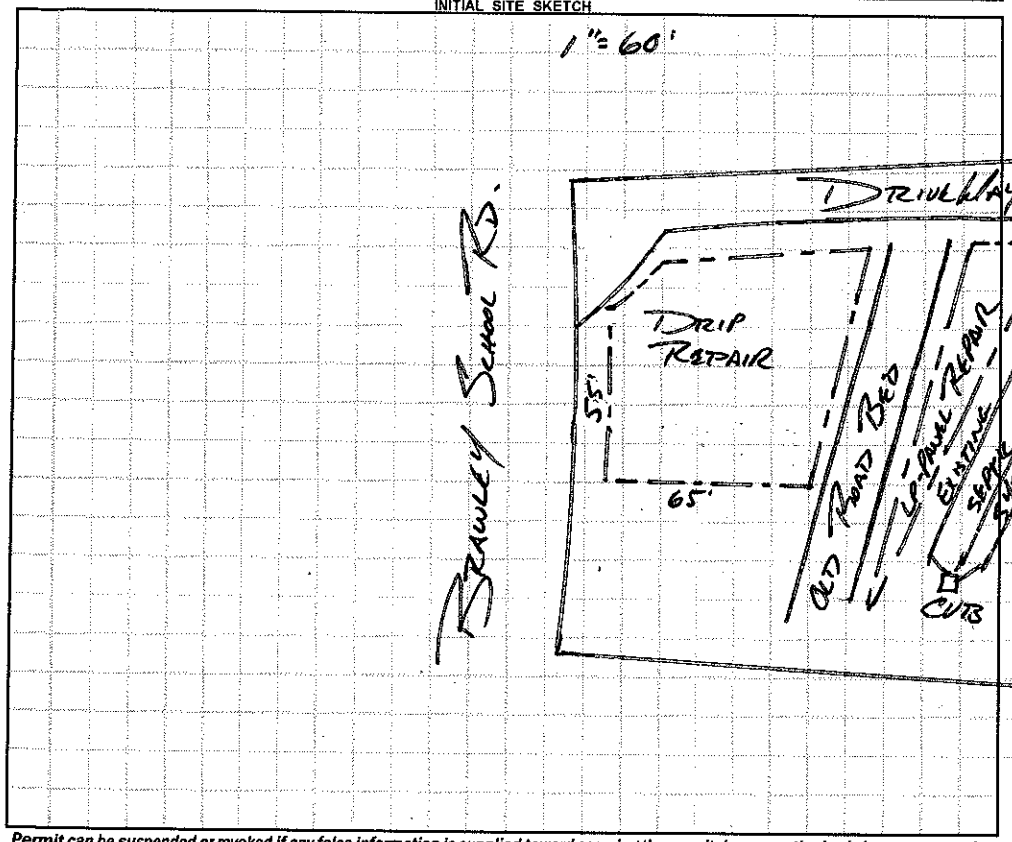

AS BUILT SKETCH

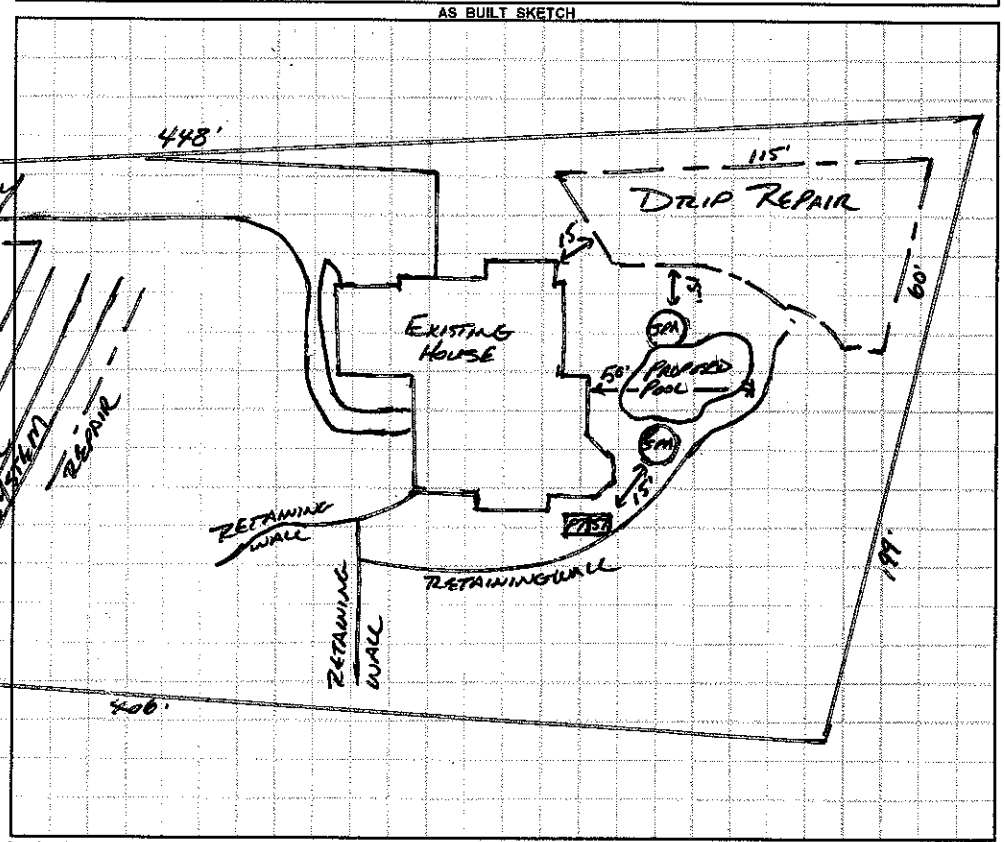

Permit can be suspended or revoked if any false information is supplied toward securing the permit / any unauthorized changes are made to the site / any unauthorized changes are made in the installation of the system. **CONTACT A LOCATOR SERVICE PRIOR TO ANY EXCAVATION**

☐ **IMPROVEMENT PERMIT** *with plat valid without expiration.* ☐ **IMPROVEMENT PERMIT** *with site plan valid for 60 mos.* ☐ **AUTHORIZATION TO CONSTRUCT** *valid for period equal to IMPROVEMENT PERMIT--not to exceed 60 mo.*

Owner / Applicant Signature: Allena Pym | Date: 11-10-15 | Installed by:

IMPROVEMENT PERMIT by: | Date: | OPERATION PERMIT by: | Date:

AUTHORIZATION TO CONSTRUCT by: | Date: | Existing System Inspected by:

APPROVED NOV 03 2015

Health Dept. Copy - WHITE Applicant (Final Approval) - YELLOW Applicant (Conditional Approval) - PINK