IREDELL COUNTY HEALTH DEPARTMENT

Statesville Office (704) 878-5305 Mooresville Office (704) 660-3625 PERMIT # 219462

IMPROVEMENT PERMIT / AUTHORIZATION TO CONSTRUCT / OPERATION PERMIT / EXISTING SYSTEM

PIN # 4625-99-2005

APPLICANT: Travis Walk APPLICANT ADDRESS: P.O. Box 1596 Cornelius, NC

SITE ADDRESS: 1709 Brawley School Rd. Mooresville, NC 28117 PHONE: 704-333-8999 ALT. PHONE: Jonny Cathcart (site supervisor) 704-622-2165

SITE DIRECTIONS: BSR towards Lake Norman → On left after rotary

SUBDIVISION: The Point ON NORMAN SECTION: PH II LOT # 239 LOT AREA: 1.234 acres DESIGN FLOW: 480 gpd L.T.A.R.: Existing

Septic Tank 1000 Ex (gal) STB 338 Ex Date 6-26-05 (Ex)
Pump Tank 1000 Ex (gal) PT 27 Ex Date 7-4-05 (Ex)
Pump Make Goulds Ex Model WE0312ITTC (Ex) Serial # Ex
Nitrification Fields 1 # Lines 7 Linear Ft: 350
Trench Width 36" Max. Trench Bottom Depth 36" Gravel Depth —

☐ New System ☐ Repair ☐ Expansion System Type: I II III (IV) V VI
System Description: Existing - LPPPBPS 50% Reduction
Repair System Description: Existing - same
Maintenance Agreement Required: ☒ YES ☐ NO
☐ GRAVITY ☒ PRESSURE

☒ Residence No. Bedrooms 4
☐ Business No. Persons 8
☐ Other No. Employees
☒ Slab ☐ Crawl Space
☐ Basement w/plumbing ☐ Basement w/o plumbing

Water Supply: ☐ Private ☒ Public ☒ Community

Comments / Conditions: Approval for a 12' x 12' building addition (patio/porch) on rear of house as depicted on attached plans.

INITIAL SITE SKETCH

See attached plans from Thompson Environmental Consulting. Dated: 6-20-2016
Larry B. Thompson LSS # 1287

AS BUILT SKETCH

Permit can be suspended or revoked if any false information is supplied toward securing the permit / any unauthorized changes are made to the site / any unauthorized changes are made in the installation of the system. **CONTACT A LOCATOR SERVICE PRIOR TO ANY EXCAVATION**

☐ **IMPROVEMENT PERMIT** ***with plat*** *valid without expiration.* ☐ **IMPROVEMENT PERMIT** ***with site plan*** *valid for 60 mos.* ☐ **AUTHORIZATION TO CONSTRUCT** *valid for period equal to IMPROVEMENT PERMIT--not to exceed 60 mo.*

Owner / Applicant Signature: _____ Date: 6-29-16 Installed by: _____

IMPROVEMENT PERMIT by: _____ Date: _____ OPERATION PERMIT by: _____ Date: _____


AUTHORIZATION TO CONSTRUCT by: _____ Date: _____ Existing System Inspected by: Sam Shuck Date: 6-28-16

Health Dept. Copy - WHITE Applicant (Final Approval) - YELLOW Applicant (Conditional Approval) - PINK

* Approximate extents of existing septic system. This is not a survey.

The Point
Sect. II Lot 239
1709 Brawley School Road

Scale: 1" = 40'

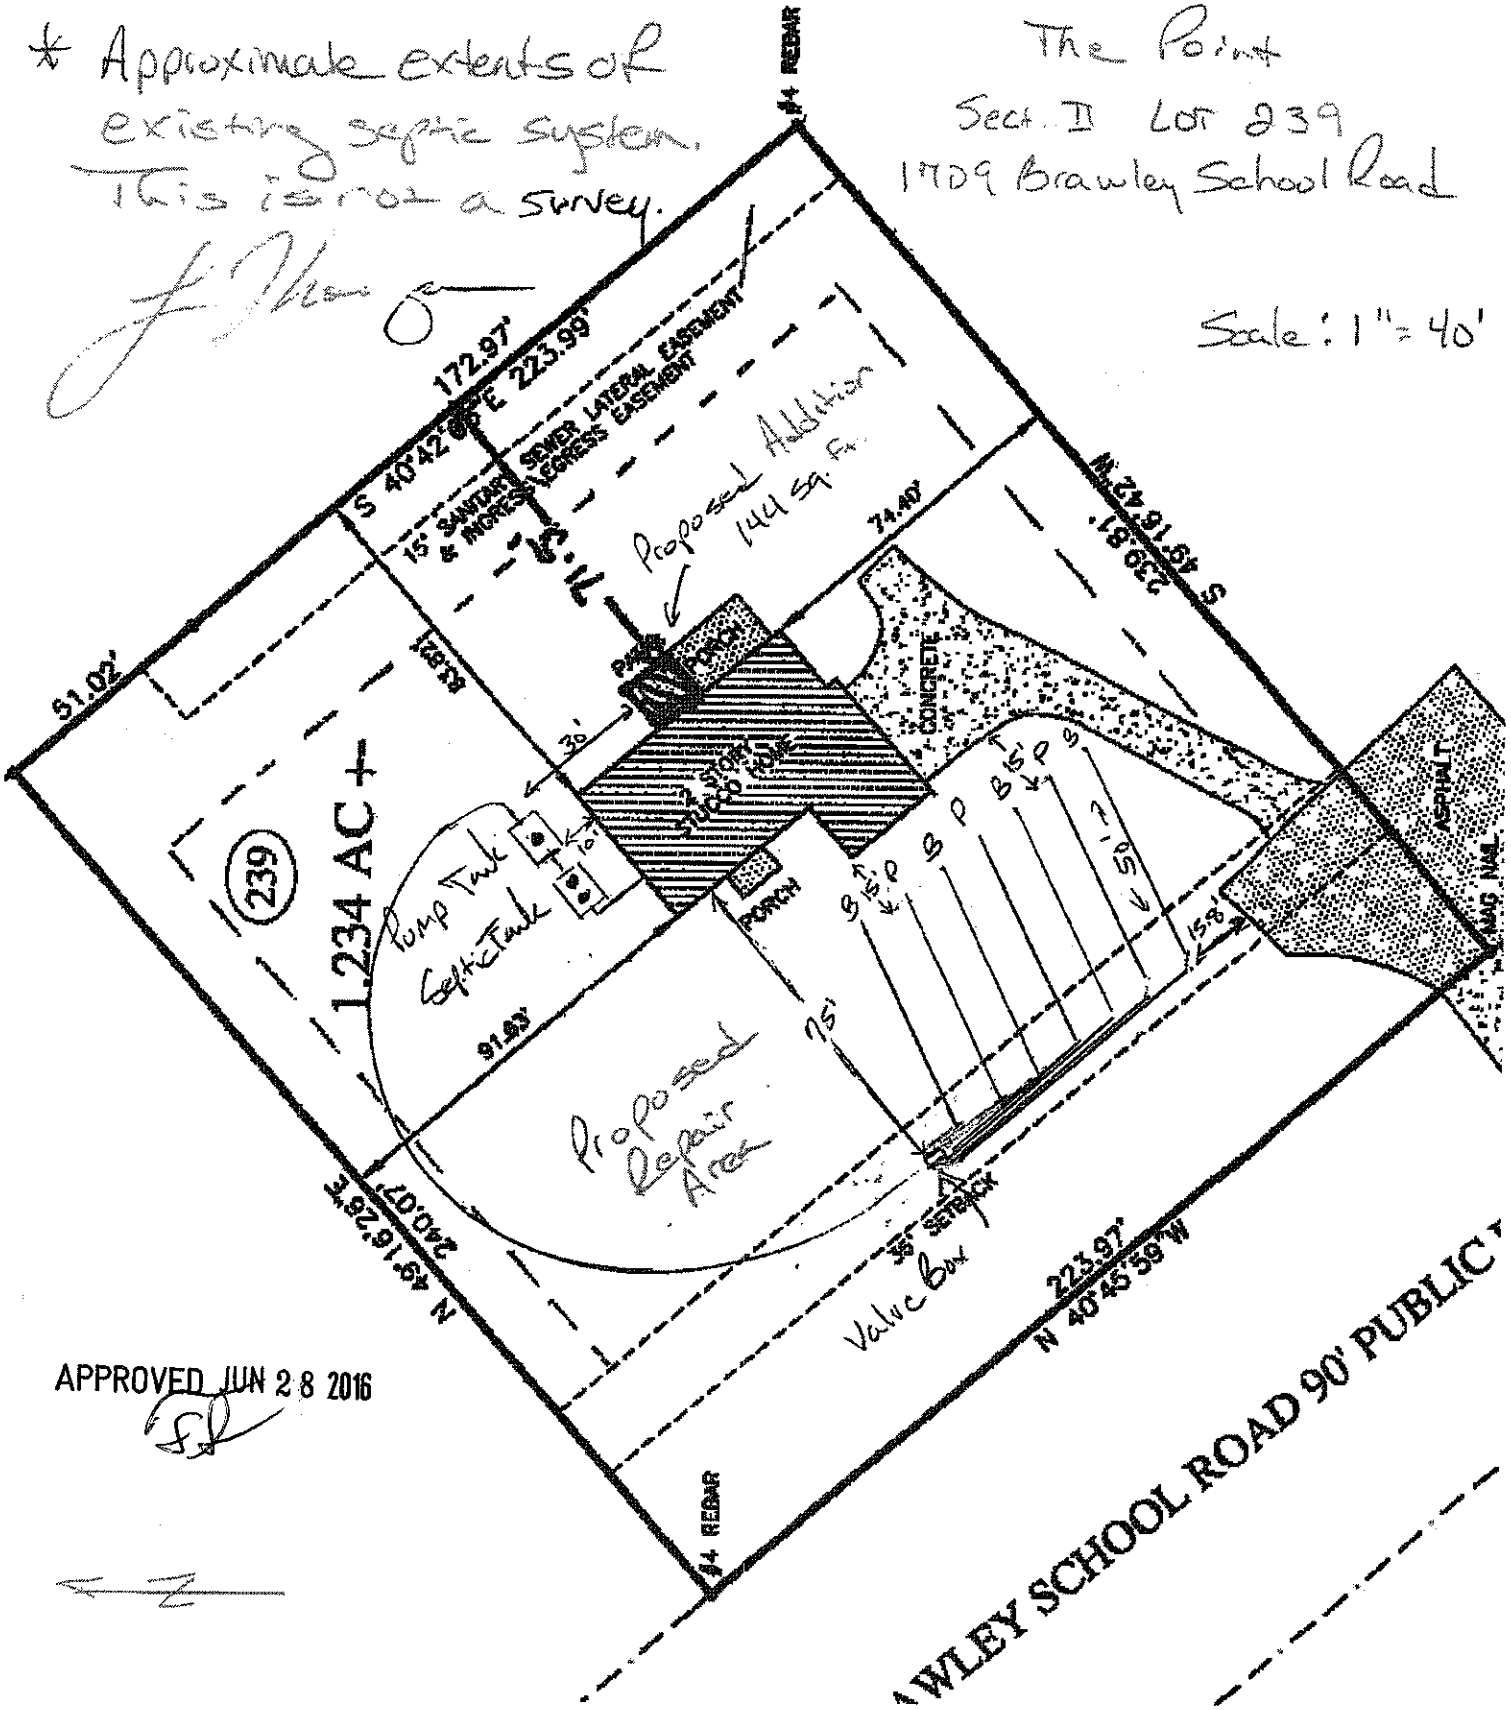

APPROVED JUN 28 2016