COUNTY HEALTH DEPARTMENT

Paid 50.00 2:00

STATESVILLE 704-878-5305 MOORESVILLE 704-664-5281

...VEMENT PERMIT / AUTHORIZATION TO CONSTRUCT / OPERATION PERMIT / EXISTING SYSTEM INSPECTION

...MIT# 078166 PIN# 4625 84 2807 PF. 4625-99-2390 DATE 11/29/00

OWNER OR CONTRACTOR Demonaini Bldrs. PHONE: Business 358-9540 Home

ADDRESS 817 E Morehead St. Charlotte NC.

LOCATION 1100 TL Brawley Harbor on (R) of Cliff Rd.

SUBDIVISION Pointe BLOCK / SECTION 2 LOT 242-242A LOT AREA 39,000 FT² SITE CLASS. PS DESIGN FLOW 480 L.T.A.R. .25

Septic Tank: 1500 Gallons; STB 338 Date 11-8-00

Pump Tank: Gallons; PT Date

Pump Make: Model Serial No.

Nitrification Field: No Fields 1 Square Feet 1200 Linear Feet 600

No Lines 5+5 @60' Trench Width 3' Max Trench Bottom Depth 3' Gravel Depth SAND.

[X] New System [ ] Repair System Type: I, II, [III], IV, V, VI

System Description: Ch. PLASTIC GRAVITY

Repair System Description: 242A - renovation

Maintenance Agreement Required: [X] Yes [ ] No

[X] House/Mod. Home No. Bedrooms 4

[ ] Mobile Home No. Bathrooms 4

[ ] Business No. Employees

[ ] Other


[ ] Slab [ ] Crawl Space [ ] Basement w/plumbing [ ] Basement wo/plumbing

Water Supply: [ ] Individual [ ] Public [X] Community


Comments:/Conditions:

Comments:/Conditions: Checked tanks & Drainfield (1) ~~& 3 lines of~~ (2)

INITIAL SITE SKETCH

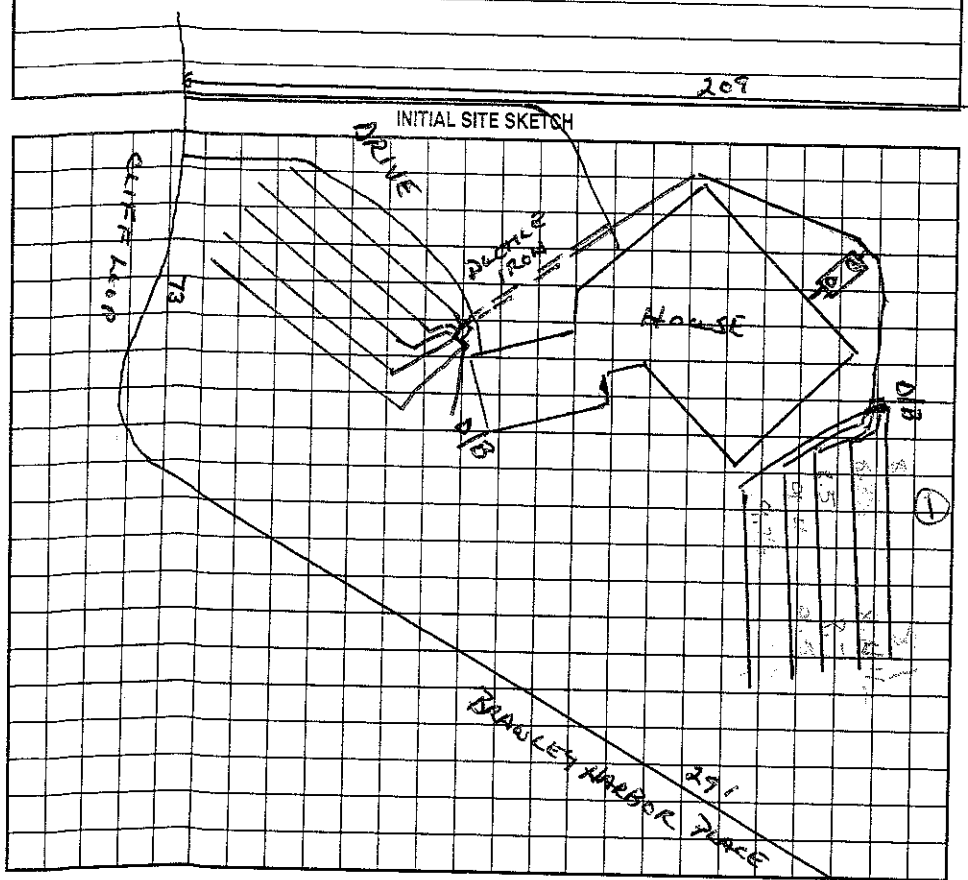

AS BUILT SKETCH

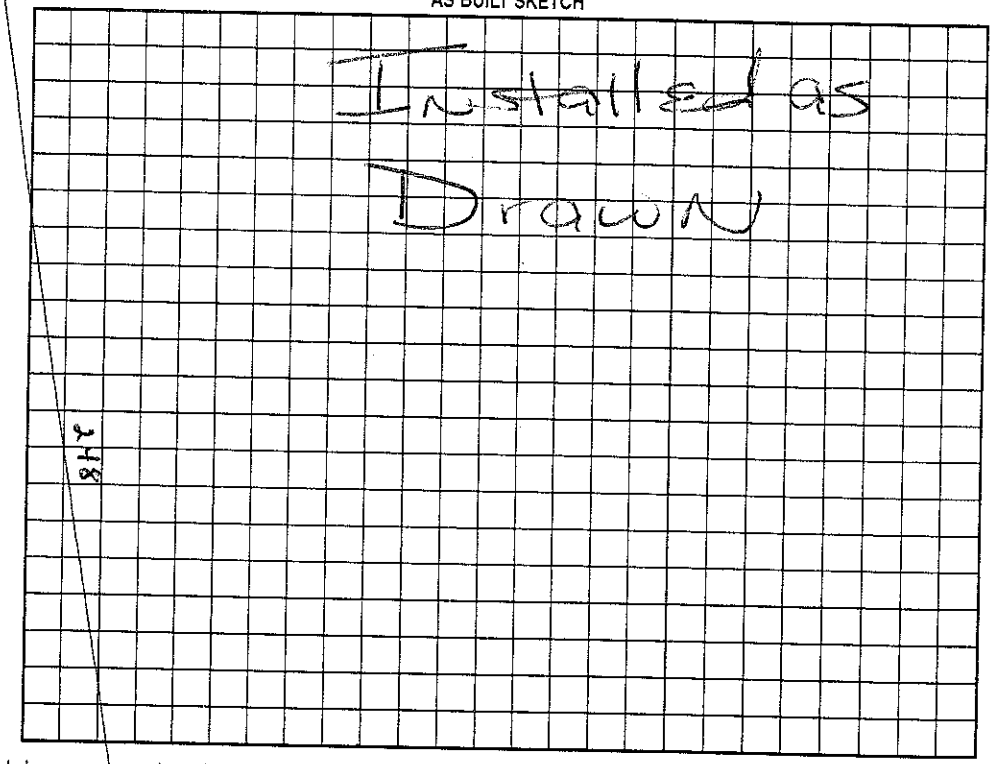

Permit can be suspended or revoked if any false information is supplied toward securing the permit/any unauthorized changes are made to the site/any unauthorized changes are made in the installation of the system. Improvem... Permit with plat valid without expiration. Improvement Permit with site plan valid for sixty months. Authorization to Construct is valid for a period equal to that of Improvement Permit – not to exceed sixty months.

Signed: * date 12/1/00

Improvement Permit by: Wesley Sparks R.S. date 11/29/00

Authorization to Construct by: Wesley Sparks R.S. date 11/29/00

Installed by: R & H Inc.

Operation Permit by: Maria H. Watson RS

Existing System Inspection by:

HEALTH DEPT. COPY: WHITE OWNER COPY (FINAL): YELLOW OWNER COPY (INITIAL): PINK